


## TYPICAL SECTIONS KENYON ROAD - JOHNNIE BROOK ROAD


MATERIAL ITEM	THICKNESS TOLERANCE
PAVEMENT COURSES (TOTAL DEPTH)	± 1/4"
SUBBASE	± 1"

3" WEARING COURSE, SUPERPAVE BITUMINOUS CONCRETE PAVEMENT (PG 58-<sup>28</sup>34), 1/2" TYPE IIIS, 1/2" TYPE IIIS  
24" SUBBASE OF DENSE GRADED CRUSHED STONE

EMULSIFIED ASPHALT SHALL BE APPLIED ON ALL EXISTING PAVEMENT SURFACES, BETWEEN ALL COURSES OF PAVEMENT AND ON COLD PLANED SURFACES AT THE RATE OF 0.025 GAL/SY OR AS DIRECTED BY THE RESIDENT ENGINEER.

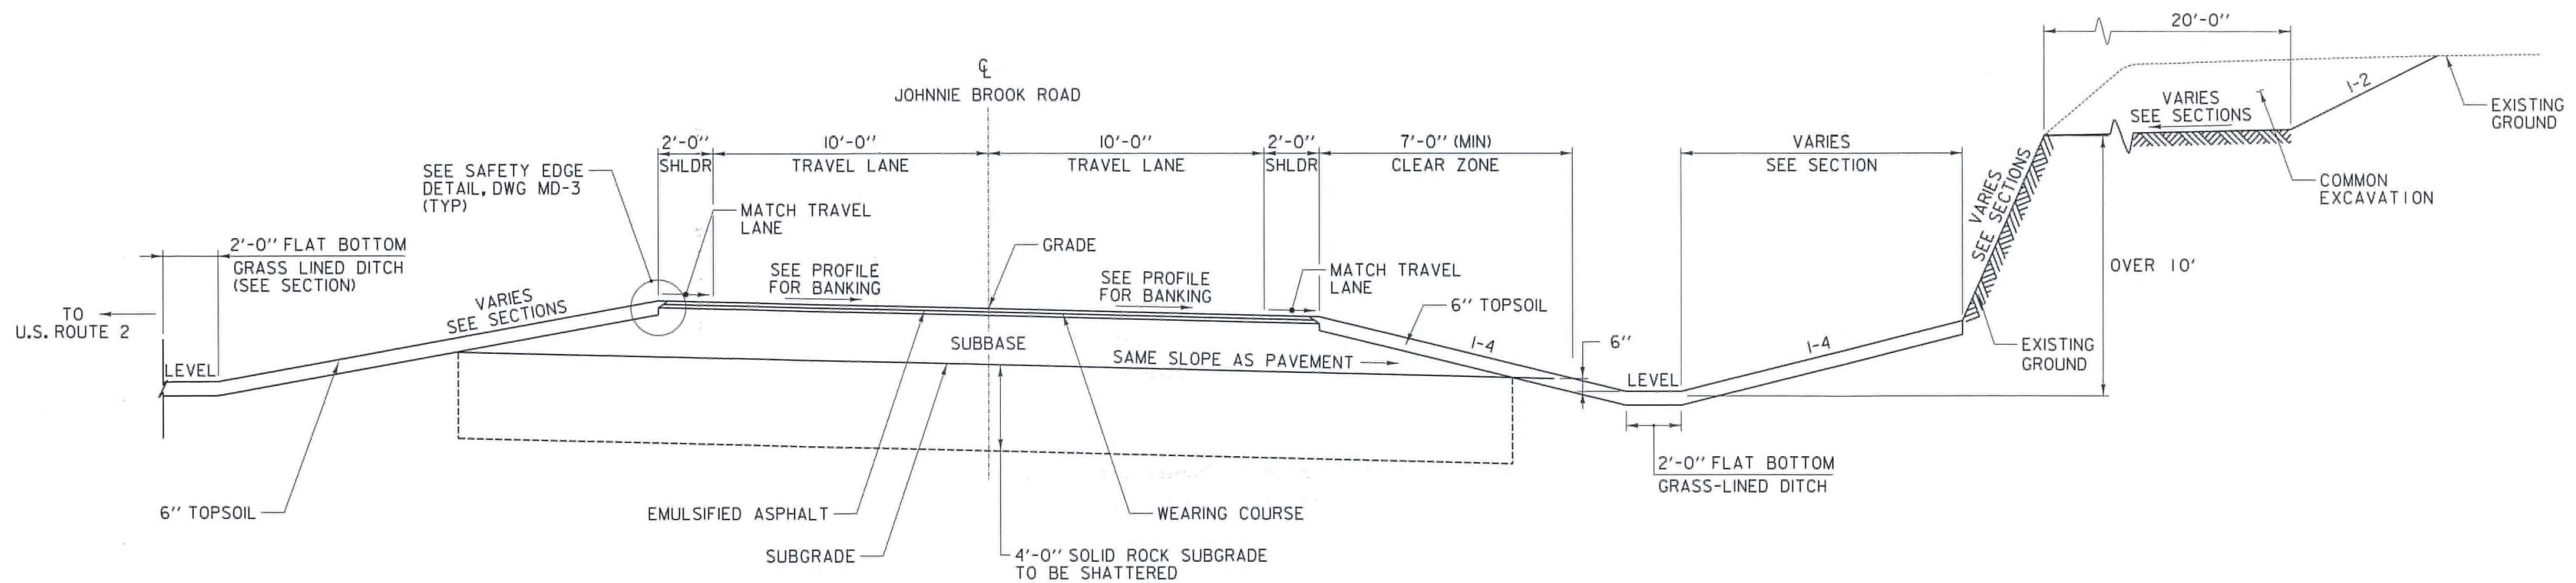

**JOHNNIE BROOK ROAD TYPICAL SECTION**  
STA JB 120+75.00 TO STA JB 123+75.00

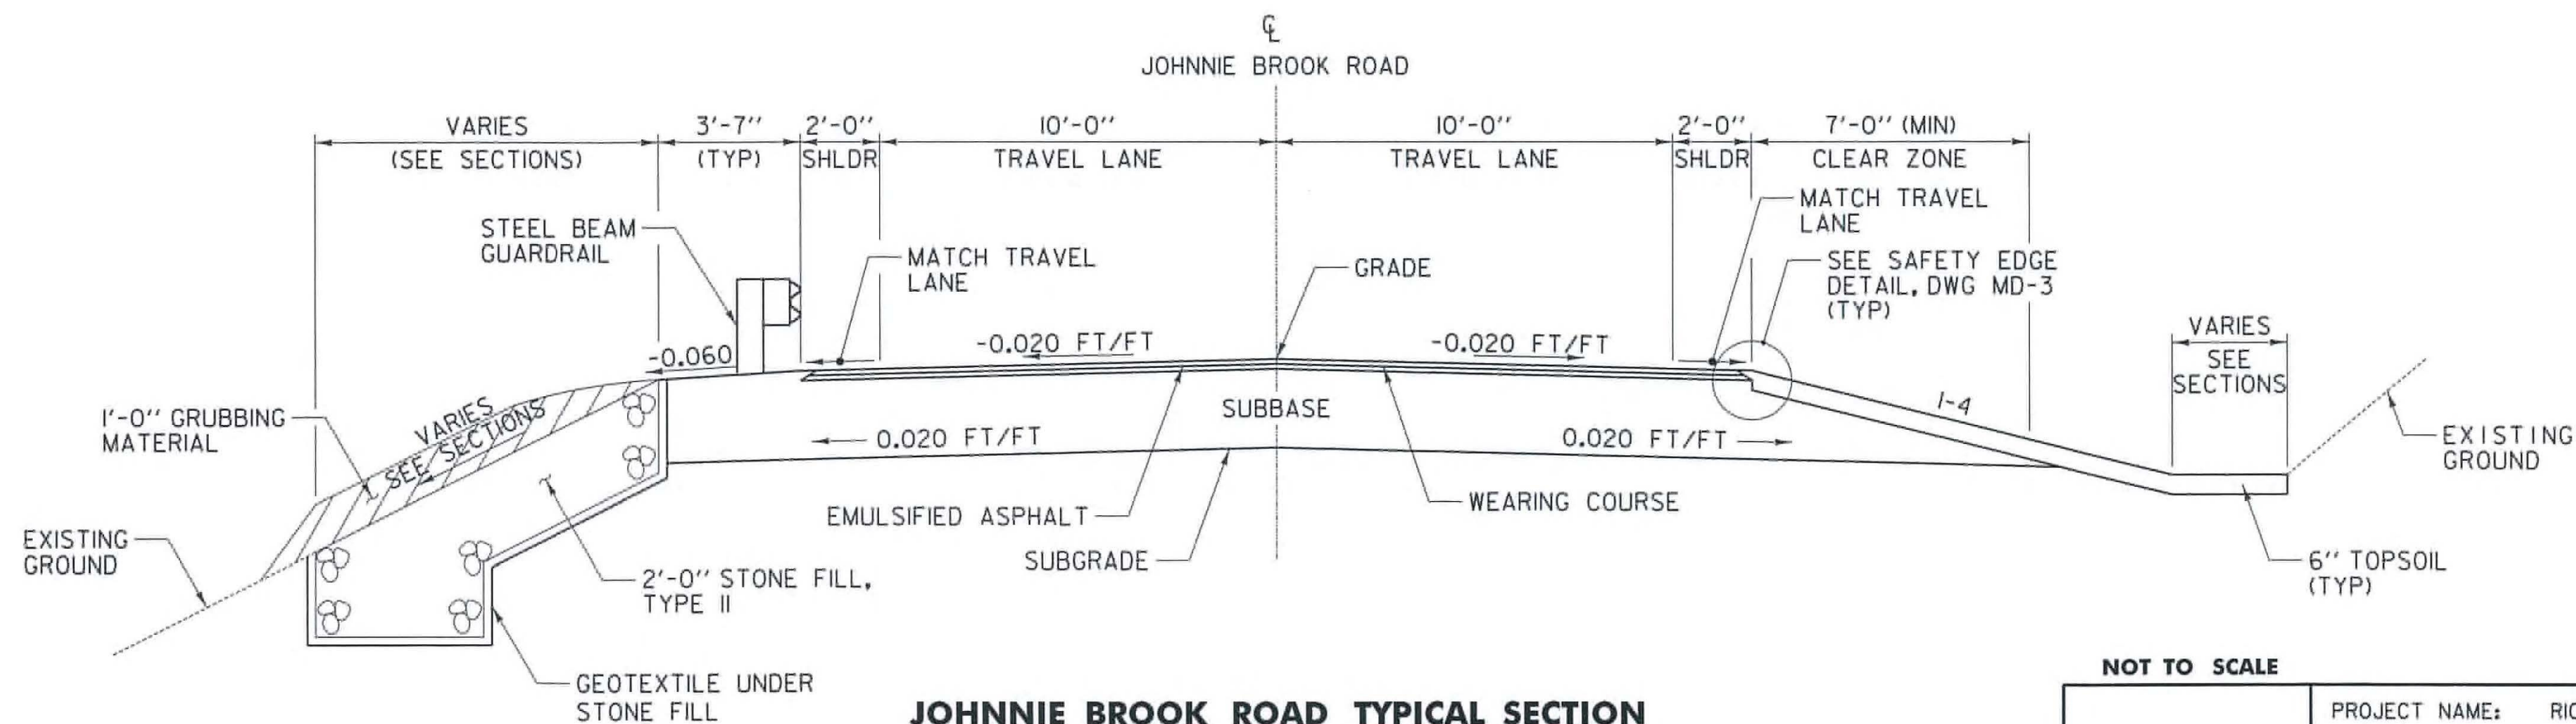

**JOHNNIE BROOK ROAD TYPICAL SECTION**  
STA JB 123+75.00 TO STA JB 126+50.00

X Reviewed	— Furnish As Corrected
Rejected	— Revise and Resubmit

This review is only the general conformity with the design concept and the information given in the Construction Documents. Corrections or omissions made on the shop drawings during the review do not relieve the Contractor from compliance with the requirements of the Plans and Specifications. Review of a specific item shall not include review of an assembly of which it is a component. The Contractor is responsible for dimensions to be confirmed and controlled at the job site, information that pertains solely to the fabrication process or to the means, methods, techniques, sequences and procedures of construction, coordination of the Work with that of other trades and performing all Work in a safe and sanitary manner.

McFarland Johnson  
J. Santacruz

NOT TO SCALE

**TYPICAL SECTION SHEET #3**

PROJECT NAME: RICHMOND  
PROJECT NUMBER: STP-RS 0284(II)  
FILE NAME: z90c092\_TYP\_14.dgn  
PROJECT LEADER: D.E.G.  
DESIGNED BY: B.T.H.  
DWG. NO.: TS-3

PLOT DATE: 8/25/2011  
DRAWN BY: C.A.K.  
CHECKED BY: D.E.G.  
SHEET 4 OF 46