
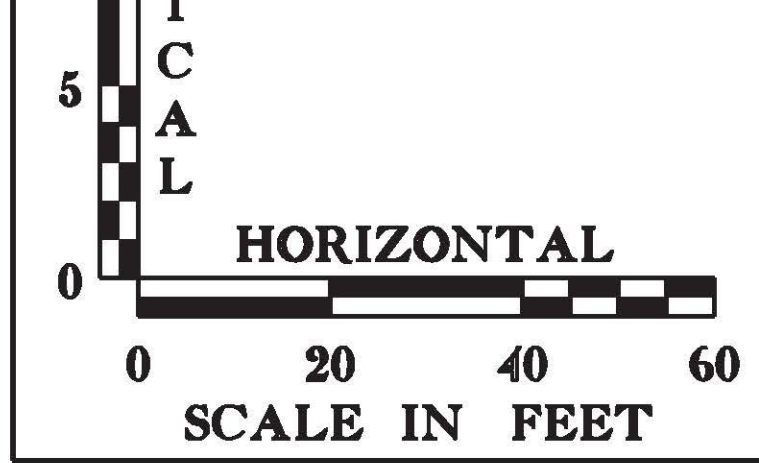


FILE NAME = v:\projects\enr\22276\cadd\mstr\subs (1-14)\roadway design\210c092.prc.02.14.dgn
 DATE/TIME = 8/25/2011
 USER = 3086

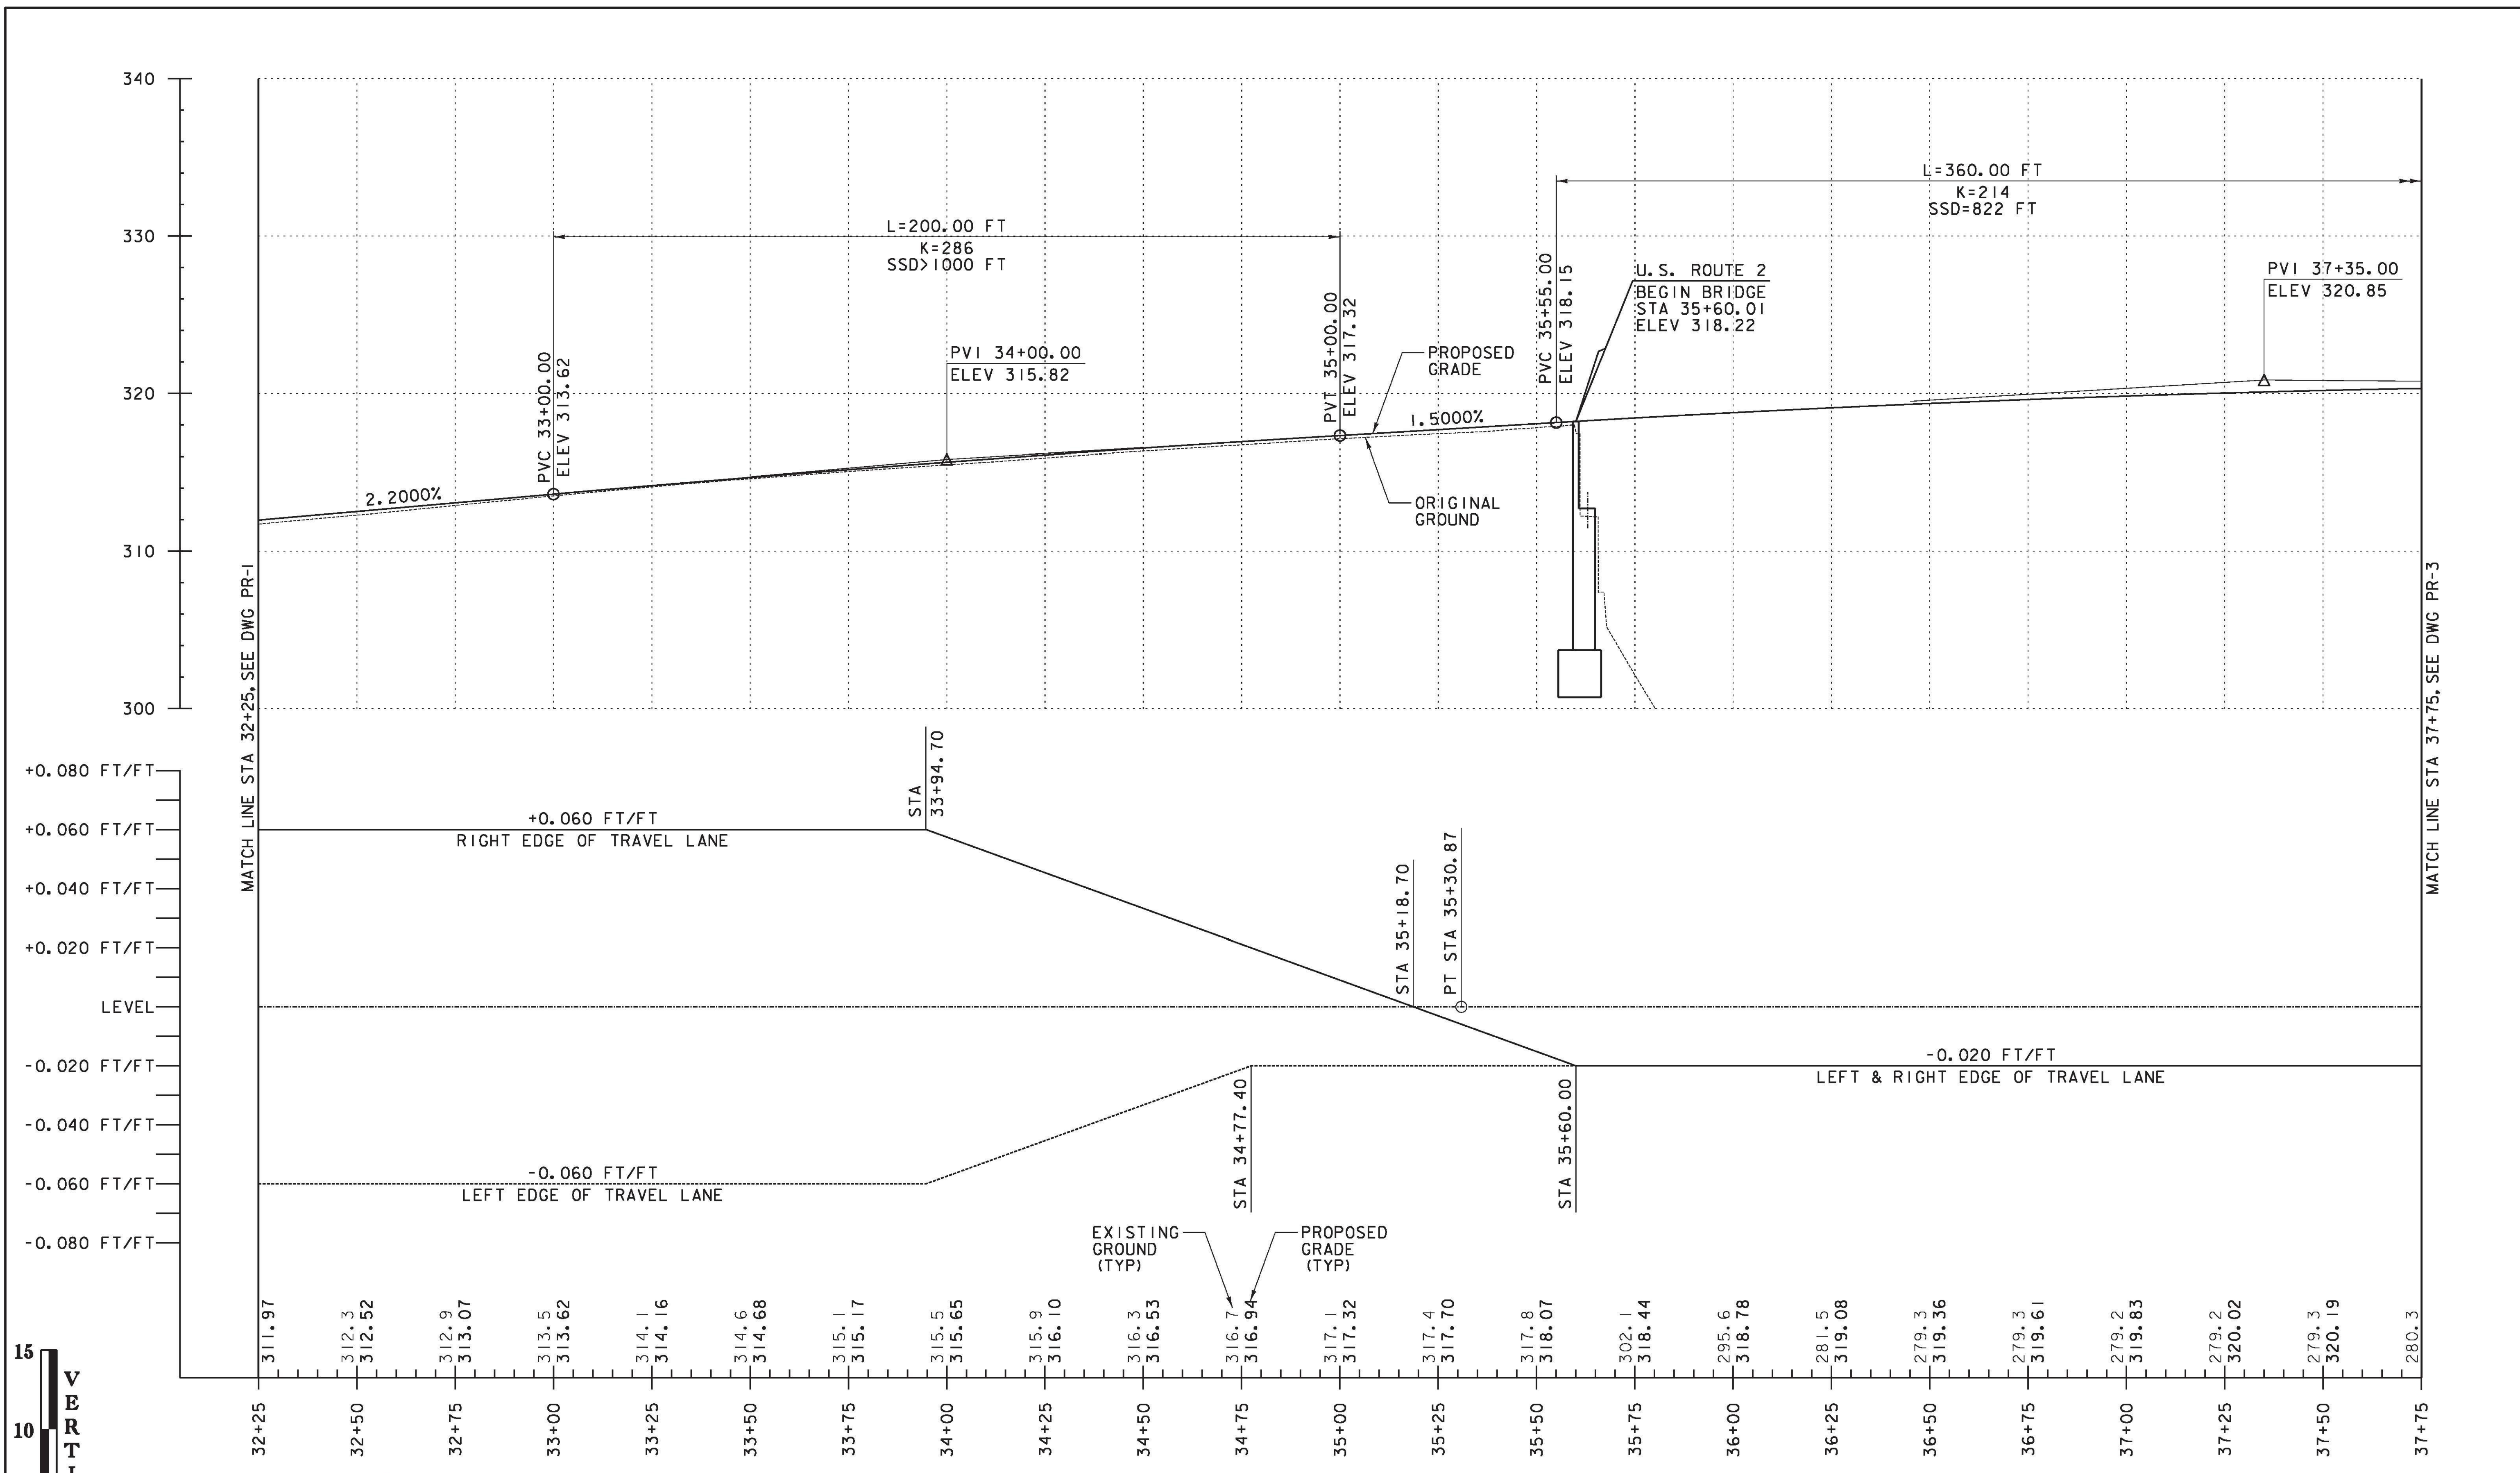

X Reviewed	Furnish As Corrected
Rejected	Revise and Resubmit

This review is only for general conformance with the design concept and the information given in the Construction Documents. Corrections or comments made on the shop drawings during the review do not relieve the Contractor from compliance with the requirements of the Plans and Specifications. Review of a specific item shall not include review of an assembly of which it is a component. The Contractor is responsible for dimensions to be confirmed and corrected at the job site, information that pertains solely to the fabrication process or to the means, methods, techniques, sequences and procedures of construction, coordination of the Work with that of other trades and performing all Work in a safe and satisfactory manner.

Date: August 31, 2011
 By: J. Santacrose

U.S. ROUTE 2

U.S. ROUTE 2 PROFILE

PROJECT NAME: RICHMOND	PROJECT NUMBER: STP-RS 0284(III)
FILE NAME:	PLOT DATE: 8/25/2011
PROJECT LEADER: D.E.G.	DRAWN BY: C.A.K.
DESIGNED BY: B.T.H.	CHECKED BY: D.E.G.
DWG. NO.: PR-2	SHEET 13 OF 46