

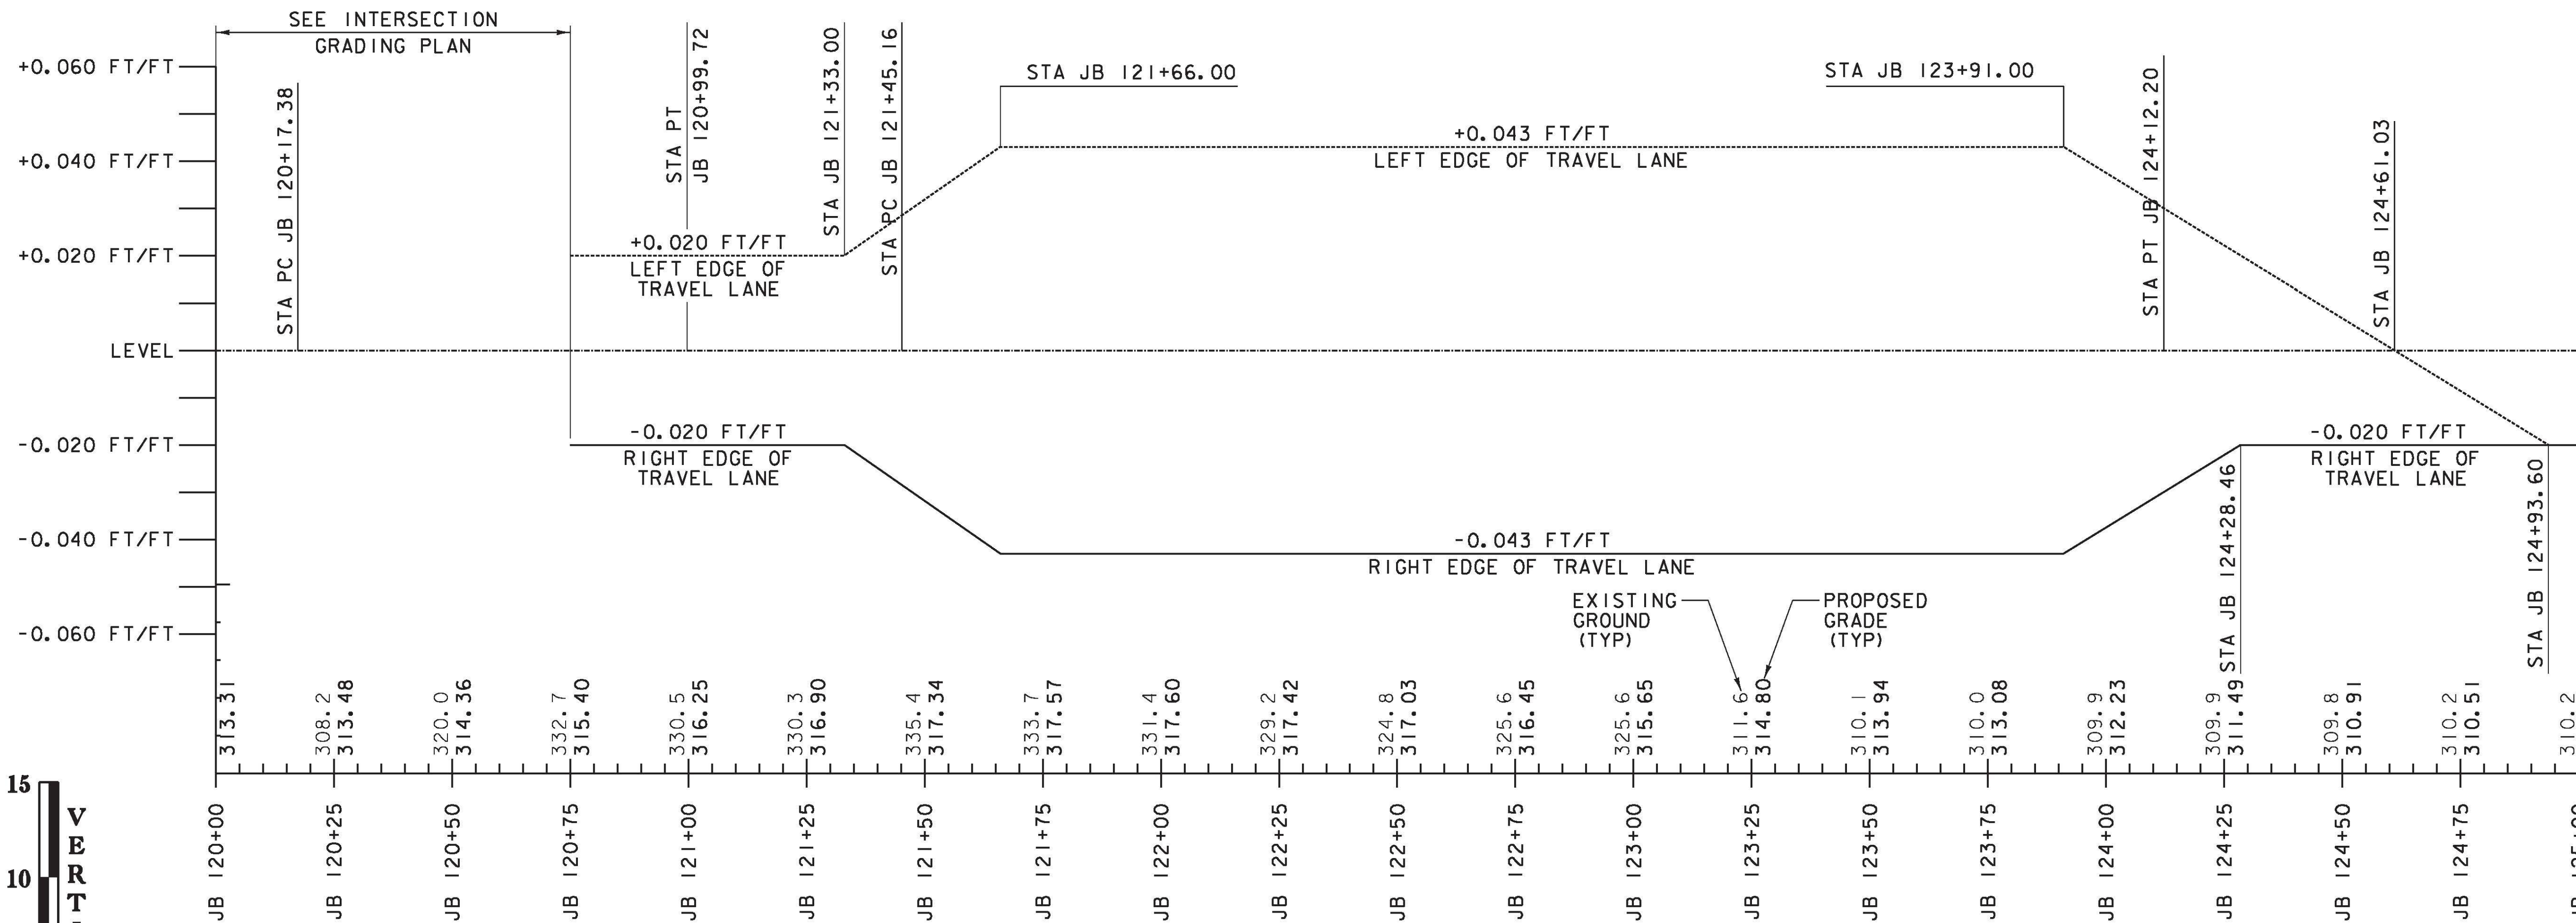


FILE NAME = V:\P\Projects\2011\22076\CADD\1-141 ROADWAY DESIGN\10-0912.prp.06.14.dgn
 DATE/TIME = 8/25/2011
 USER = 3086

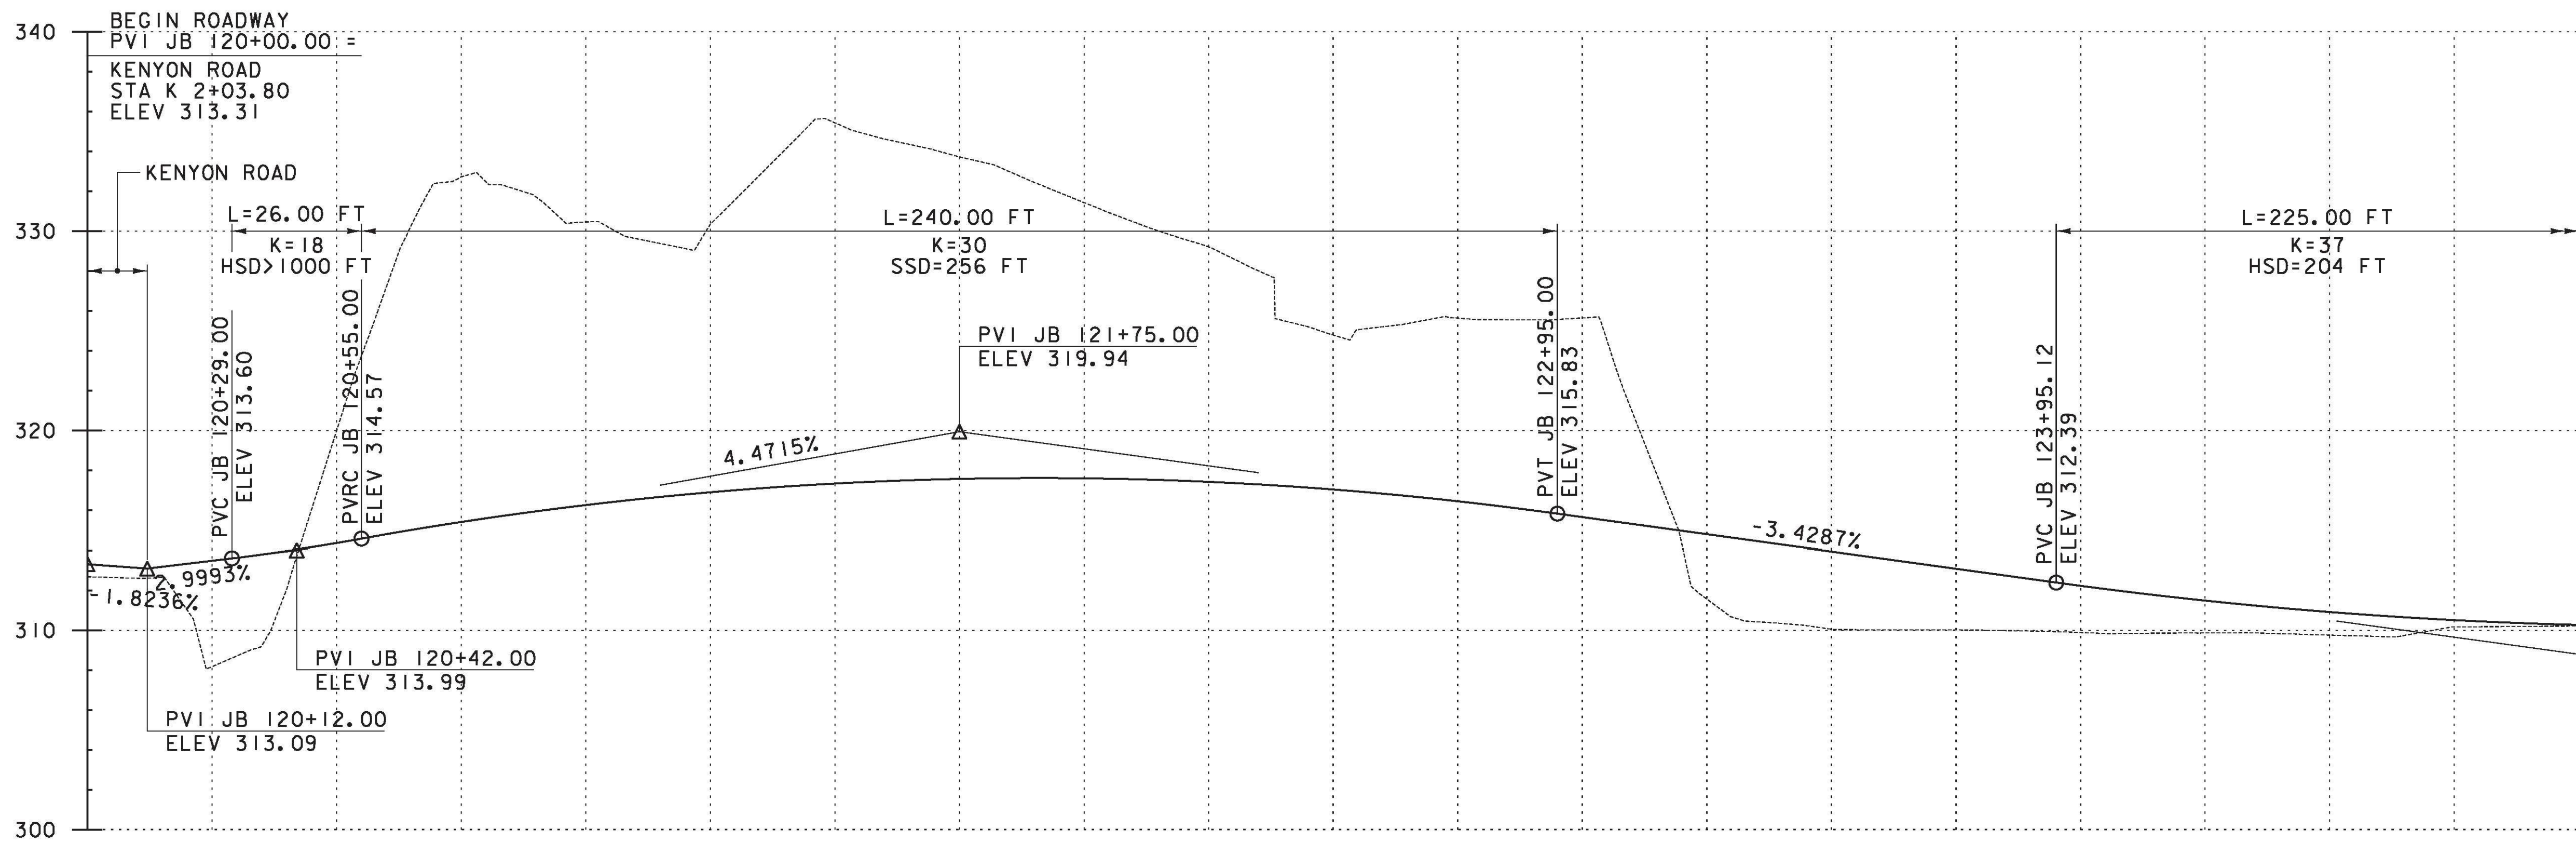

JOHNNIE BROOK ROAD

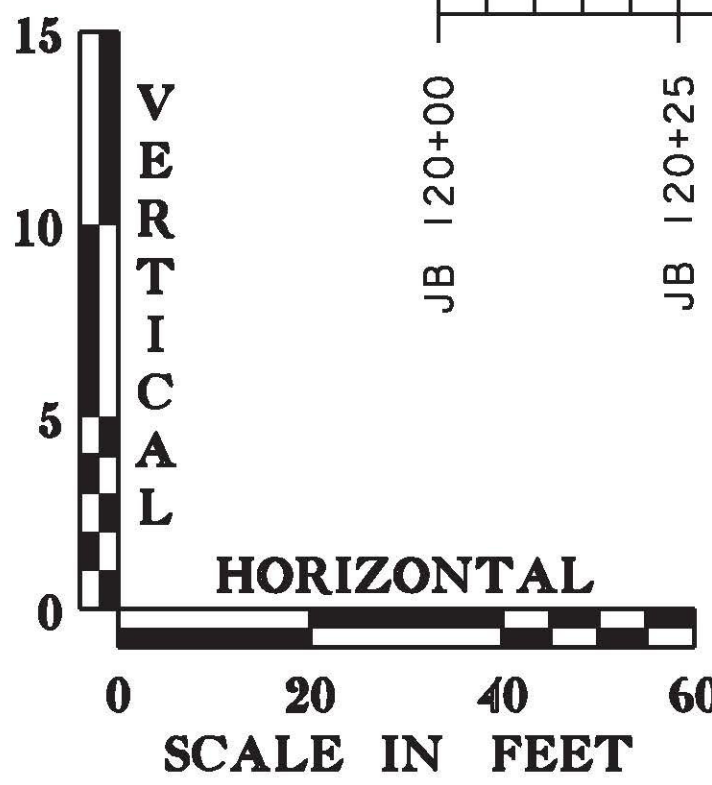

X Reviewed	— Furnish As Corrected
Rejected	— Revise and Resubmit

This review is only for general conformance with the design concept and the information given in the Construction Documents. Correction of omissions made on the shop drawings during the review do not relieve the Contractor from compliance with the requirements of the Plans and Specifications. Review of a specific item shall not include review of an assembly of which an item is a component. The Contractor is responsible for dimensions to be confirmed and corrected at the job site; information that pertains solely to the fabrication process as to the means, methods, techniques, sequences and procedures of construction; coordination of the Work with that of other trades and performing all Work in a safe and satisfactory manner.

Date: August 31, 2011
 By: J. Santacruce

JOHNNIE BROOK ROAD PROFILE	PROJECT NAME: RICHMOND	DRAWN BY: C.A.K.
	PROJECT NUMBER: STP-RS 0284(III)	CHECKED BY: D.E.G.
	FILE NAME: z90c092_PRO_06_14.dgn	SHEET 17 OF 46
	DESIGNED BY: B.T.H.	
DWG. NO.: PR-6		

MATCH LINE STA JB 125+00, SEE DWG PR-7