


**U.S. ROUTE 2/KENYON ROAD INTERSECTION GRADING**

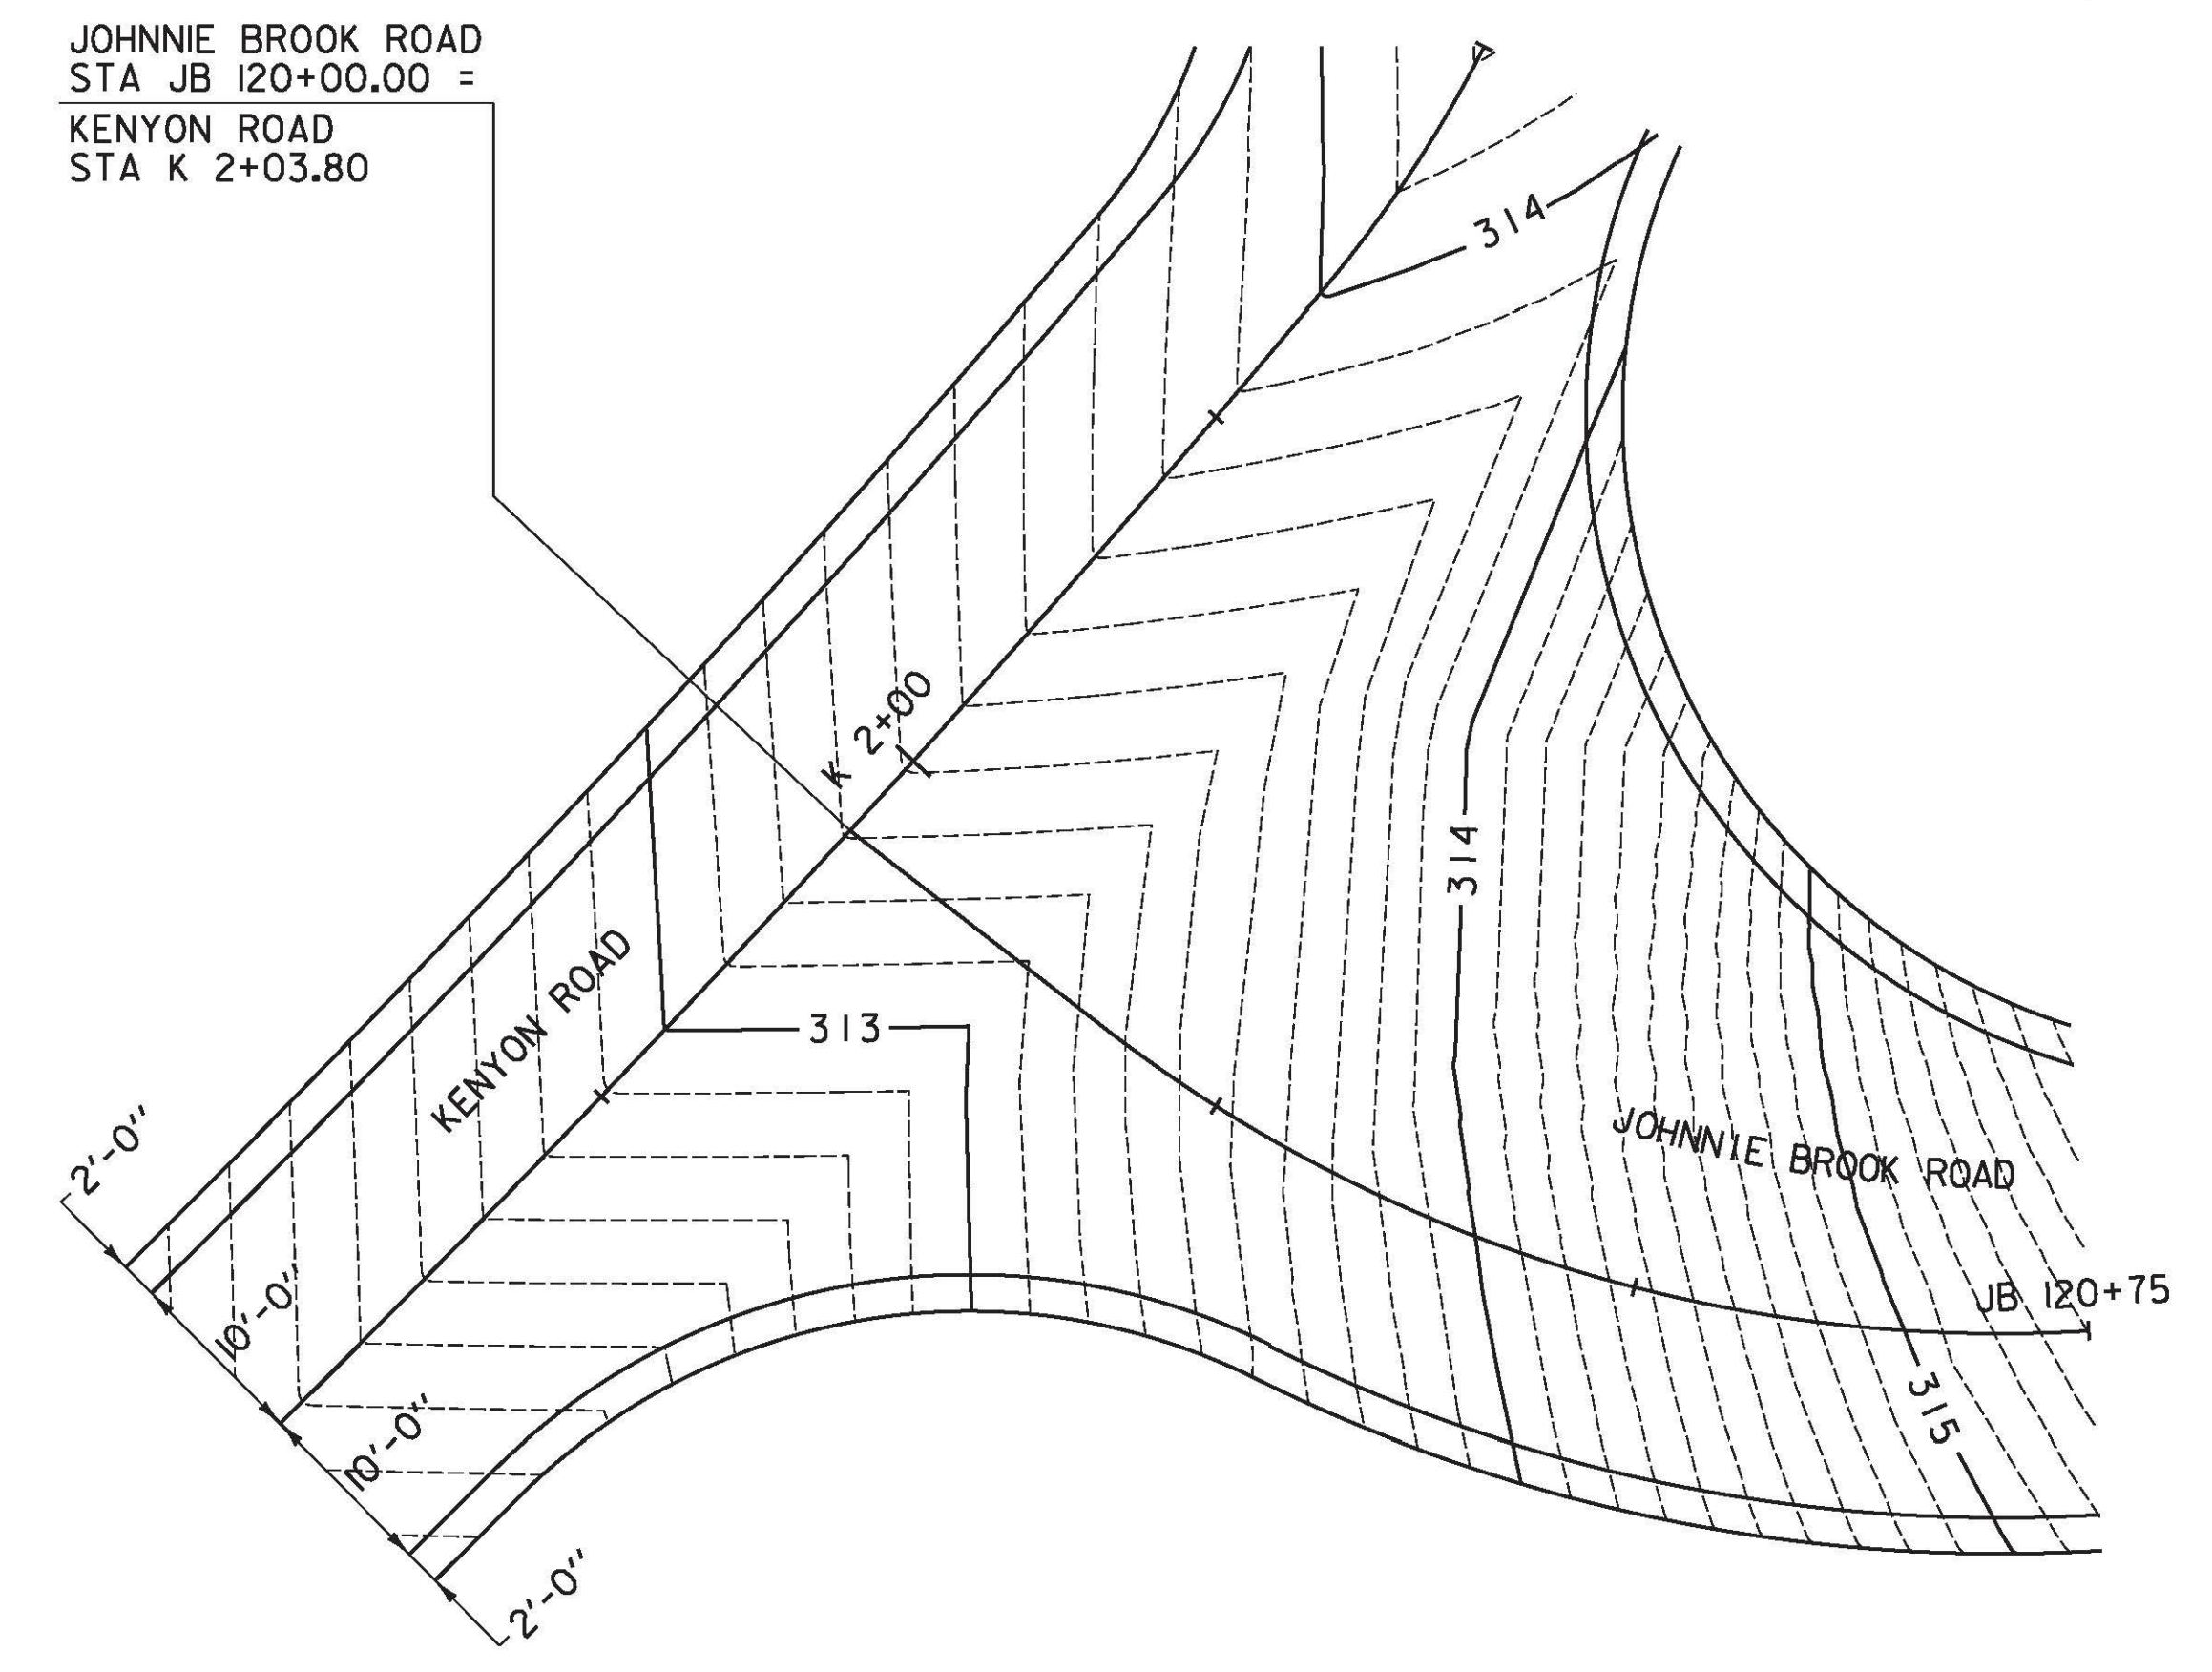


**KENYON ROAD/JOHNNIE BROOK ROAD INTERSECTION GRADING**

FILE NAME = V:\P\Projects\ANY\K2\22076\CAOD\INST\MSB (1-14) ROADWAY DESIGN\90c092.grading\_01.l4.dgn  
 DATE/TIME = 8/25/2011  
 USER = 3086

<input checked="" type="checkbox"/> Reviewed	<input type="checkbox"/> Furnish As Corrected
<input type="checkbox"/> Rejected	<input type="checkbox"/> Revise and Resubmit

This review is only for general conformance with the design concept and the information given in the Construction Documents. Corrections or comments made on the shop drawings during the review do not relieve the Contractor from compliance with the requirements of the Plans and Specifications. Review of a specific item shall not include review of an assembly of which it is a component. The Contractor is responsible for dimensions to be confirmed and corrected at the job site. Information that pertains solely to the fabrication process or to the means, methods, techniques, sequences and procedures of construction, coordination of the Work with that of other trades and performing all Work in a safe and satisfactory manner.

Date: August 21, 2011  
 By: J. Santacruce

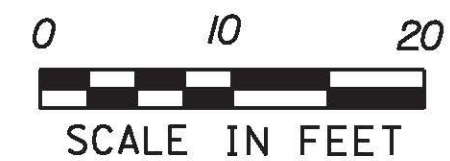

**GRADING  
 PLAN  
 SHEET**

PROJECT NAME: RICHMOND	PLOT DATE: 8/25/2011
PROJECT NUMBER: STP-RS 0284(III)	DRAWN BY: C.A.K.
FILE NAME: z90c092_GRADING_01.l4.dgn	CHECKED BY: D.E.G.
PROJECT LEADER: D.E.G.	SHEET 19 OF 46
DESIGNED BY: B.T.H.	
DWG. NO.: G-1	