




FILE NAME = V:\Projects\AR\141\ROADWAY DESIGN\30c092\_sections\_rout14.dgn  
 DATE/TIME = 8/25/2011  
 USER = 3086

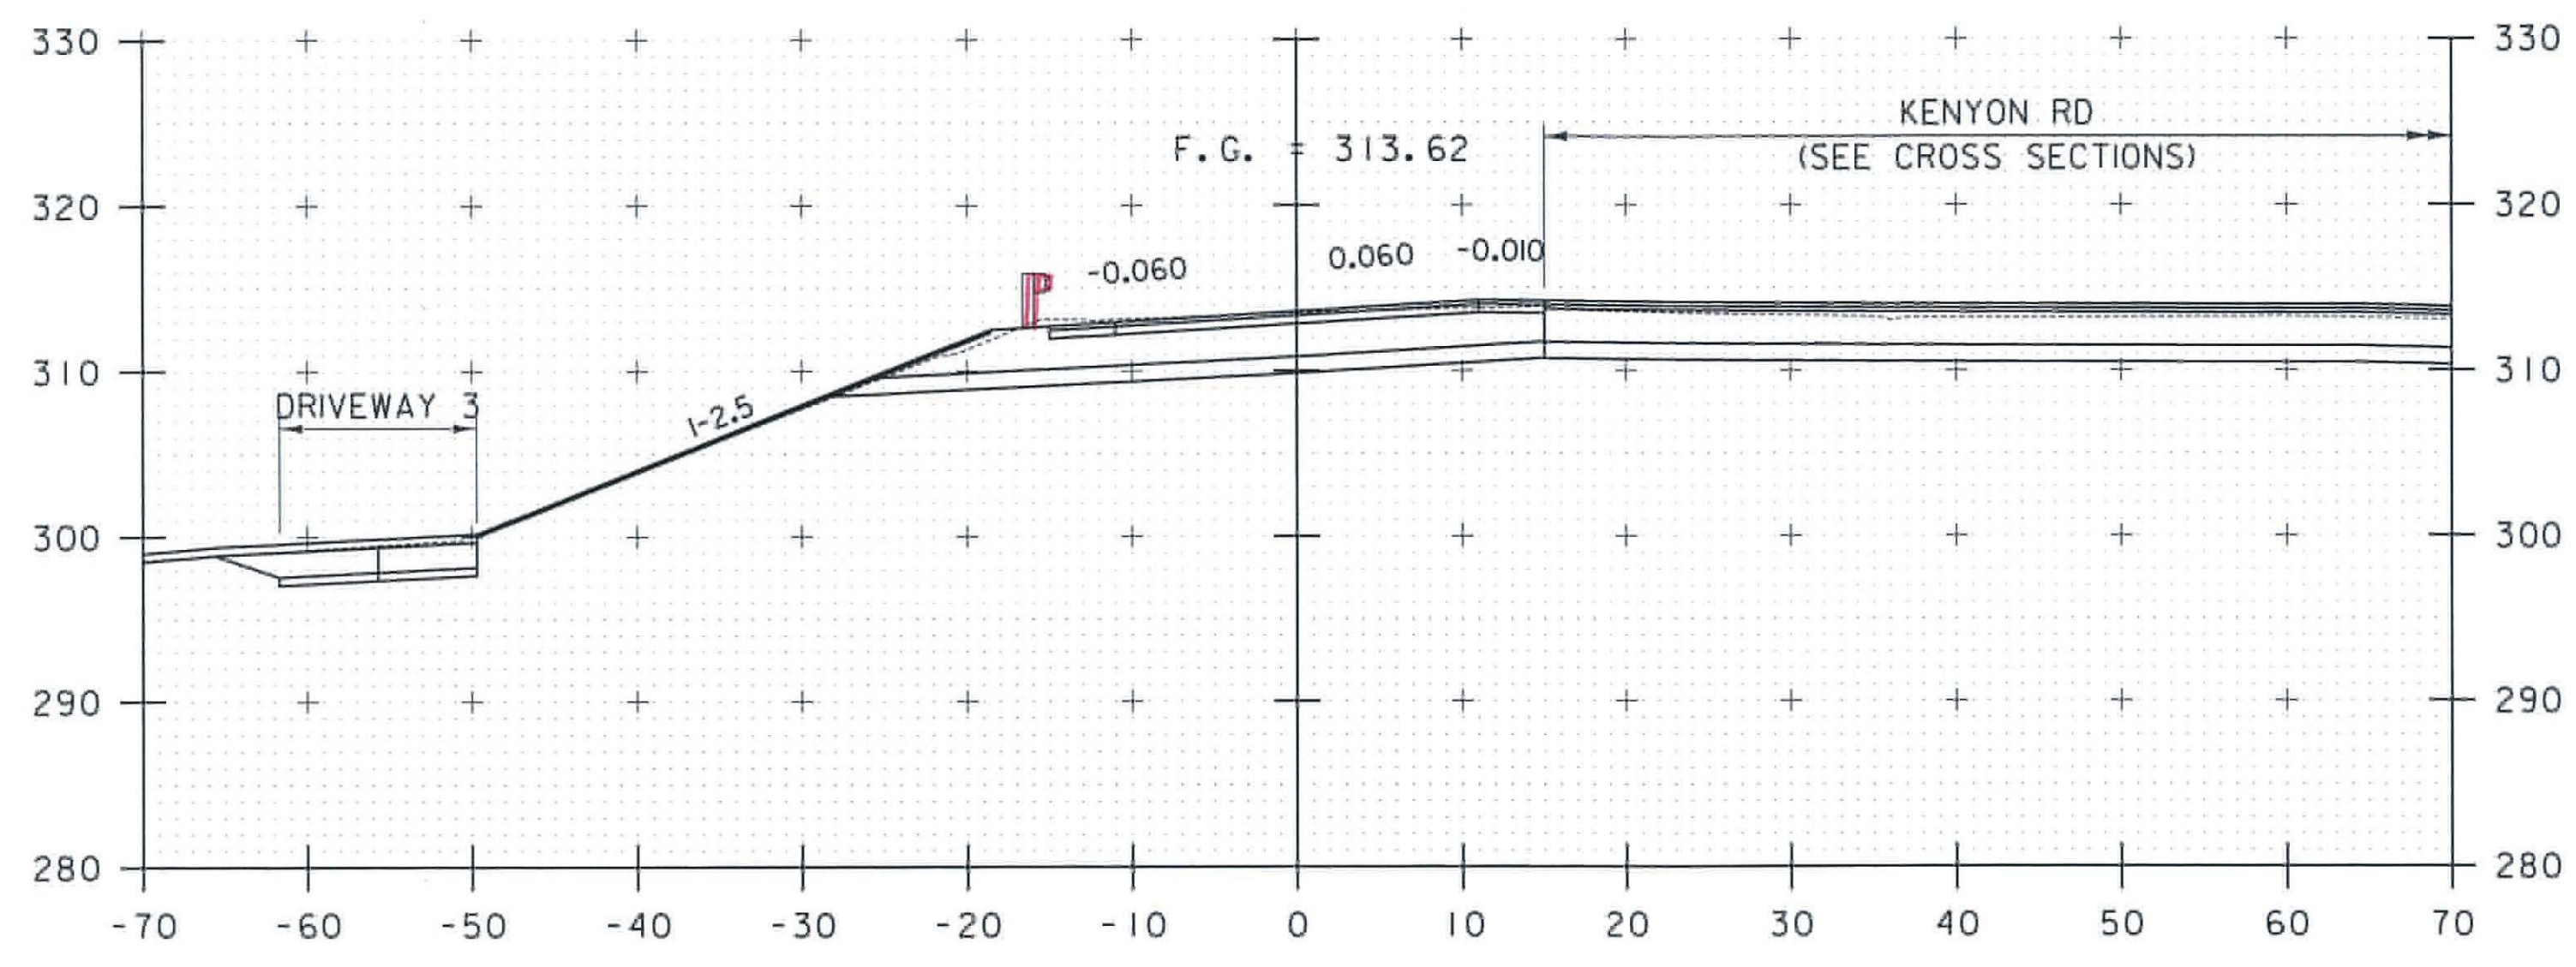


33+00

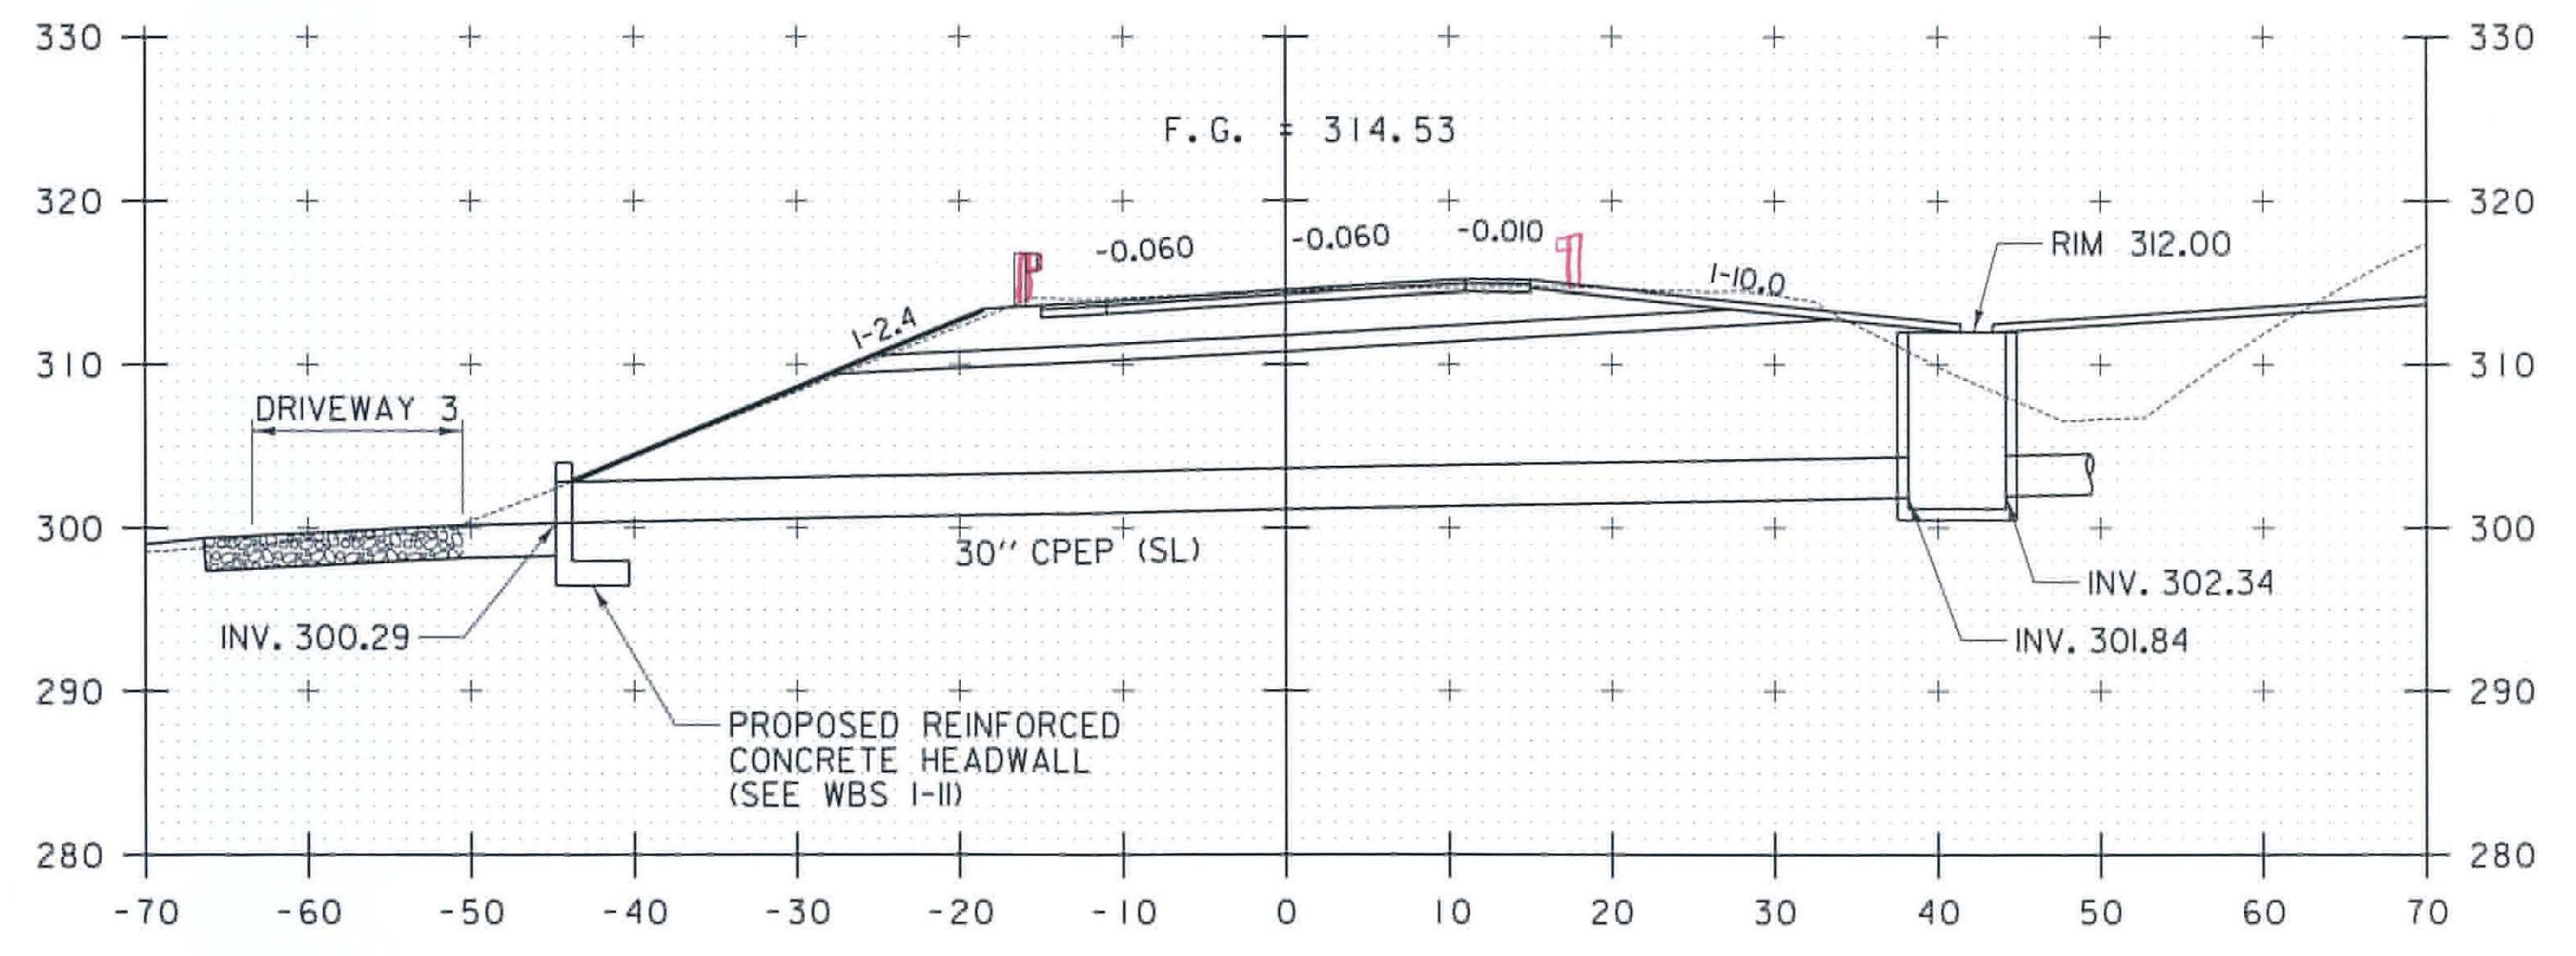

33+43

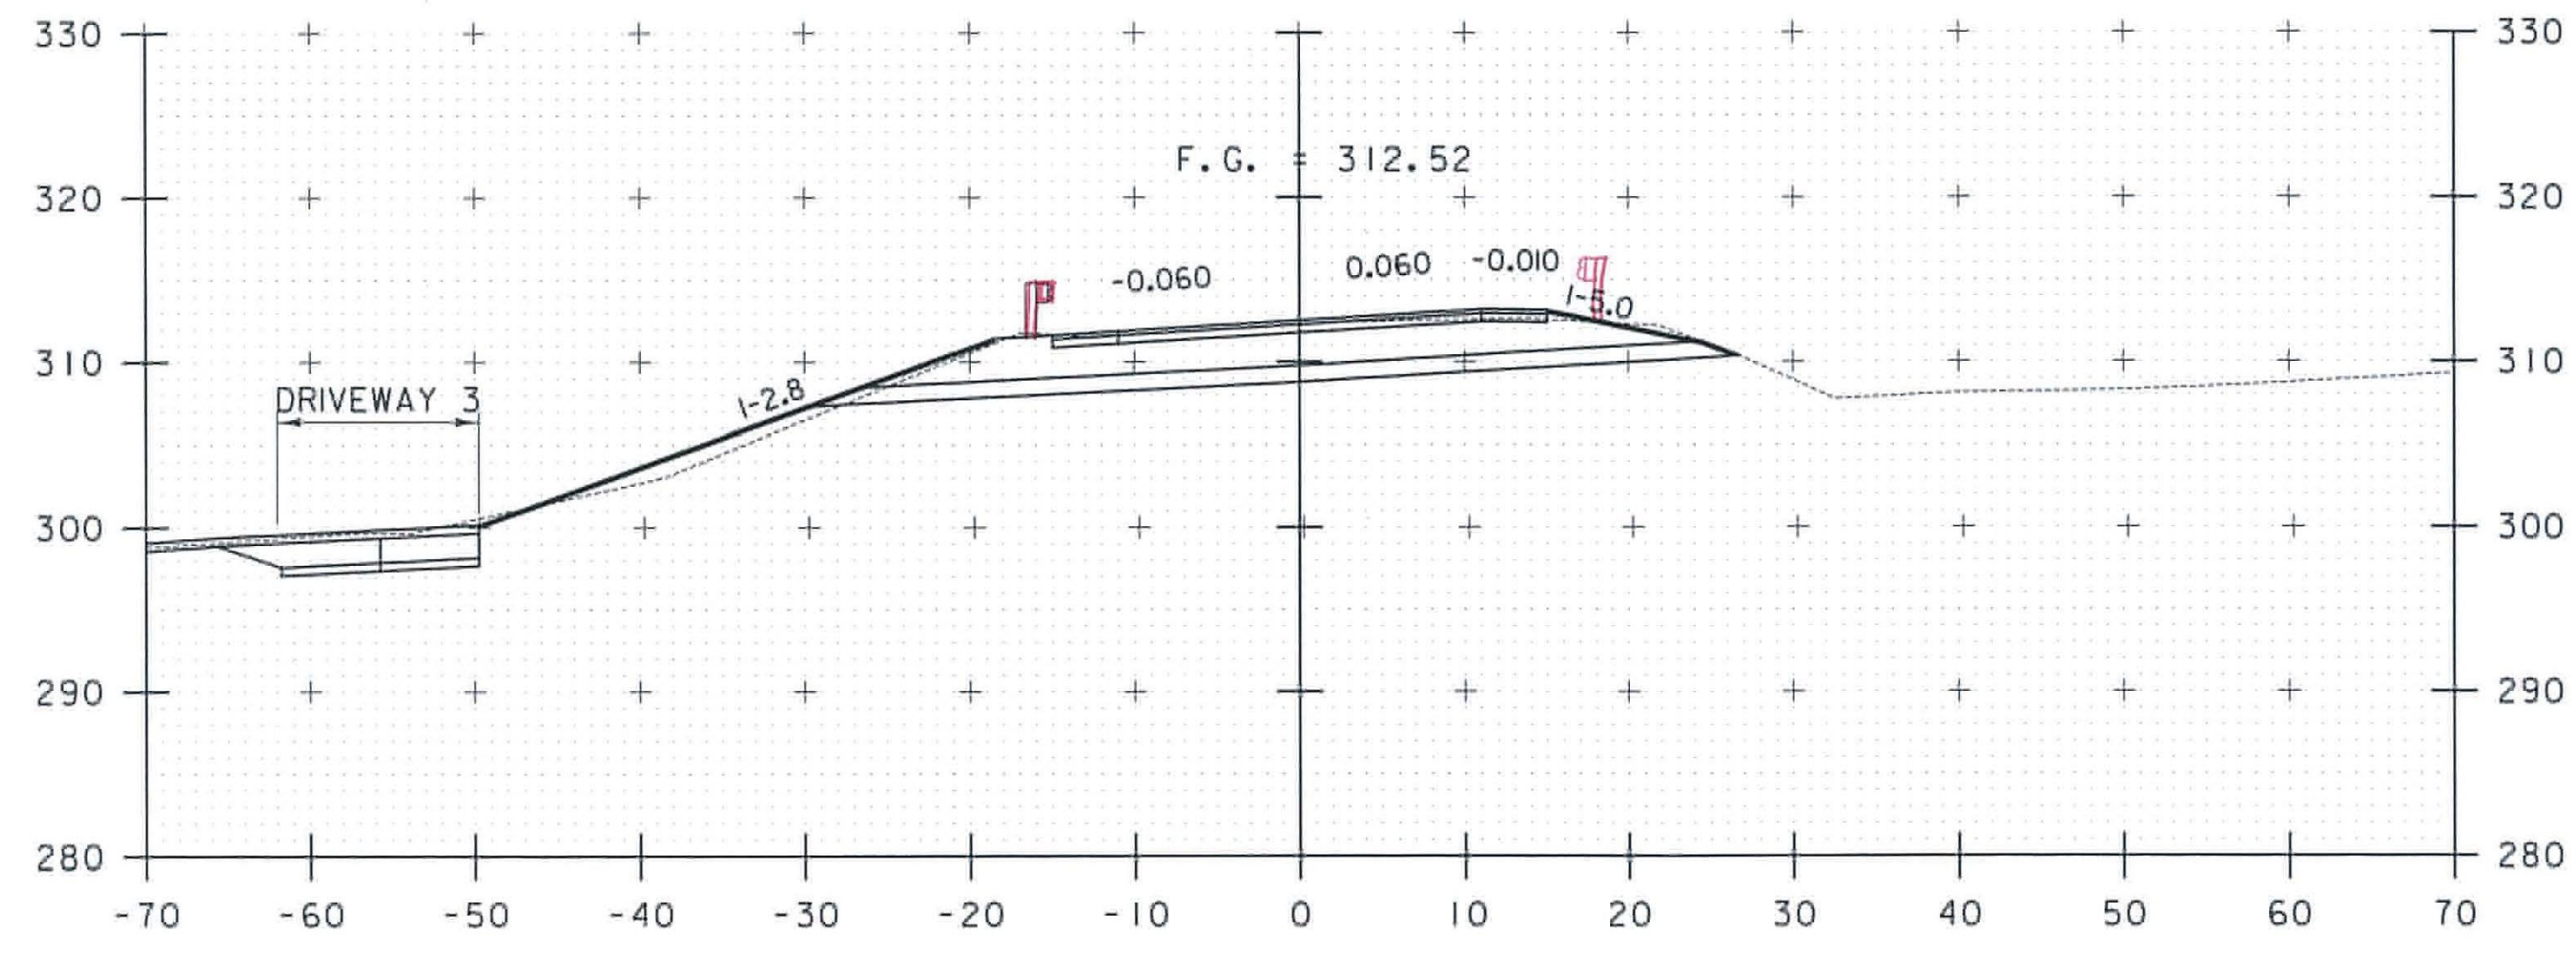

32+50

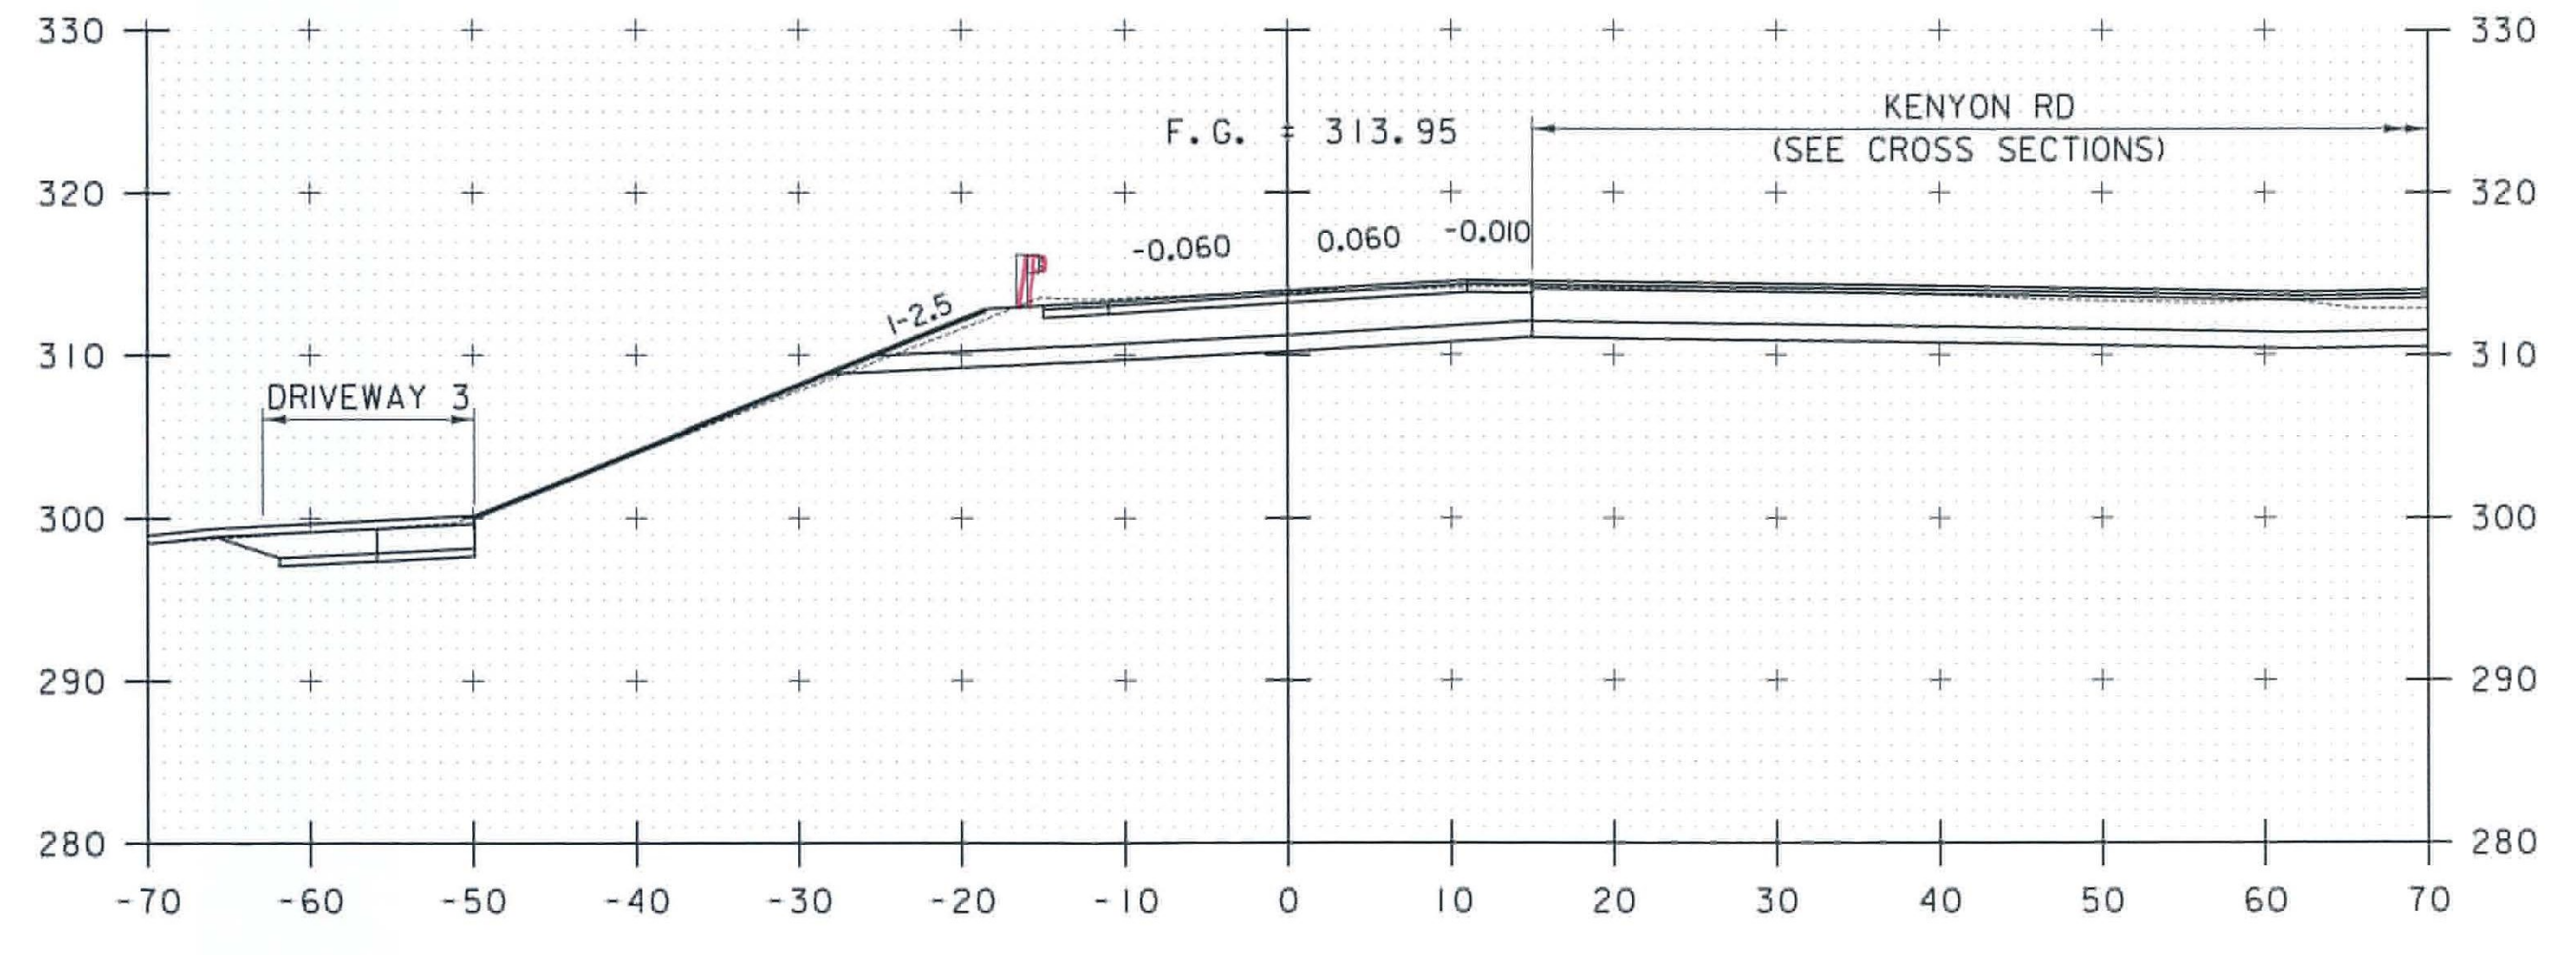


33+15

X	Reviewed	_____	Furnish As Corrected
_____	Rejected	_____	Revise and Resubmit

This review is only for general conformance with the design concept and the information given in the Construction Documents. Comments or corrections made on the shop drawings during the review do not release the Contractor from compliance with the requirements of the Plans and Specifications. Review of a specific item shall not include review of its assembly of which is not shown. The Contractor is responsible for dimensions to be confirmed and corrected at the job site, information that pertains solely to the fabricator's process, or to the means, methods, techniques, sequences and procedures of construction, coordination of the work with that of other trades and performing all work in a safe and satisfactory manner.

Date: August 25, 2011  
 J. Santacruz

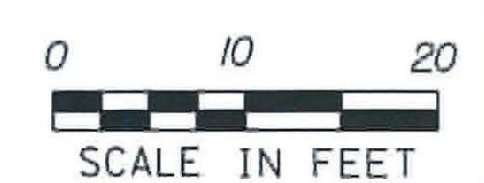

<b>CROSS SECTIONS SHEET #3</b>	PROJECT NAME: RICHMOND	PLOT DATE: 8/25/2011
	PROJECT NUMBER: STP-RS 0284(II)	DRAWN BY: C.A.K.
	FILE NAME: z90c092_XSI_14.dgn	CHECKED BY: D.E.G.
	DESIGNED BY: B.T.H.	SHEET 25 OF 46
	DWG. NO.: XS-3	