




FILE NAME = V:\P\Projects\AM\1\2\22076\CADD\MST\NWB\1-14\ROADWAY DESIGN\490c092_xsections_routel4.dgn
 DATE/TIME = 8/25/2011
 USER = 3006

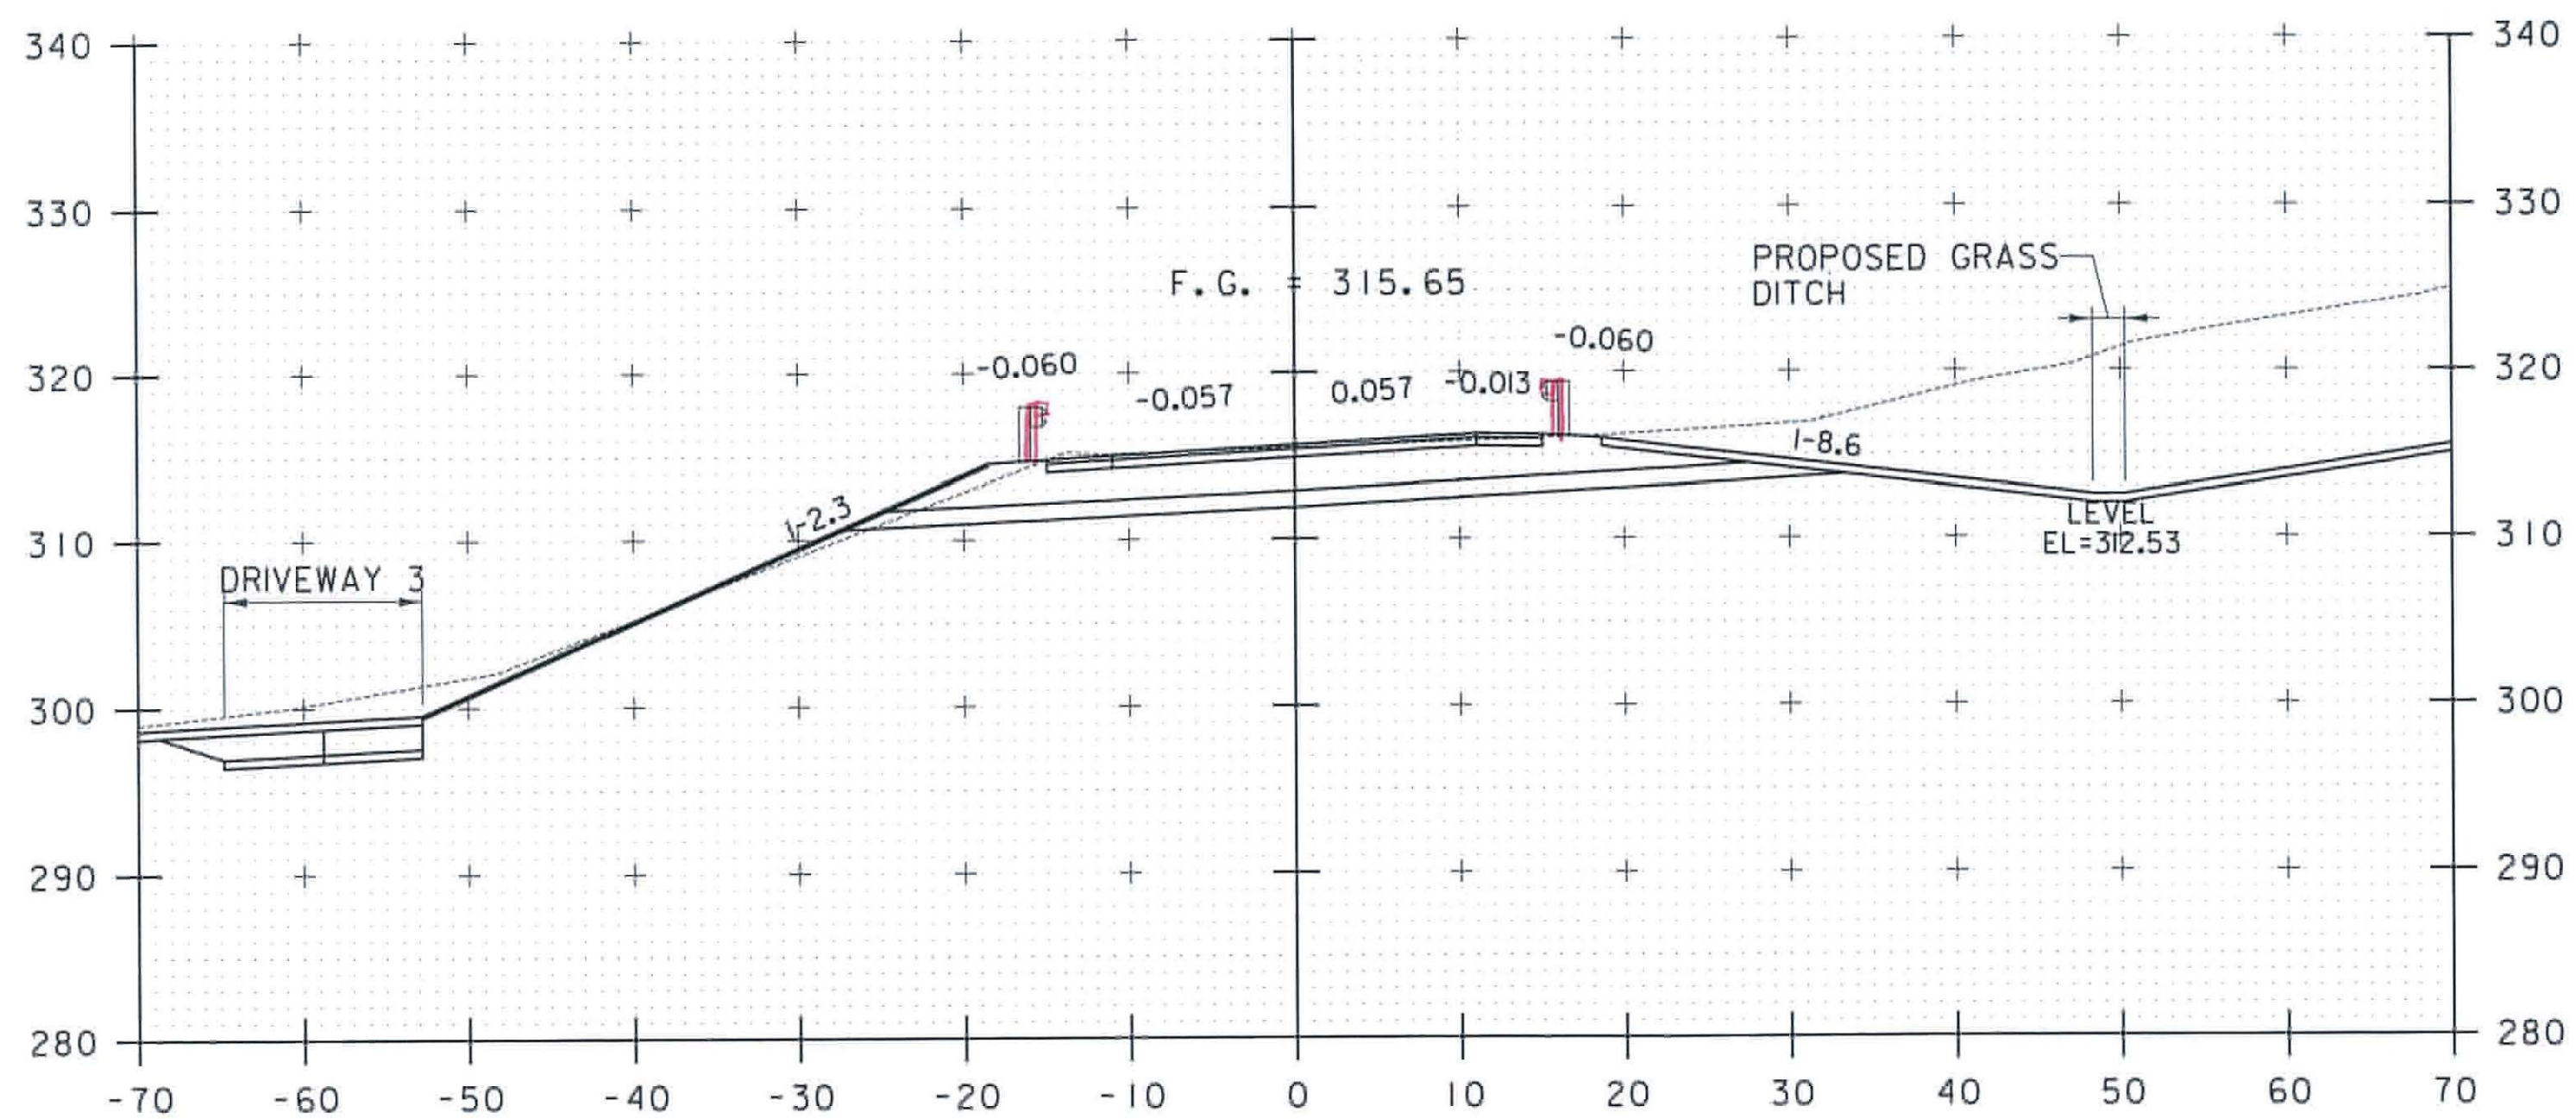


34+00

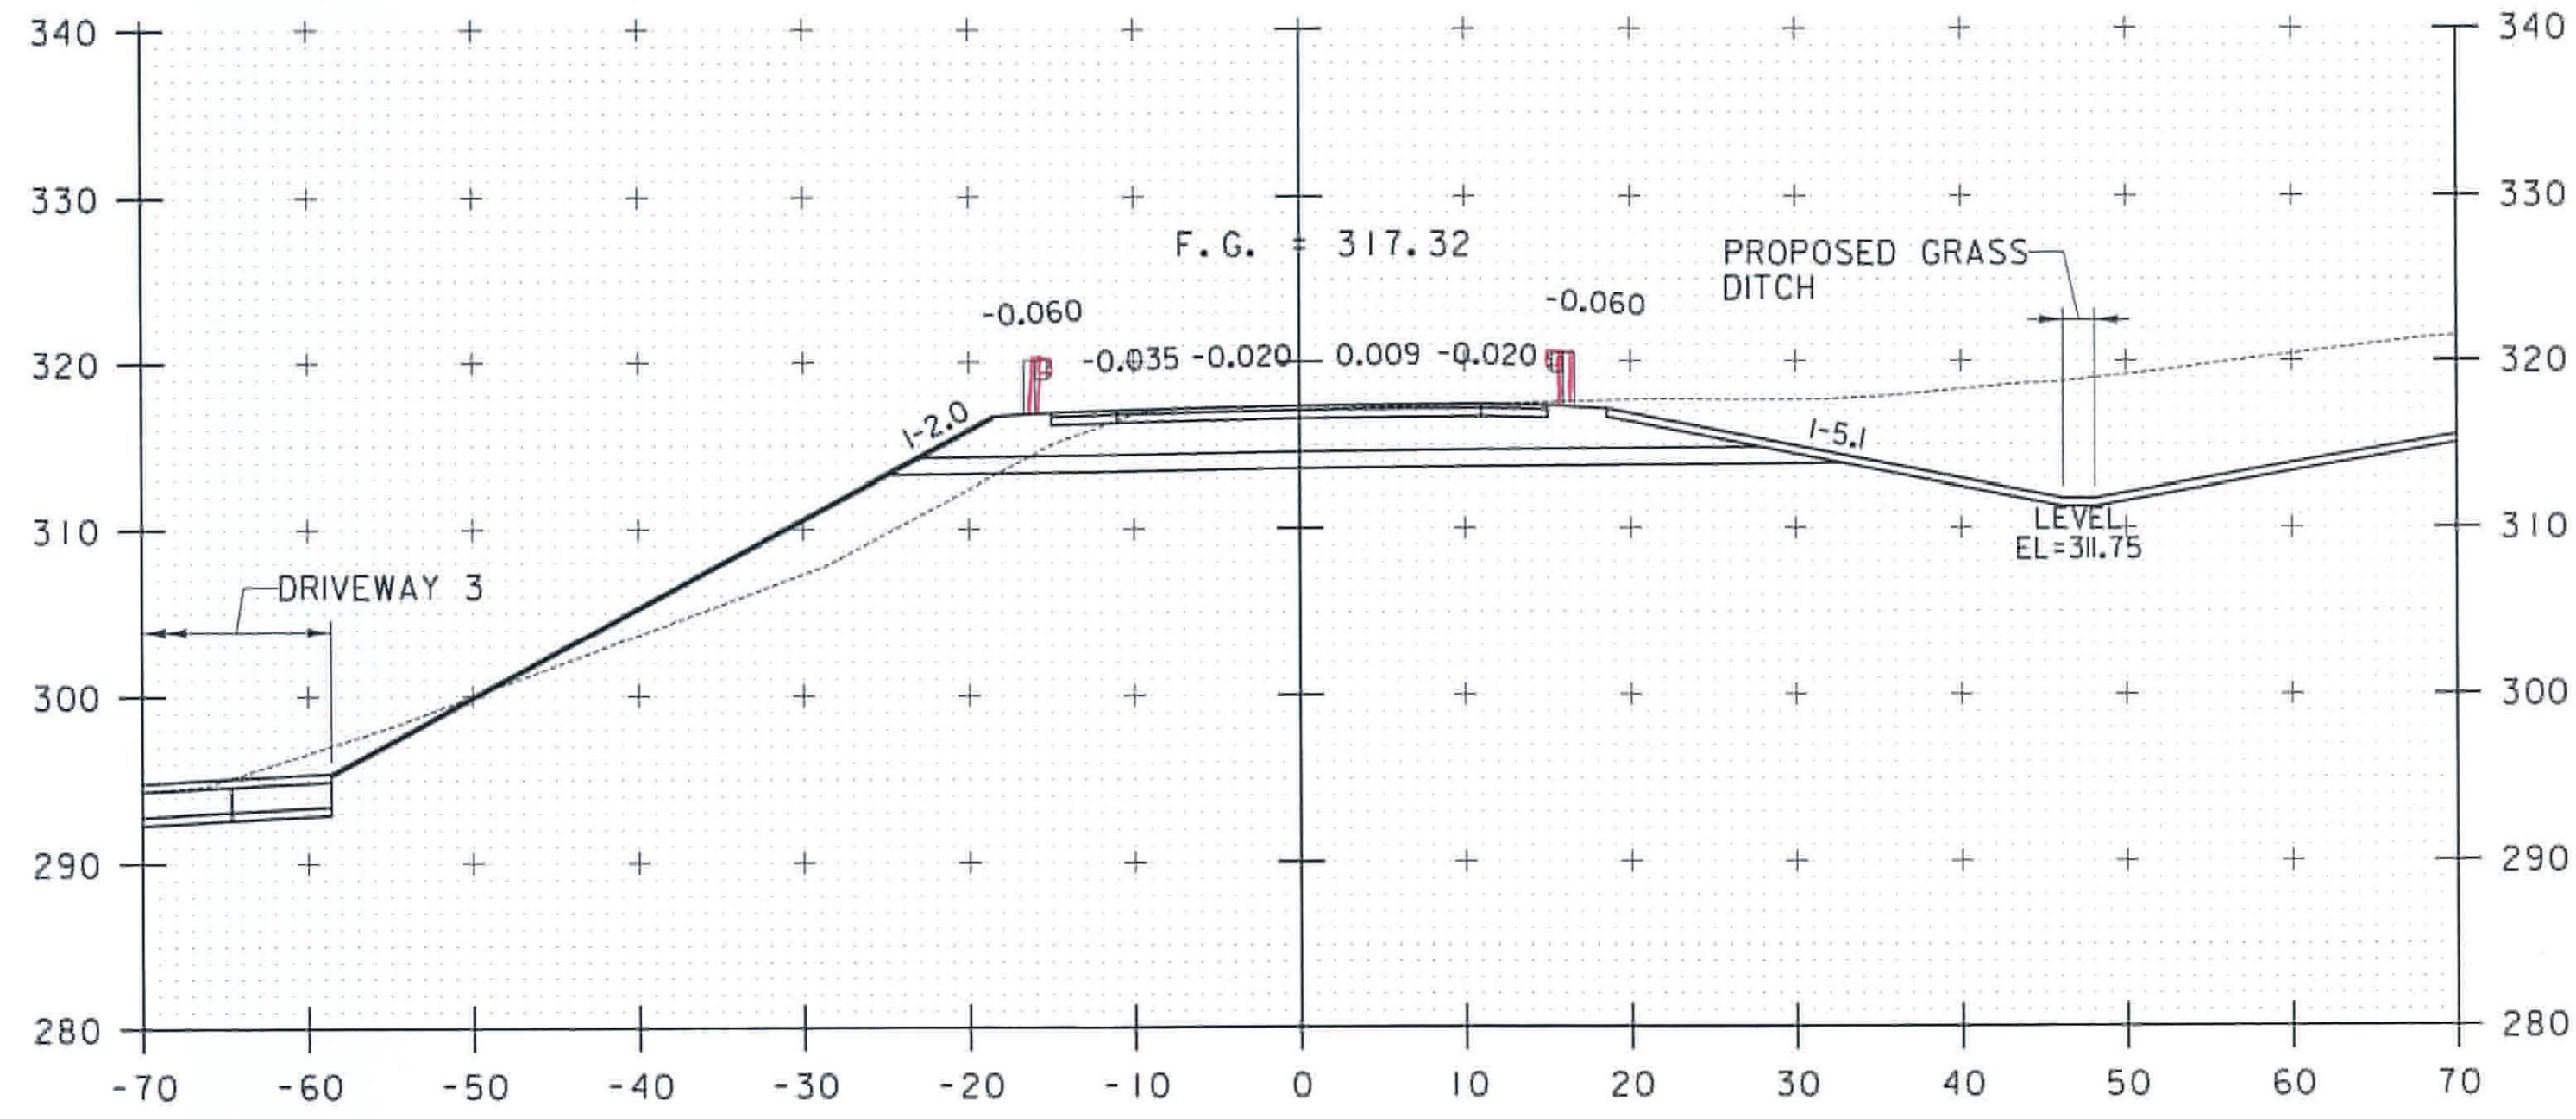

35+00

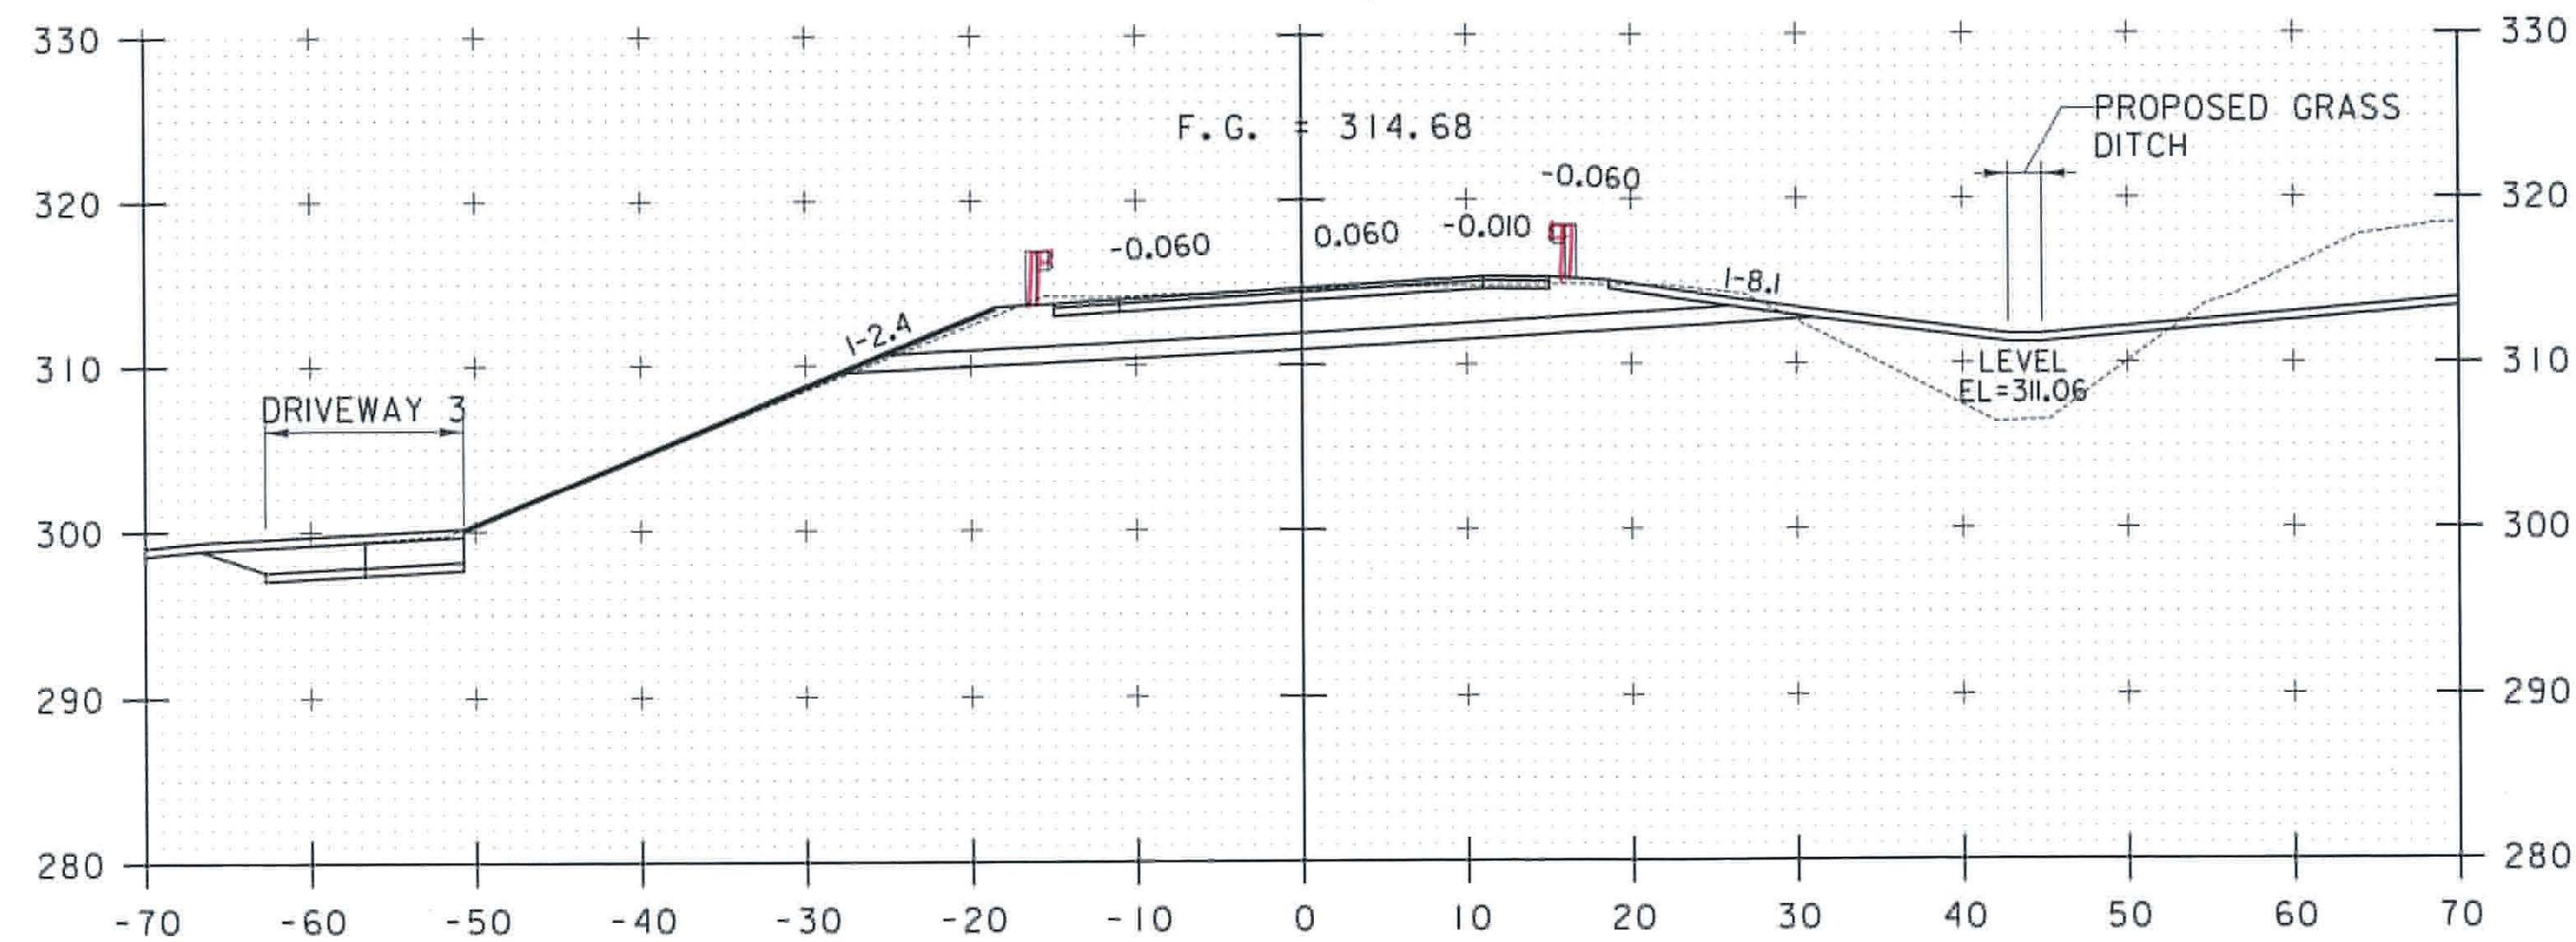

33+50

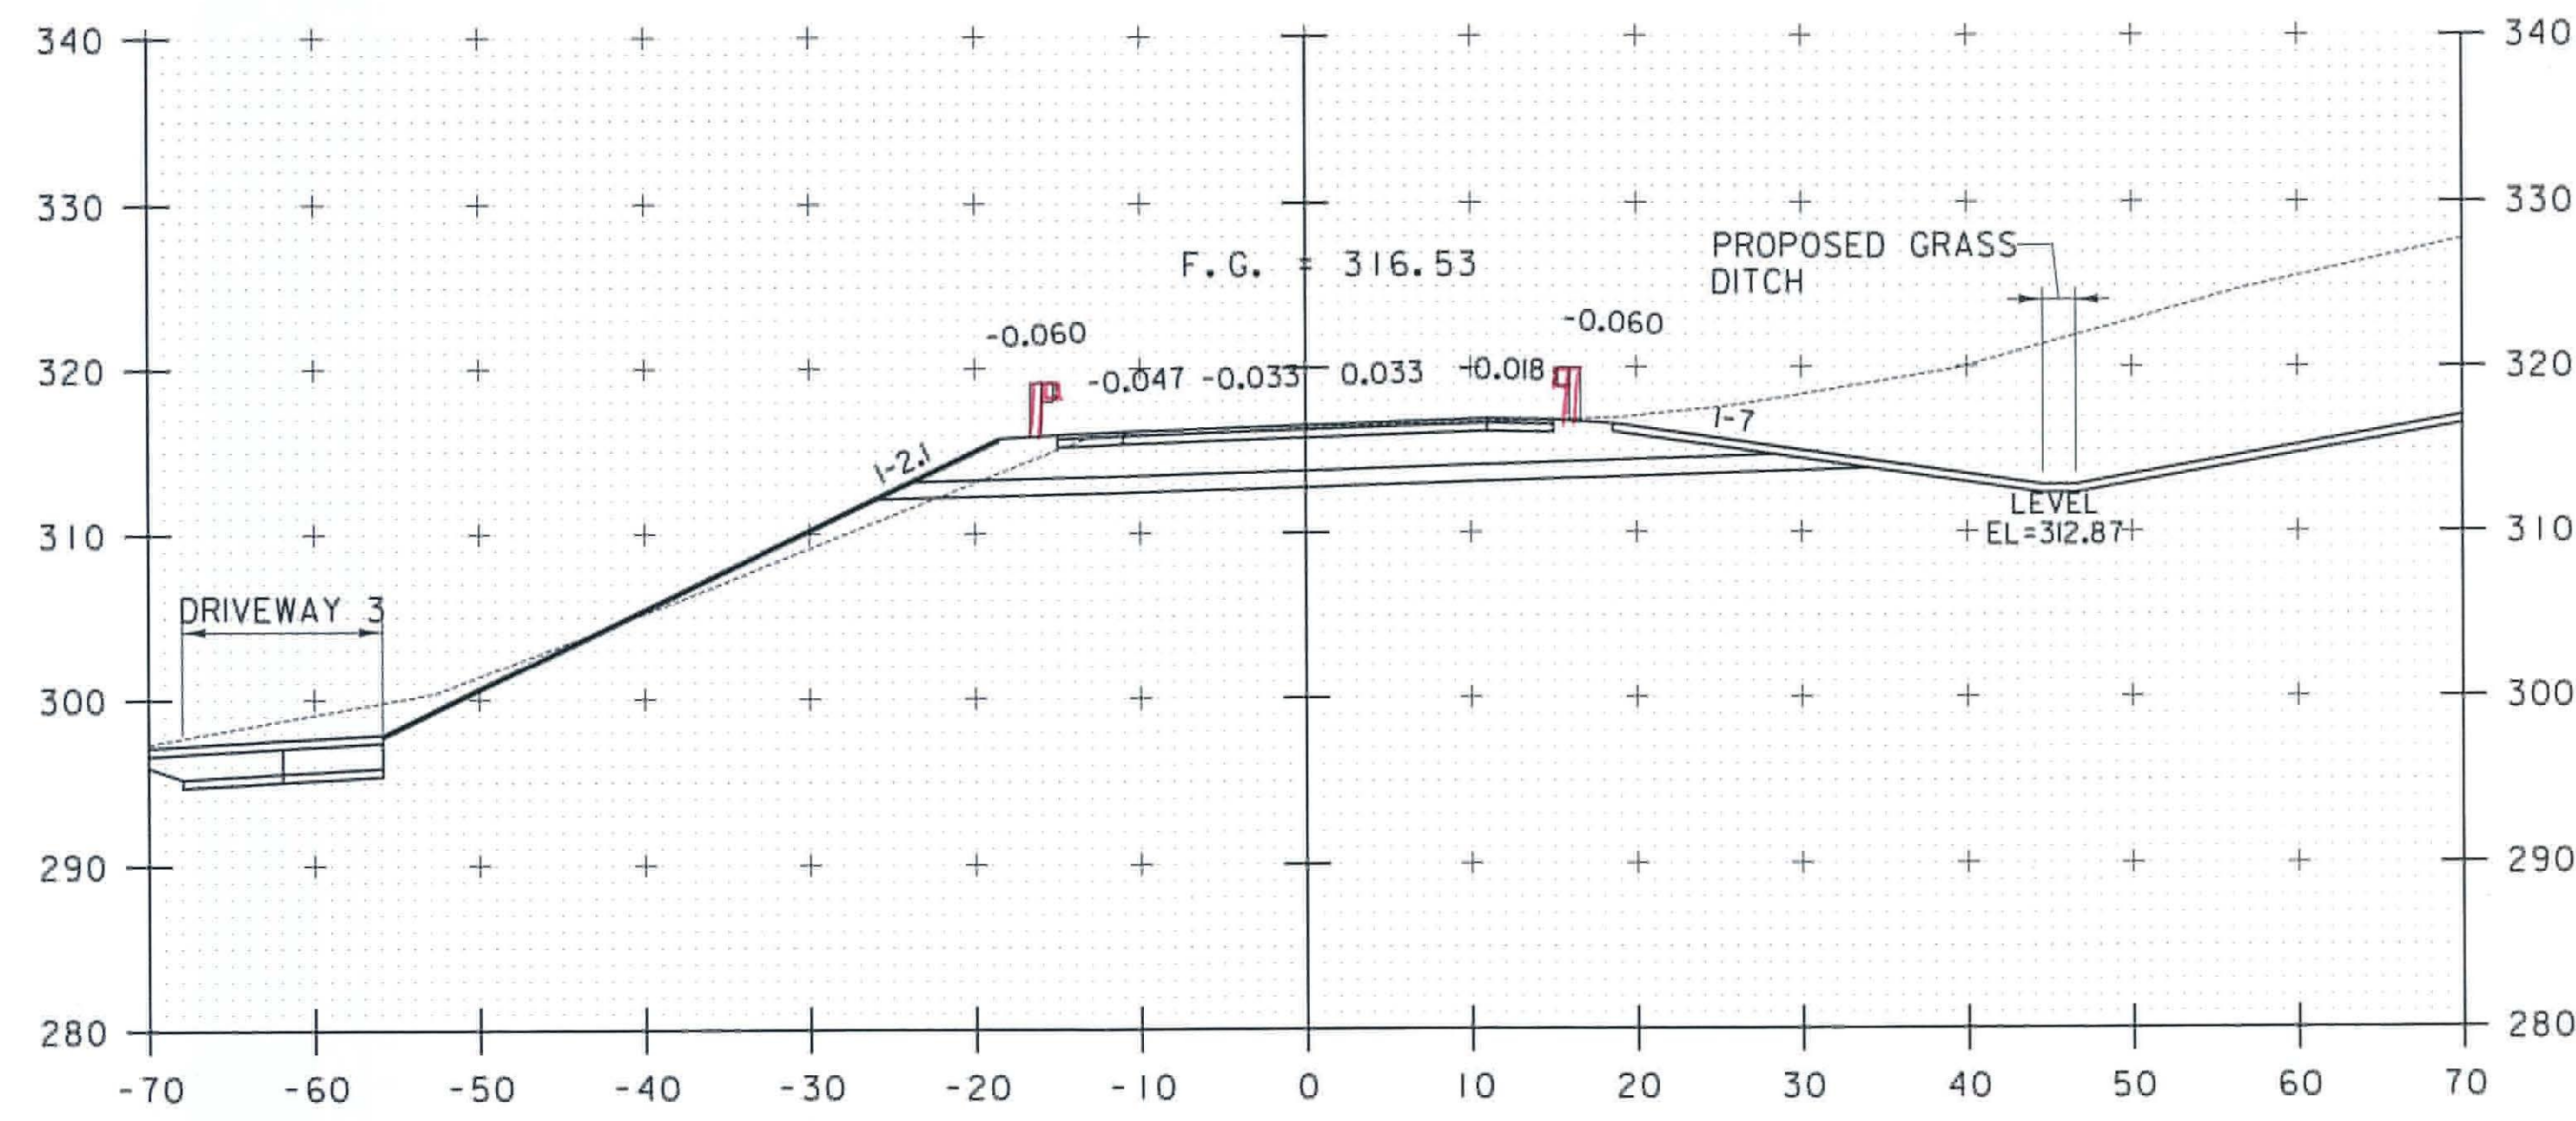


34+50

X	Reviewed	Final
✓	As Corrected	Revise and Resubmit
○	Rejected	

This review is only for general conformance with the design concept and the information given in the Construction Documents. Consideration or comments made on the shop drawings during the review do not release the Contractor from compliance with the requirements of the Plans and Specifications. Review of a specific item shall not preclude review of an assembly of which it is a component. The Contractor is responsible for dimensions to be confirmed and corrected at the job site, information that pertains solely to the fabrication process or to the means, methods, techniques, sequences and procedures of construction, coordination of the Work with that of other trades and performing all Work in a safe and satisfactory manner.

DATE: August 21, 2011
 J. Santacruz

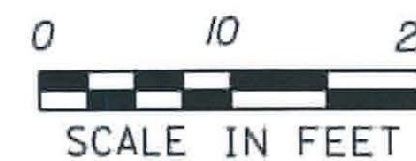

CROSS SECTIONS SHEET #4

PROJECT NAME: RICHMOND	PLOT DATE: 8/25/2011
PROJECT NUMBER: STP-RS 0284(II)	DRAWN BY: C.A.K.
FILE NAME: z90c092.XSL14.dgn	CHECKED BY: D.E.G.
PROJECT LEADER: D.E.G.	DWG. NO.: XS-4
DESIGNED BY: B.T.H.	SHEET 26 OF 46