




FILE NAME = v:\projects\enr\1422076\cadd\mstr\wbs (1-14) roadway design\z90c092_xsections\route2_14.dgn
 DATE/TIME = 8/25/2011
 USER = 3086

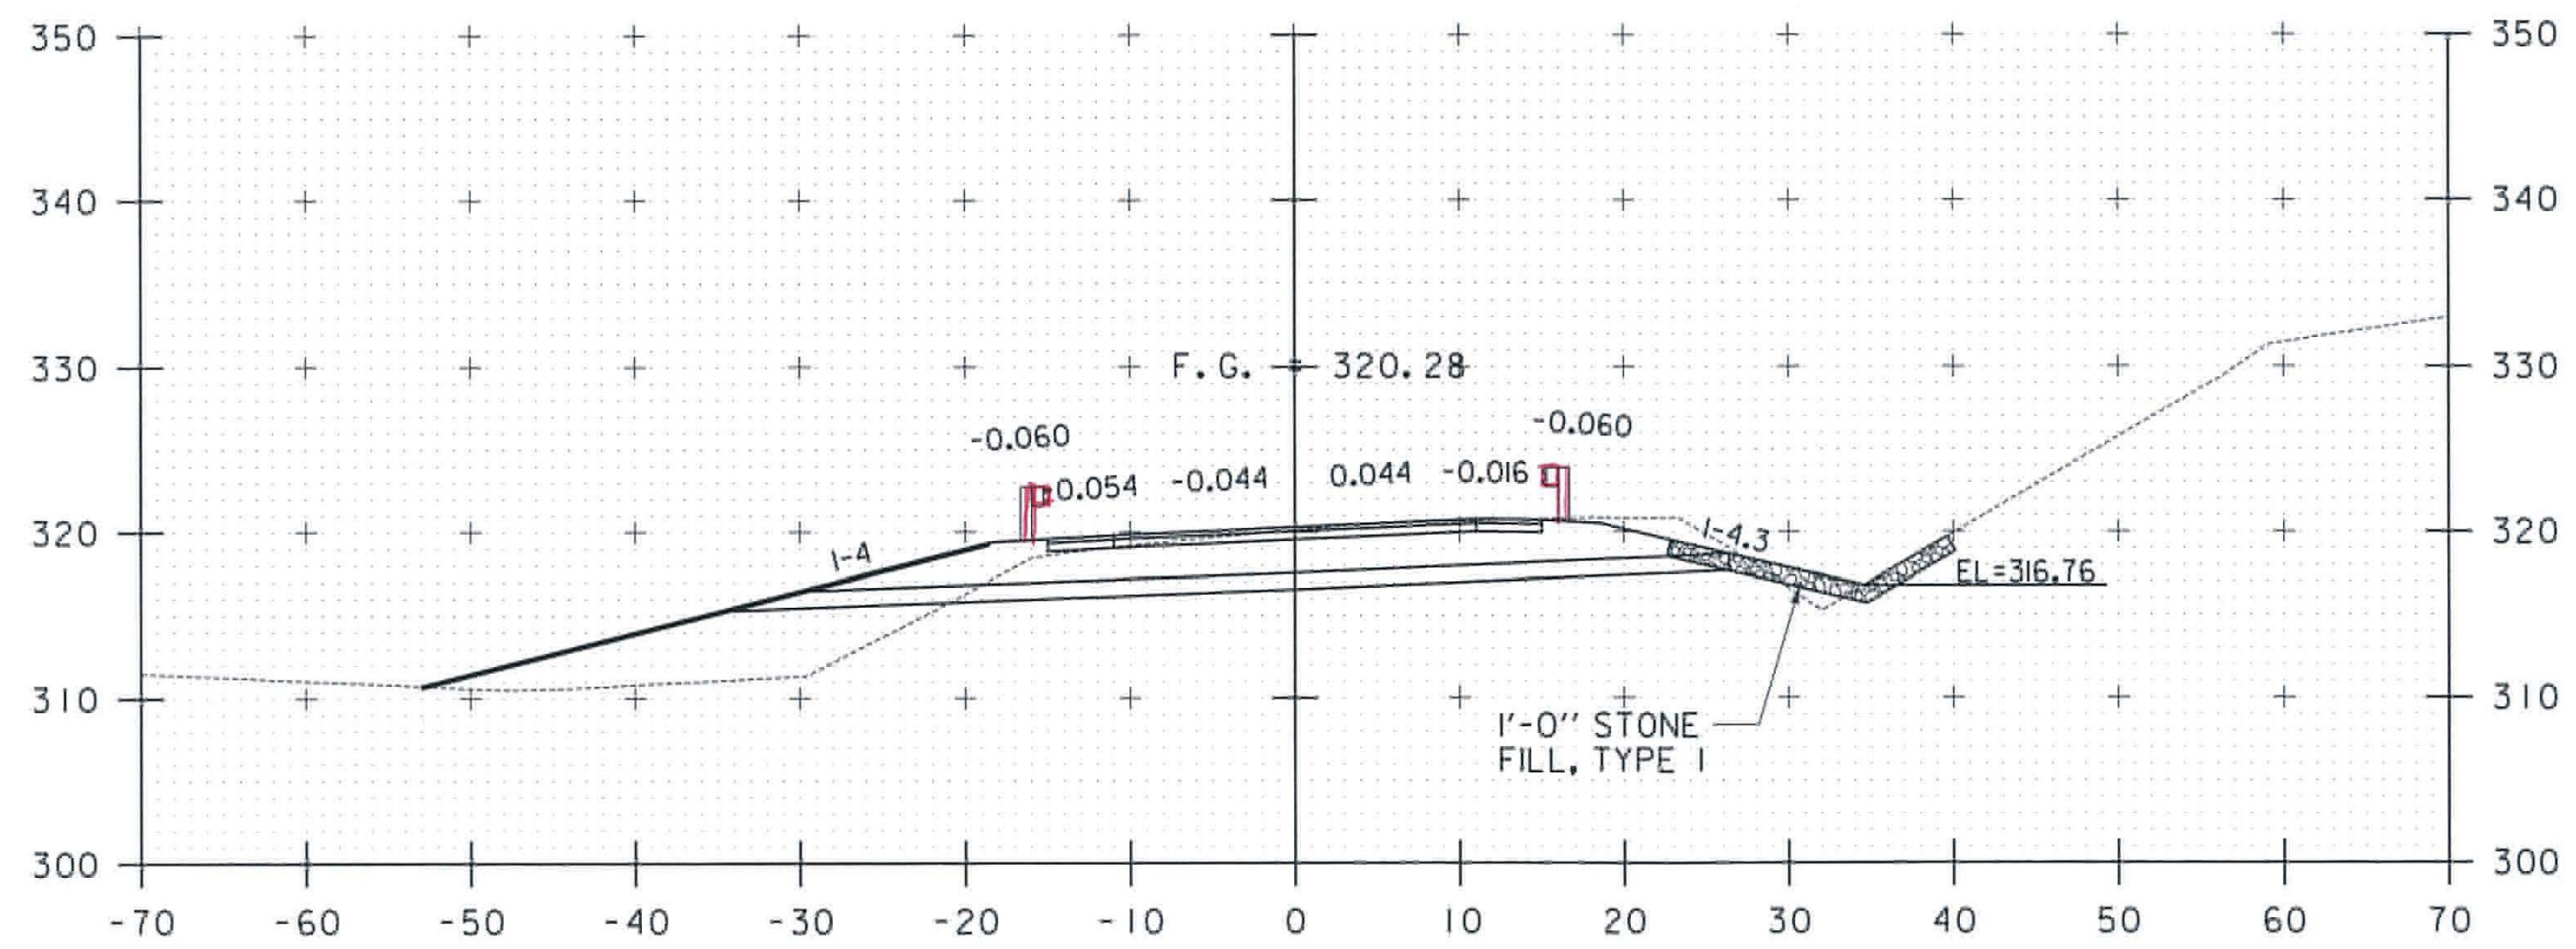


40+50

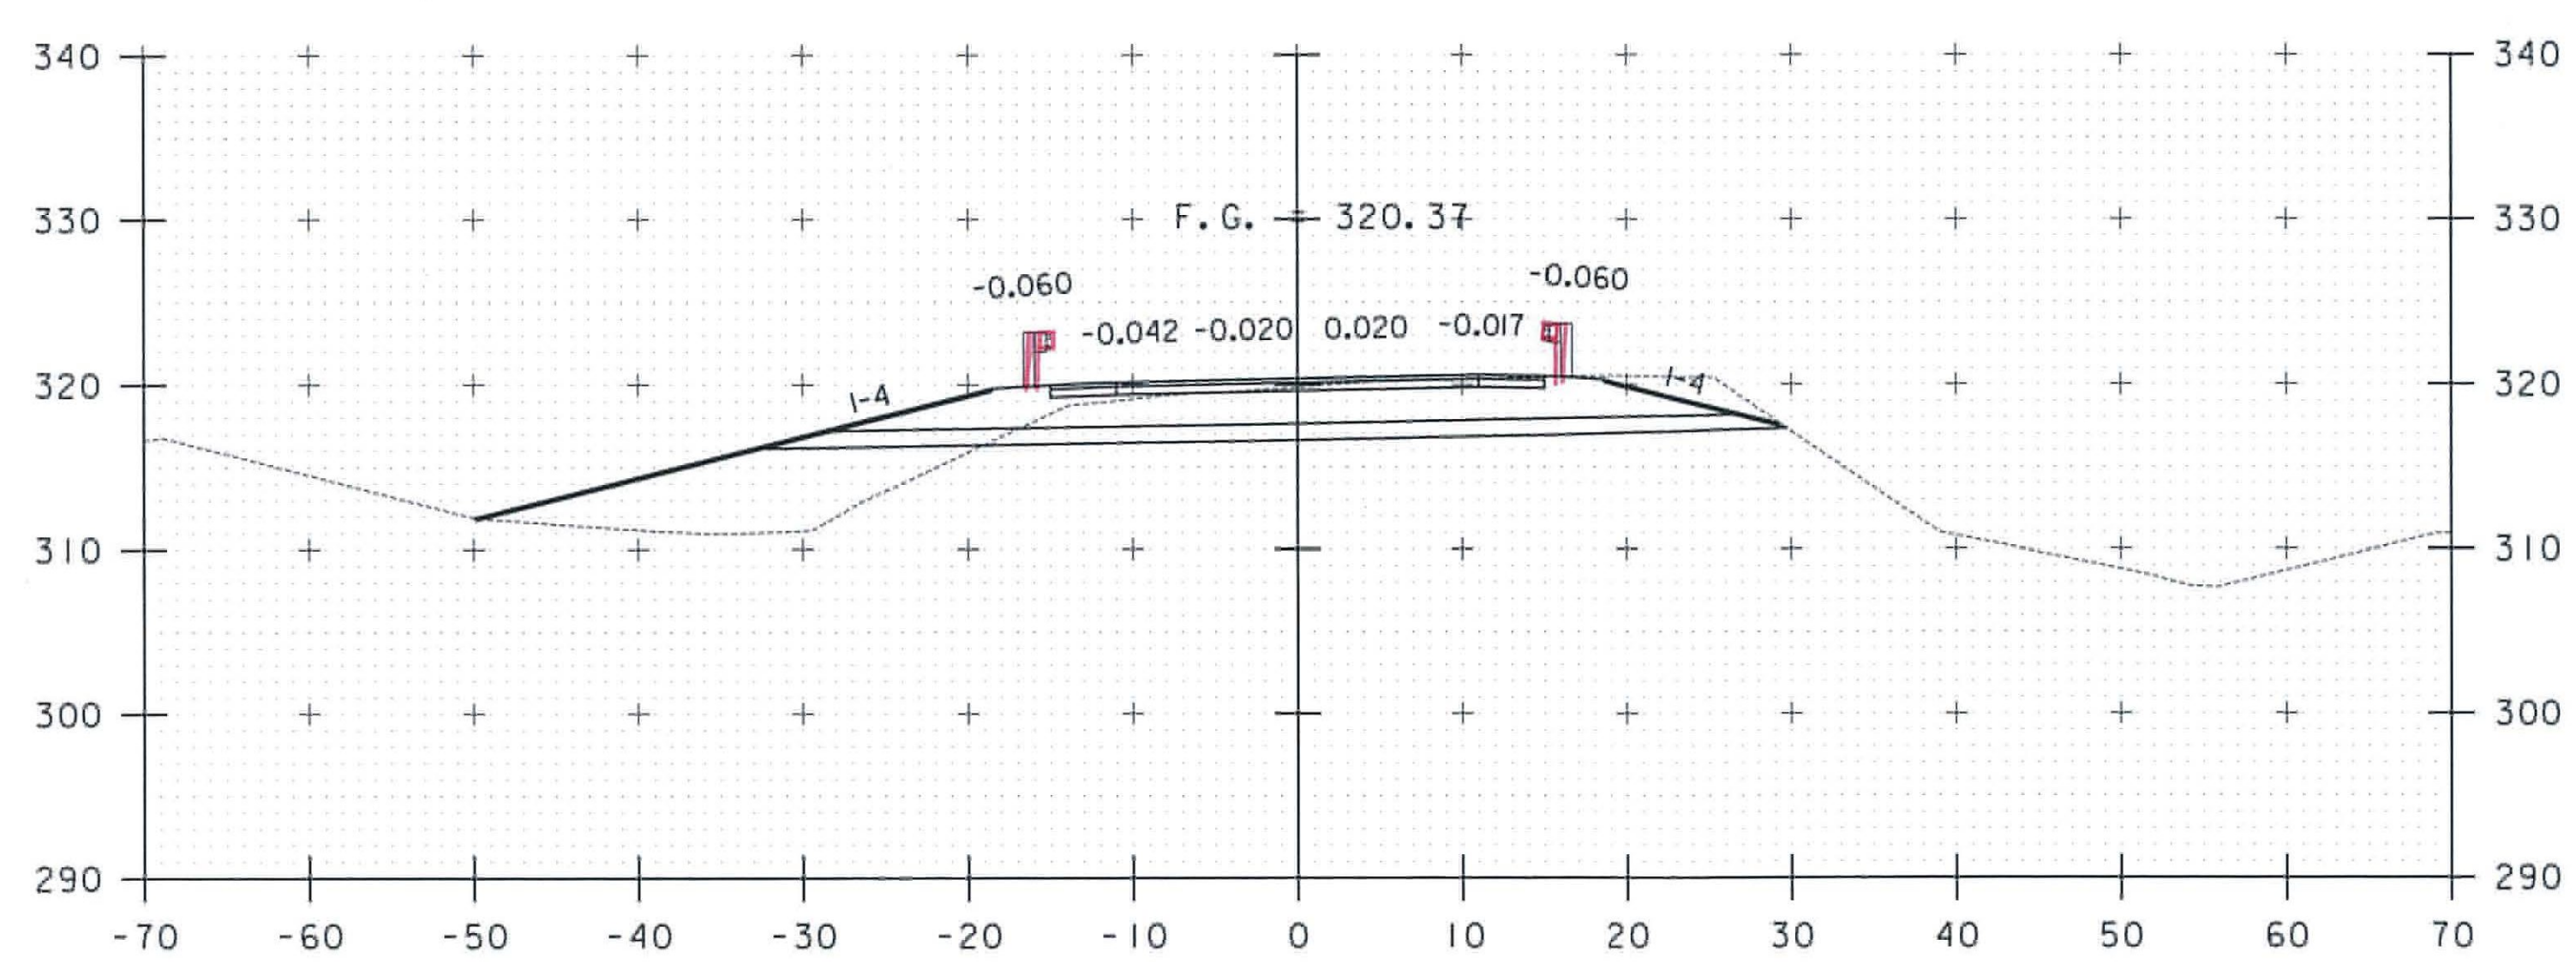

40+00

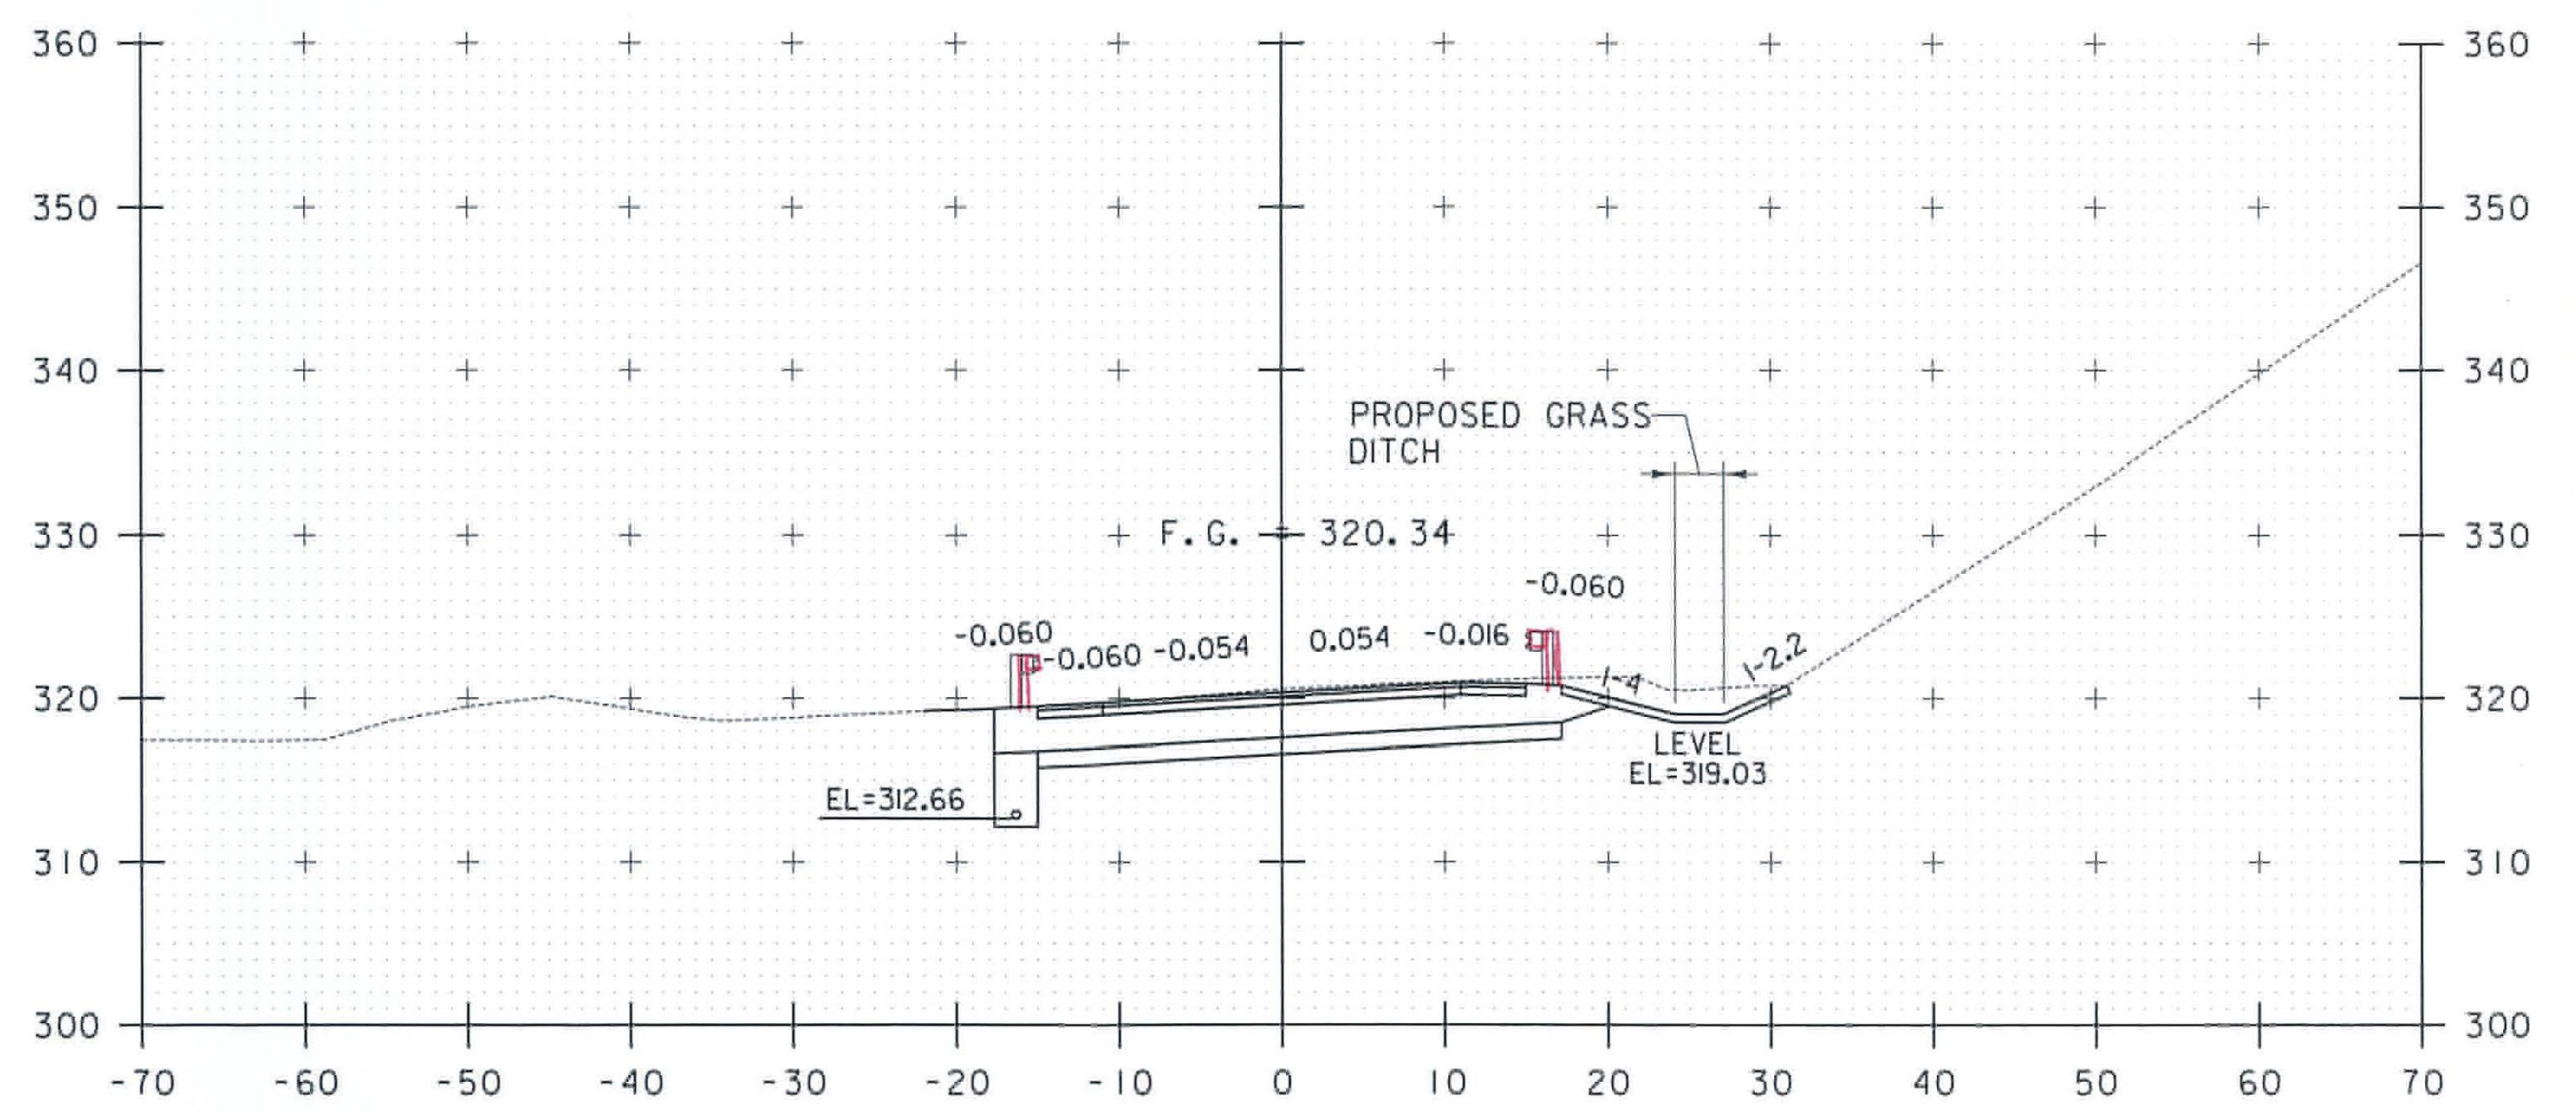

41+50

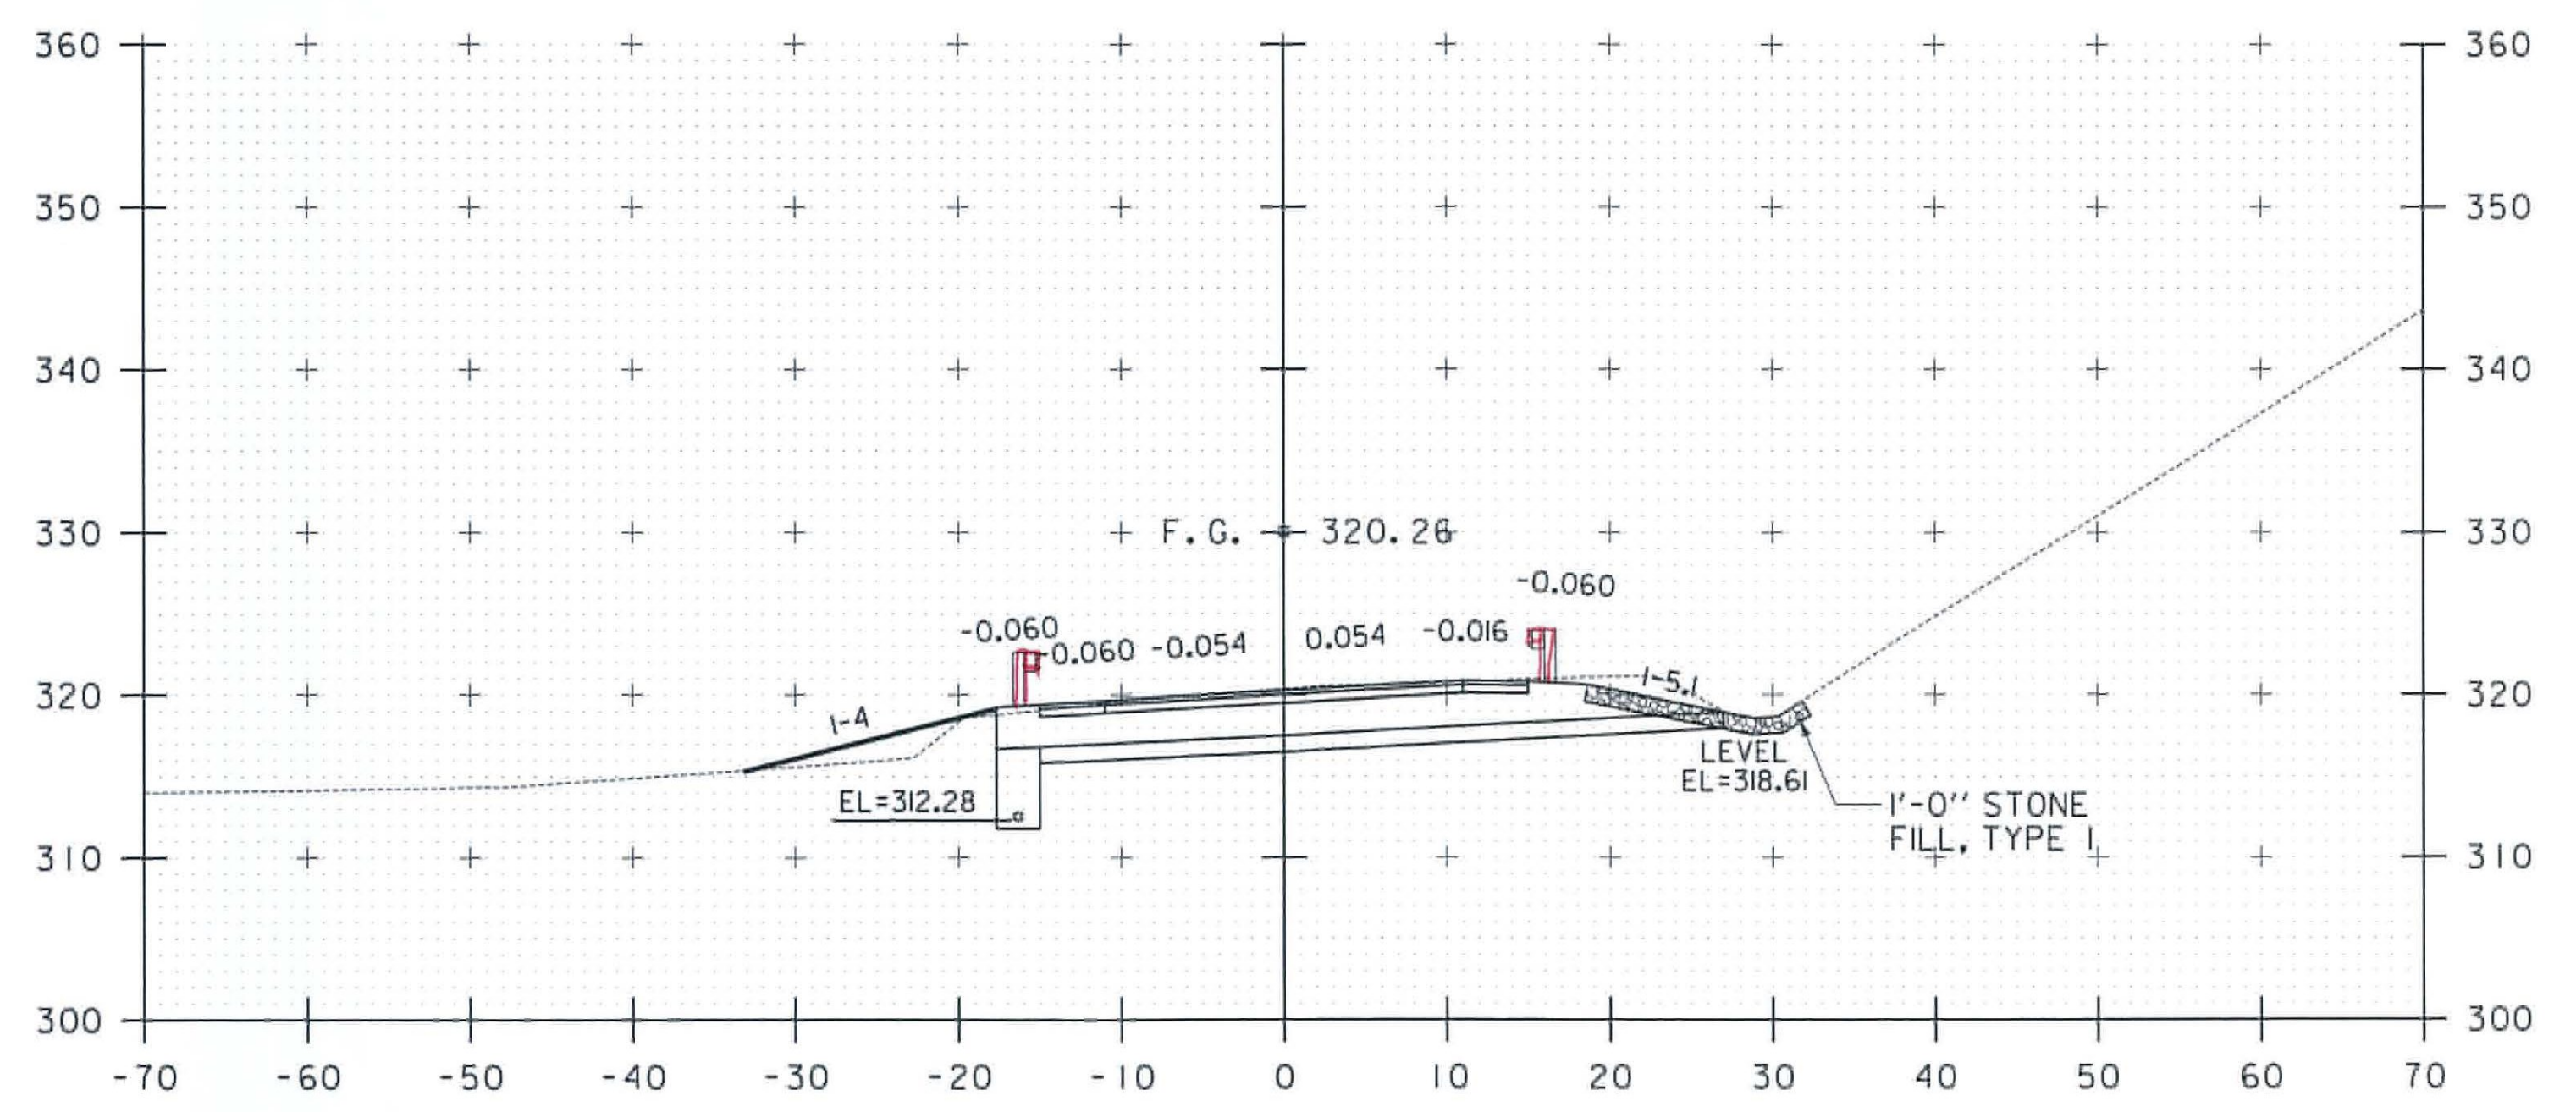

41+00

| | | | |
|---|----------|---|----------------------|
| X | Reviewed | — | Furnish As Corrected |
| | Rejected | — | Revise and Resubmit |

This review is only for general conformance with the design concept and the information given in the Construction Documents. Corrections or comments made on the shop drawings during the review do not release the Contractor from compliance with the requirements of the Plans and Specifications. Review of a specific area shall not include review of an assembly of which an item is a component. The Contractor is responsible for attention to be confirmed and corrected at the job site, information that pertains only to the fabrication process or to the means, methods, techniques, sequence and procedure of construction, coordination of the Work with that of other trades and performing all Work in a safe and satisfactory manner.

Date: August 31, 2011
 J. Santacruz



| | | |
|--------------------------------|----------------------------------|----------------------|
| CROSS SECTIONS SHEET #8 | PROJECT NAME: RICHMOND | PLOT DATE: 8/25/2011 |
| | PROJECT NUMBER: STP-RS 0284(III) | DRAWN BY: C.A.K. |
| | FILE NAME: z90c092_XSL14.dgn | CHECKED BY: D.E.G. |
| | DESIGNED BY: B.T.H. | SHEET 30 OF 46 |
| | DWG. NO.: XS-8 | |