


JB 124+00

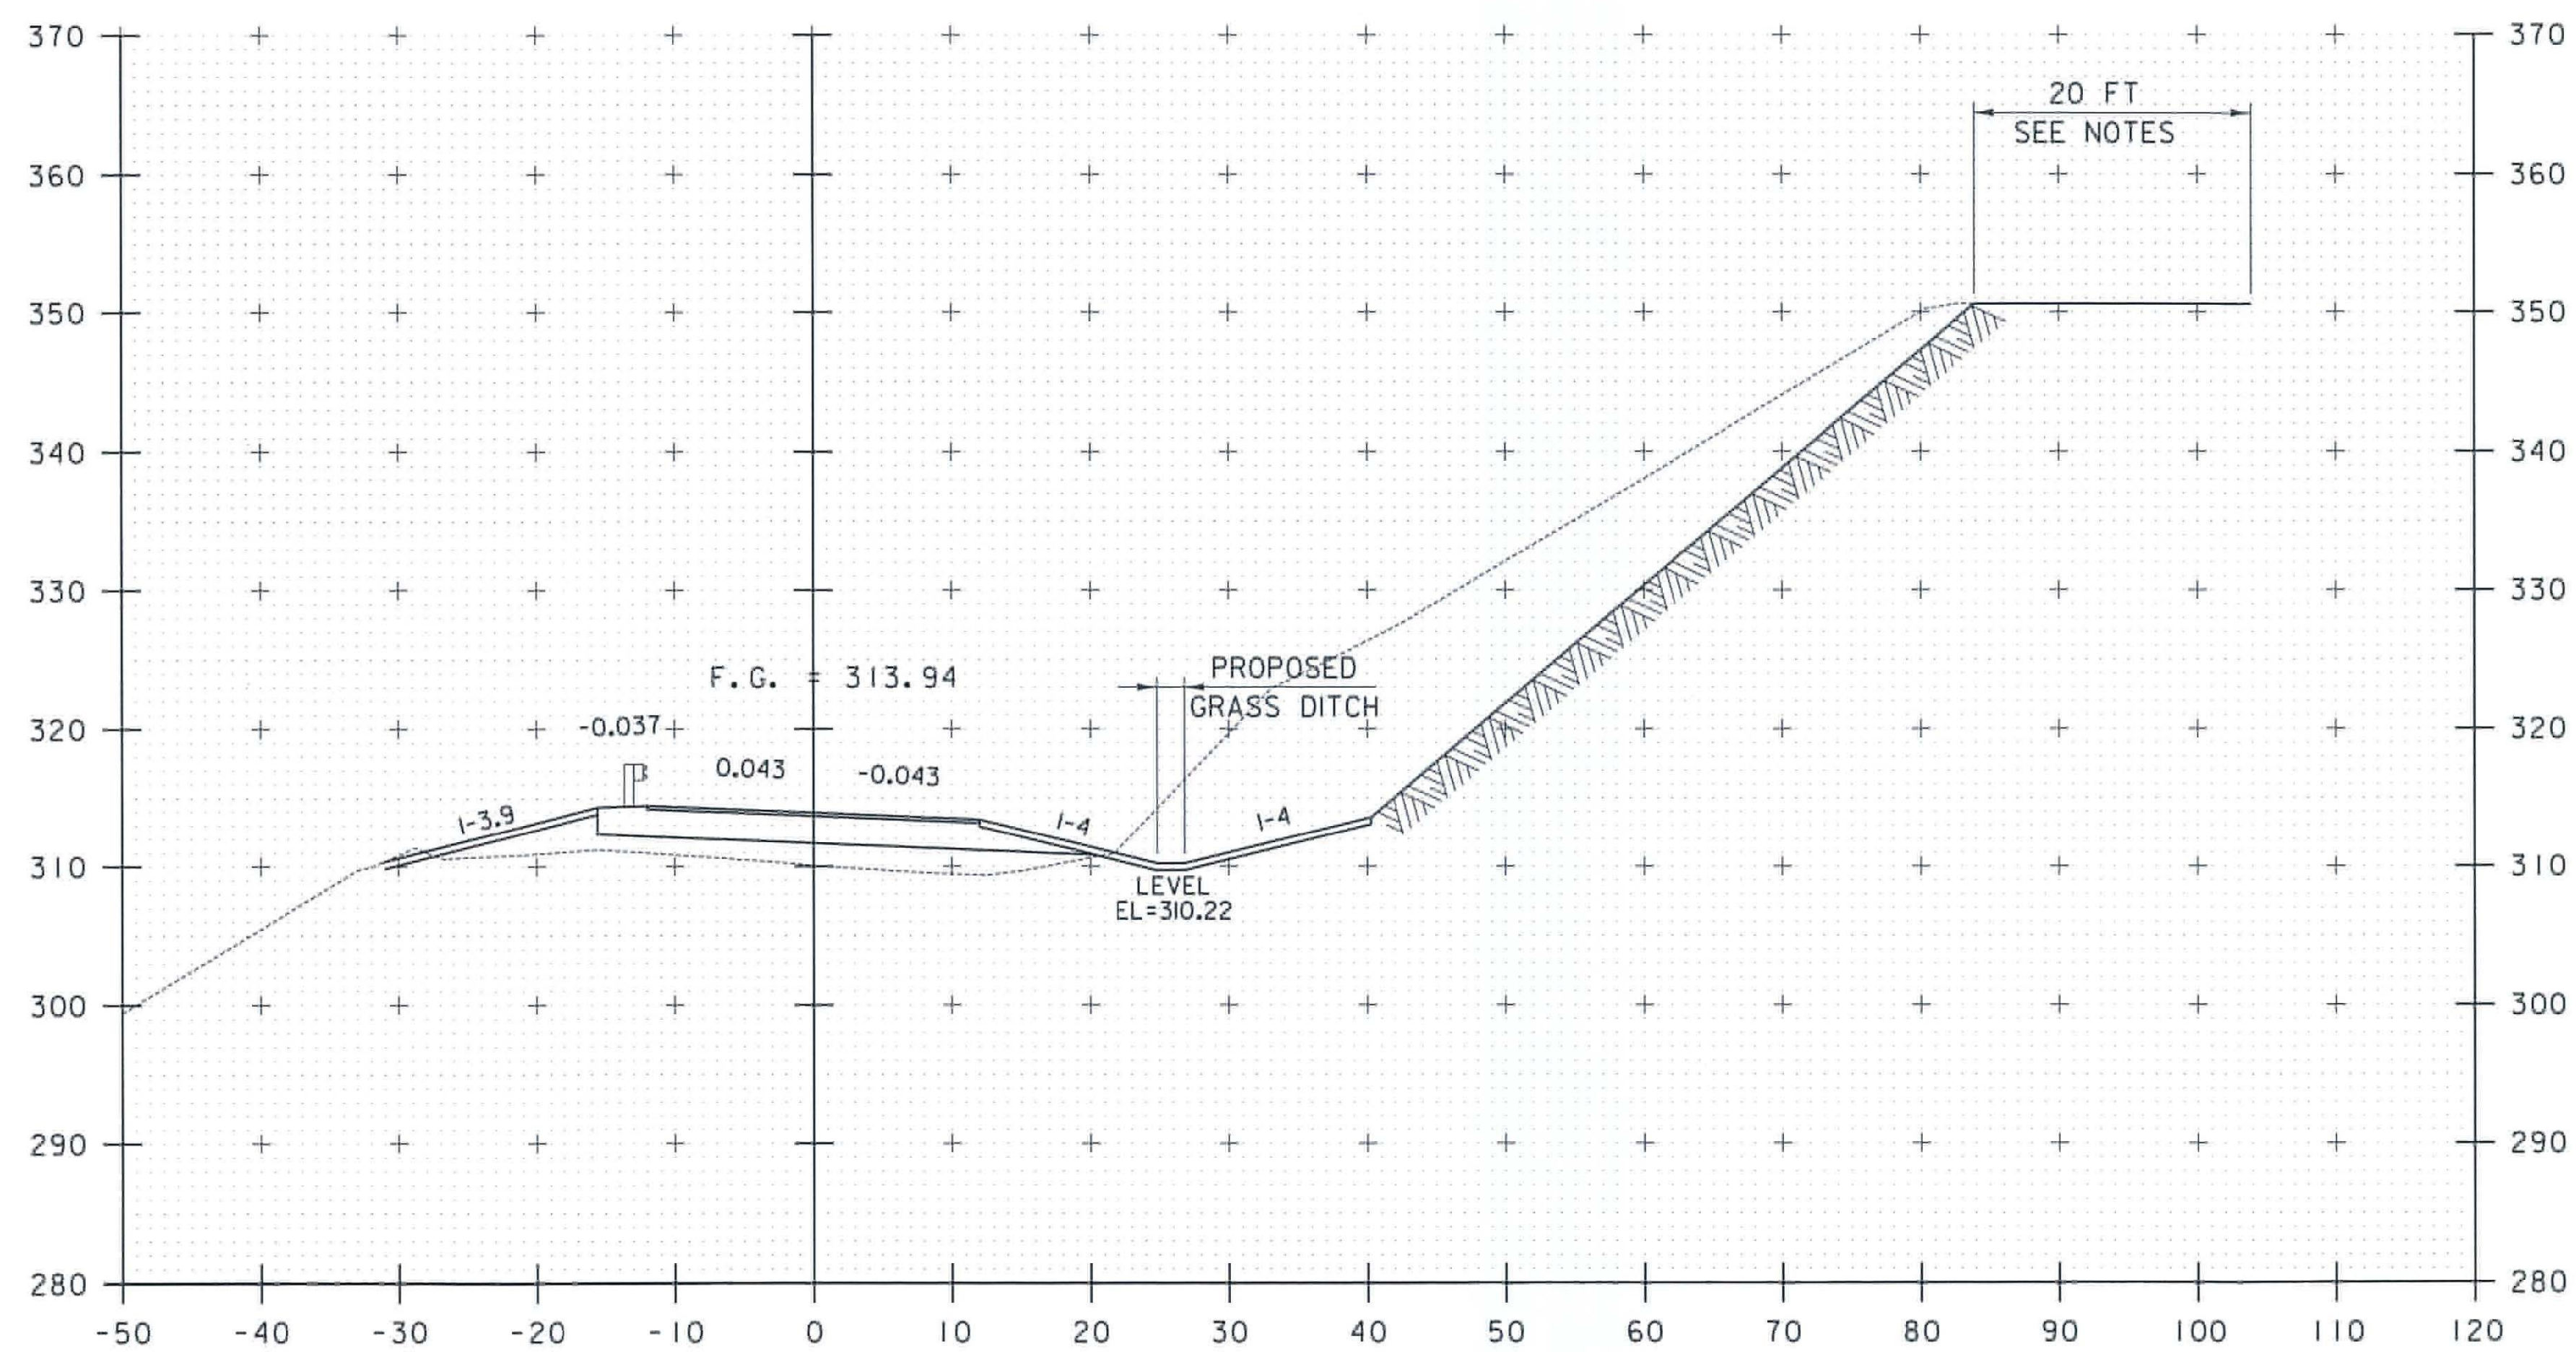

JB 123+50

NOTES:


1. REMOVE VEGETATION AND SOIL IN AN APPROXIMATELY 20 FOOT WIDE ZONE FROM THE TOP EDGE OF THE EXPOSED ROCK FACE.
2. BLEND SOIL CUT SLOPE INTO THE EXISTING SLOPE AT A SLOPE NO STEEPER THAN 1-2.
3. SCALE THE EXPOSED ROCK SURFACE TO REMOVE LOOSE AND WEATHERED PIECES OF ROCK, INCLUDING WITHIN THE 20 FOOT ZONE CLEARED OF VEGETATION AND SOIL OVERBURDEN.
4. STONE FILL BEGINS AT STA JB 123+75.

X	Reviewed	_____	Furnish As Corrected
_____	Rejected	_____	Revised and Resubmit
<small>This section is only for general information with the design contract and the information given to the Construction Department. Construction is complete made to the drawings shown during the review. Do not expect the Contractor from compliance with the requirements of the Plans and Specifications. Review of a specific task shall not include review of the overall project or any other task. The Contractor is responsible for all matters to be considered and corrected at the job site, information that pertains only to the information given on the plans, methods, equipment, materials, and procedures of construction, coordination of the work with that of other trades, and performing all work as a related construction item.</small>			
<small>McFarland Johnson</small> <small>August 23, 2011</small> <small>J. Santacruce</small>			

**CROSS SECTIONS SHEET #21**

PROJECT NAME: RICHMOND  
 PROJECT NUMBER: STP-RS 0284(III)  
 FILE NAME: z90c092.XSLI4.dgn  
 PROJECT LEADER: D.E.G.  
 DESIGNED BY: B.T.H.  
 DWG. NO.: XS-21

PLOT DATE: 8/25/2011  
 DRAWN BY: C.A.K.  
 CHECKED BY: D.E.G.  
 SHEET 43 OF 46

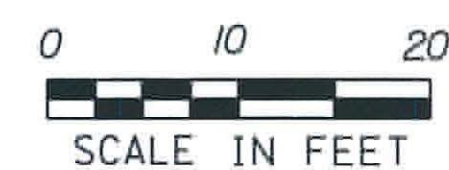

FILE NAME: v:\projects\enr\222075\cadd\instr\subs (1-14) roadway design\z90c092\_xsections\_johnnybrook\_14.dgn  
 DATE/TIME: 8/25/2011 10:00:00 AM  
 USER: J.SANTACRUCE