


FILE NAME = v:\projects\enr\222876\cadd\mstr\ubs (1-17)\trans management\290c092\_CS\_02\_17.dgn  
 DATE/TIME = 4/14/2011  
 USER = 3066

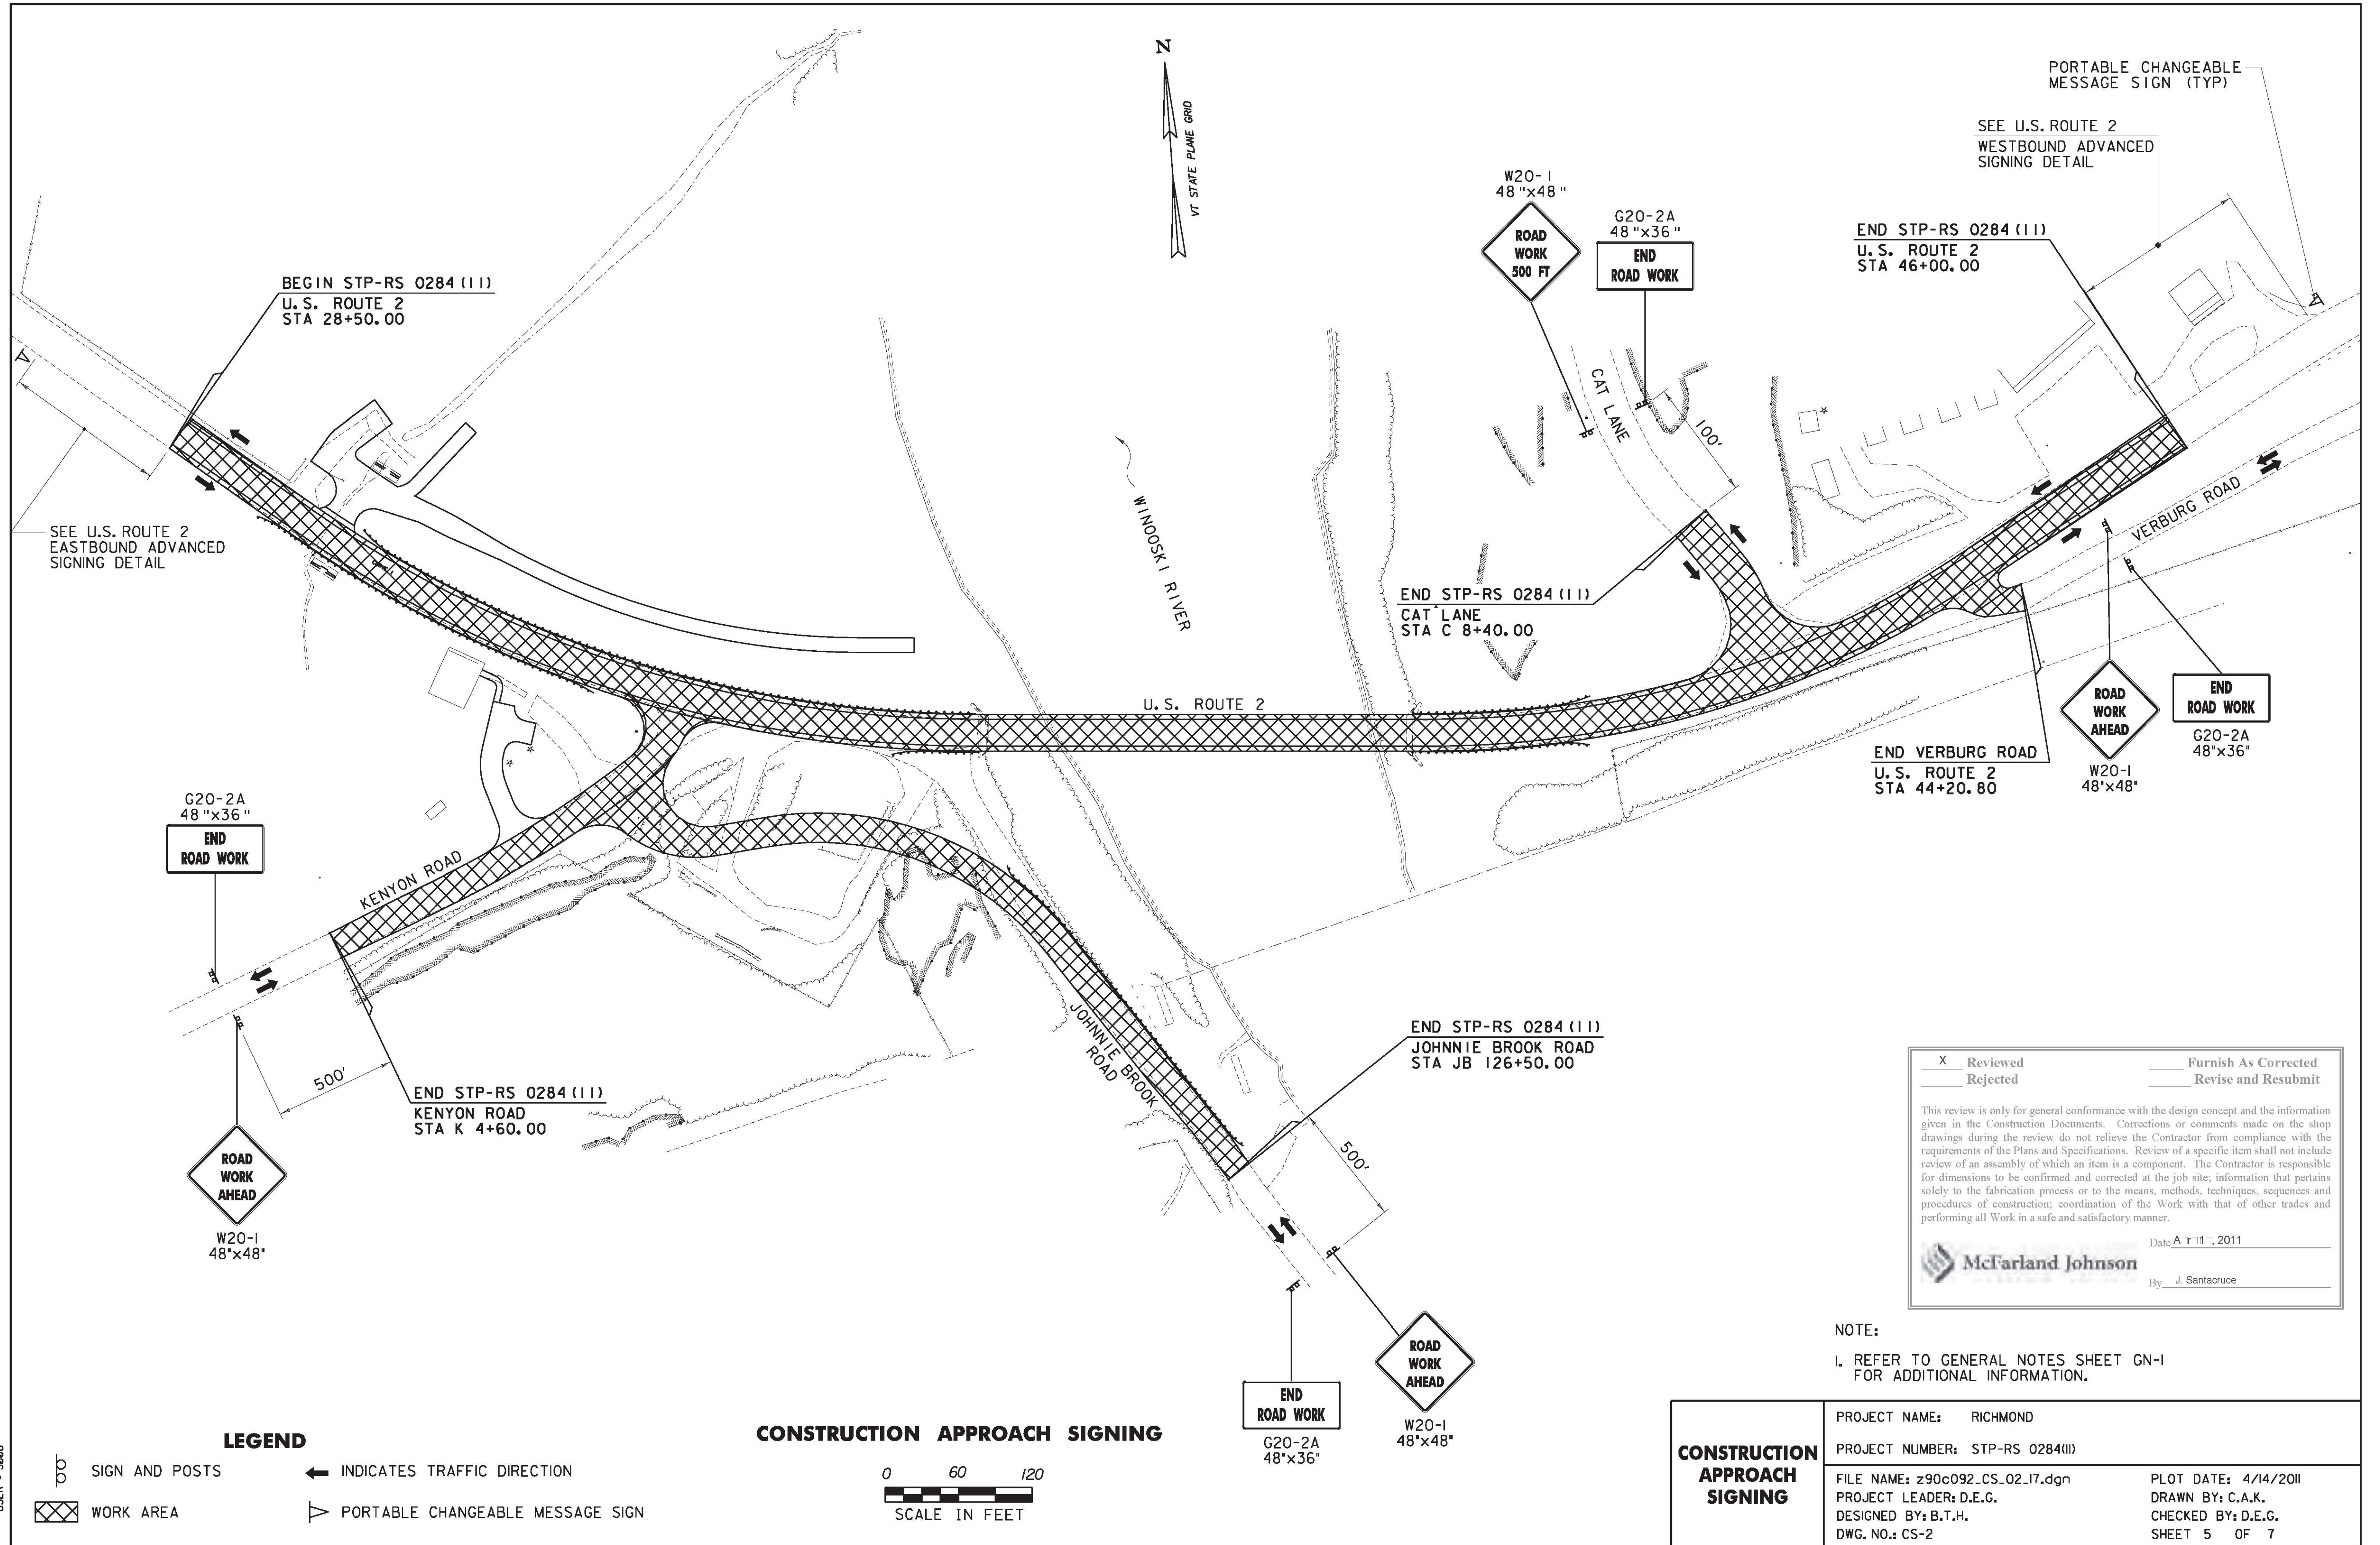

**LEGEND**

SIGN AND POSTS  
 WORK AREA  
 INDICATES TRAFFIC DIRECTION  
 PORTABLE CHANGEABLE MESSAGE SIGN

**CONSTRUCTION APPROACH SIGNING**

0 60 120  
 SCALE IN FEET

<input checked="" type="checkbox"/> Reviewed	<input type="checkbox"/> Furnish As Corrected
<input type="checkbox"/> Rejected	<input type="checkbox"/> Revise and Resubmit

This review is only for general conformance with the design concept and the information given in the Construction Documents. Corrections or comments made on the shop drawings during the review do not relieve the Contractor from compliance with the requirements of the Plans and Specifications. Review of a specific item shall not include review of an assembly of which an item is a component. The Contractor is responsible for dimensions to be confirmed and corrected at the job site; information that pertains solely to the fabrication process or to the means, methods, techniques, sequences and procedures of construction; coordination of the Work with that of other trades and performing all Work in a safe and satisfactory manner.

Date: April 14, 2011  
 By: J. Santacruce

NOTE:  
 1. REFER TO GENERAL NOTES SHEET GN-1 FOR ADDITIONAL INFORMATION.

<b>CONSTRUCTION APPROACH SIGNING</b>	PROJECT NAME: RICHMOND	PLOT DATE: 4/14/2011
	PROJECT NUMBER: STP-RS 0284(11)	DRAWN BY: C.A.K.
	FILE NAME: z90c092_CS_02_17.dgn	CHECKED BY: D.E.G.
	PROJECT LEADER: D.E.G. DESIGNED BY: B.T.H. DWG. NO.: CS-2	SHEET 5 OF 7