



FILE NAME = V:\Projects\2009\22076\CAOD\INST\MS 1-131\DETOUR\22076.prj.dgn  
 DATE/TIME = 6/17/2011  
 USER = 3086

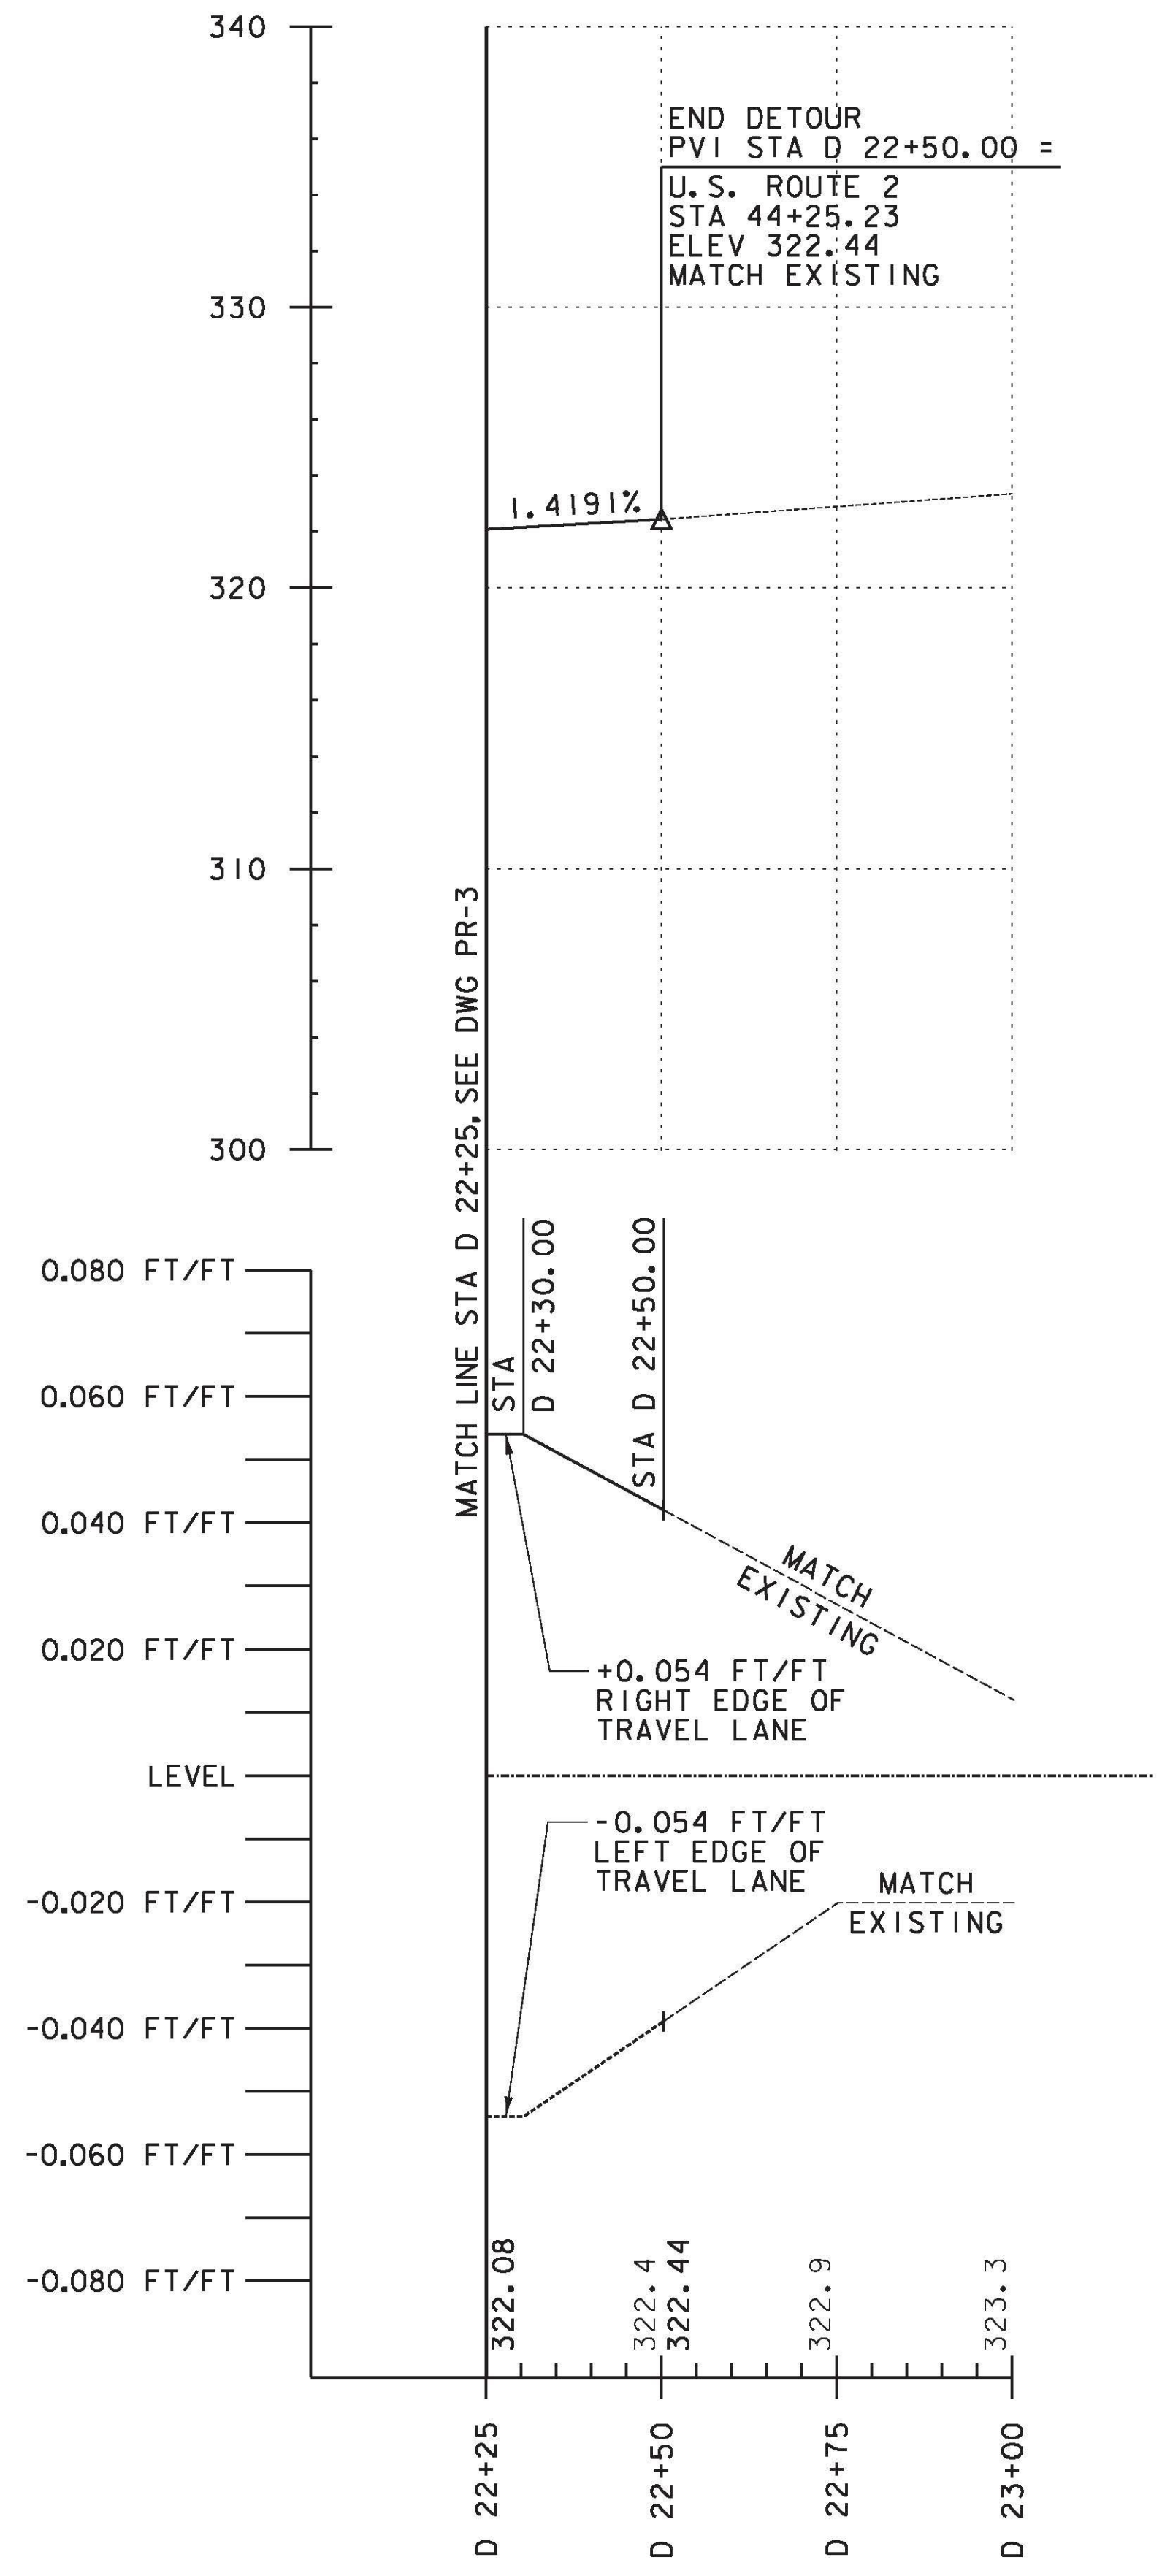

**U.S. ROUTE 2 DETOUR**

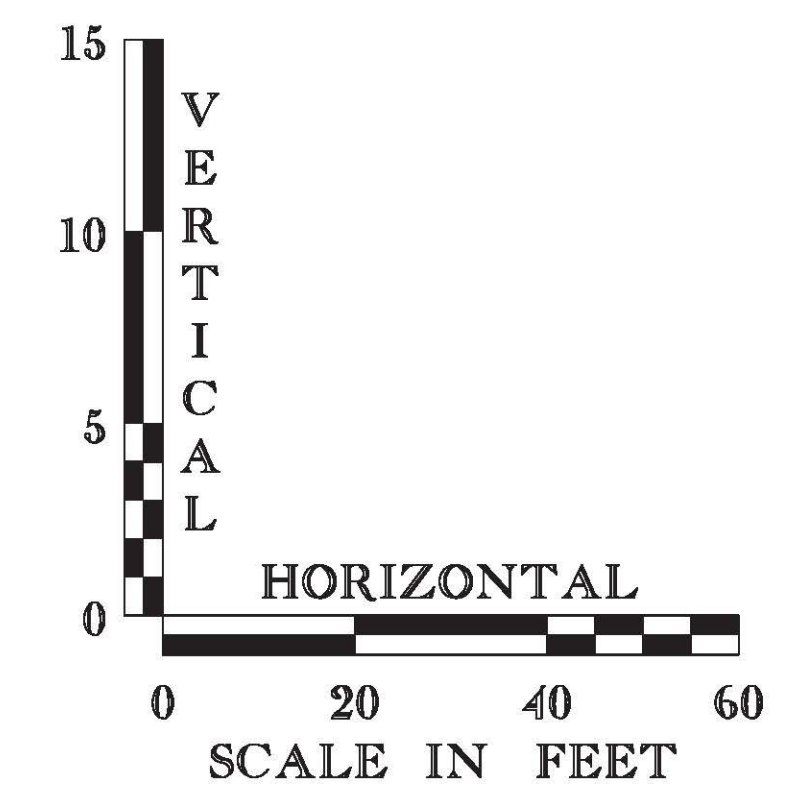

|                         |                                  |                      |
|-------------------------|----------------------------------|----------------------|
| <b>PROFILE SHEET #4</b> | PROJECT NAME: RICHMOND           |                      |
|                         | PROJECT NUMBER: STP-RS 0284(III) |                      |
|                         | FILE NAME: z90c092_prj_04_13.dgn | PLOT DATE: 6/17/2011 |
|                         | PROJECT LEADER: D.E.G.           | DRAWN BY: C.A.K.     |
|                         | DESIGNED BY: B.T.H.              | CHECKED BY: D.E.G.   |
|                         | DWG. NO.: PR-4                   | SHEET 12 OF 29       |