




FILE NAME = V:\P\Projects\2008\22076\CAOD\INSTN\MS-1-131 DETOUR\X90c092_xsl13.dgn
 DATE/TIME = 6/17/2011
 USER = 3086

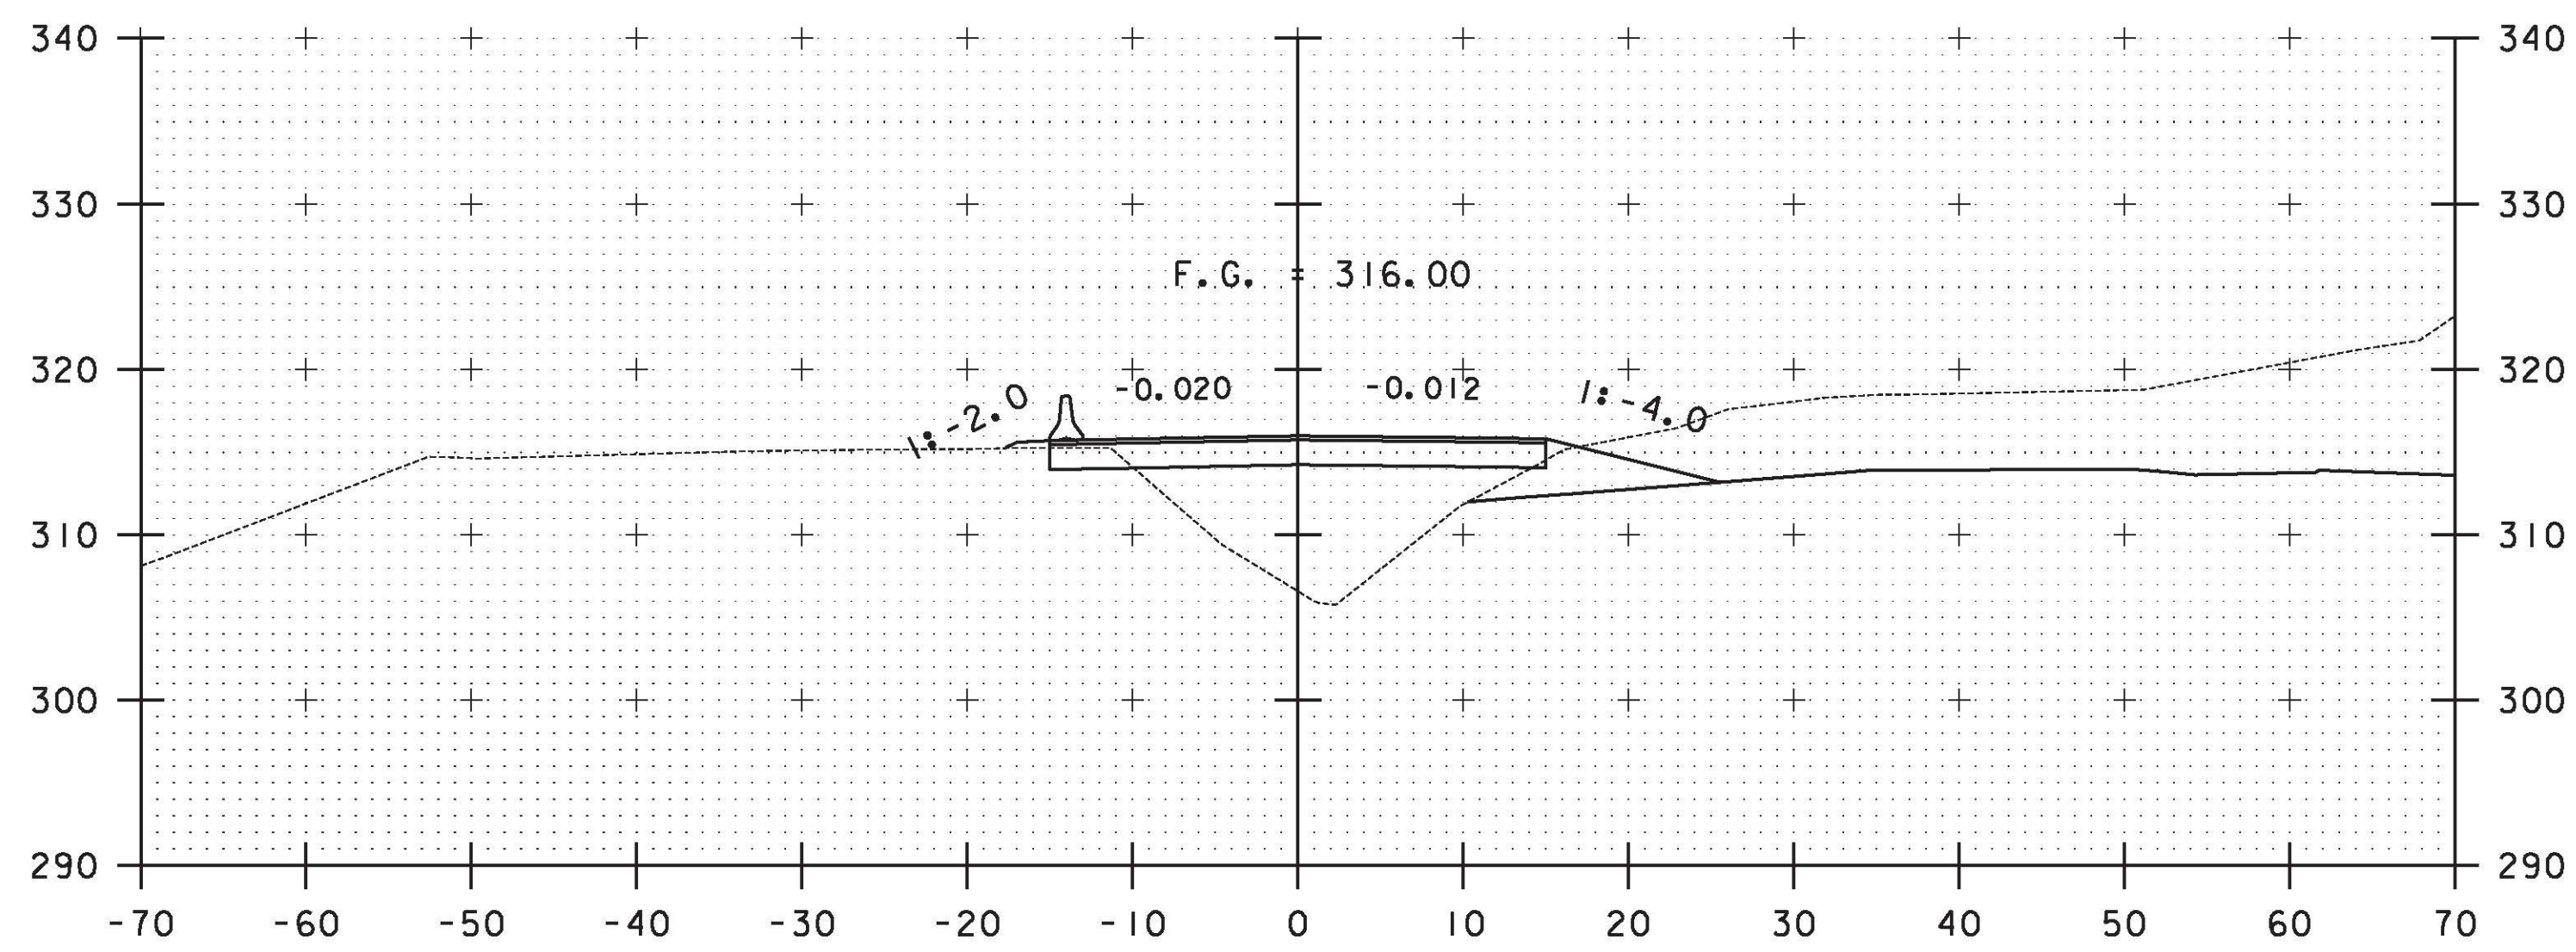


D 11+50

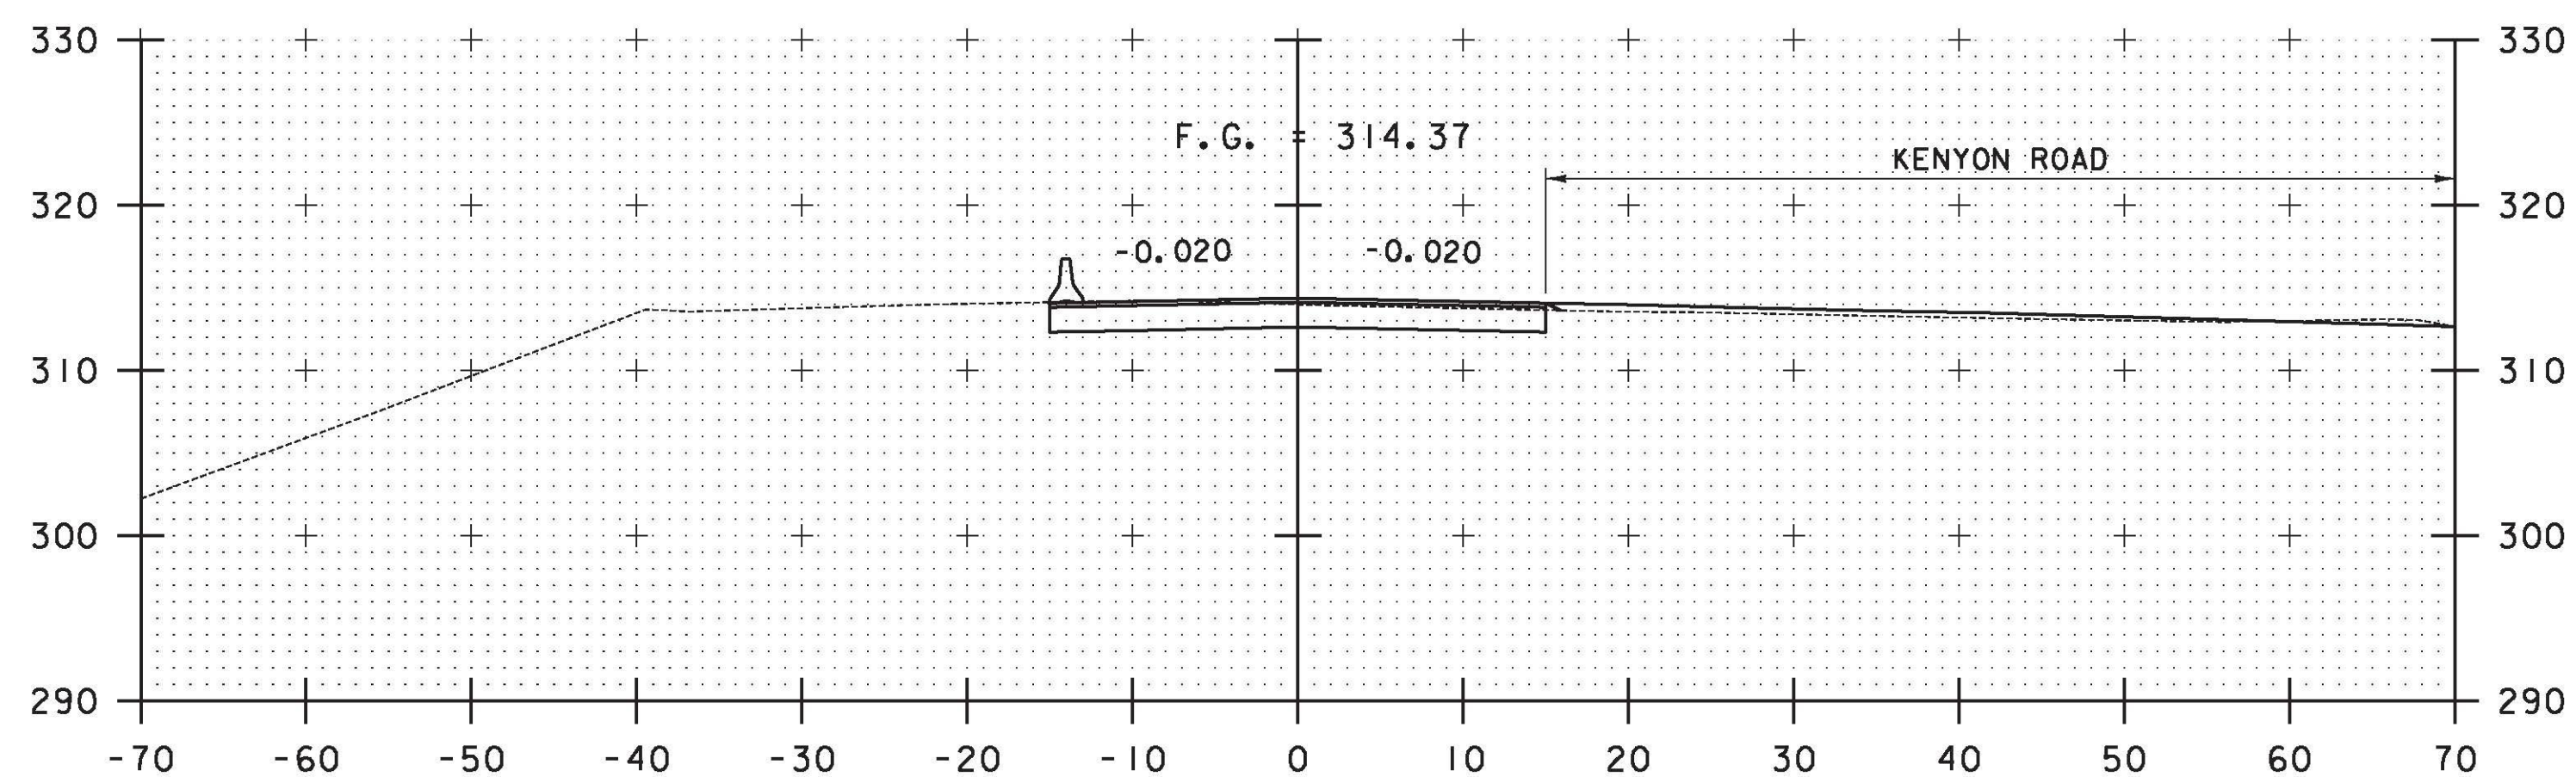


D 11+00

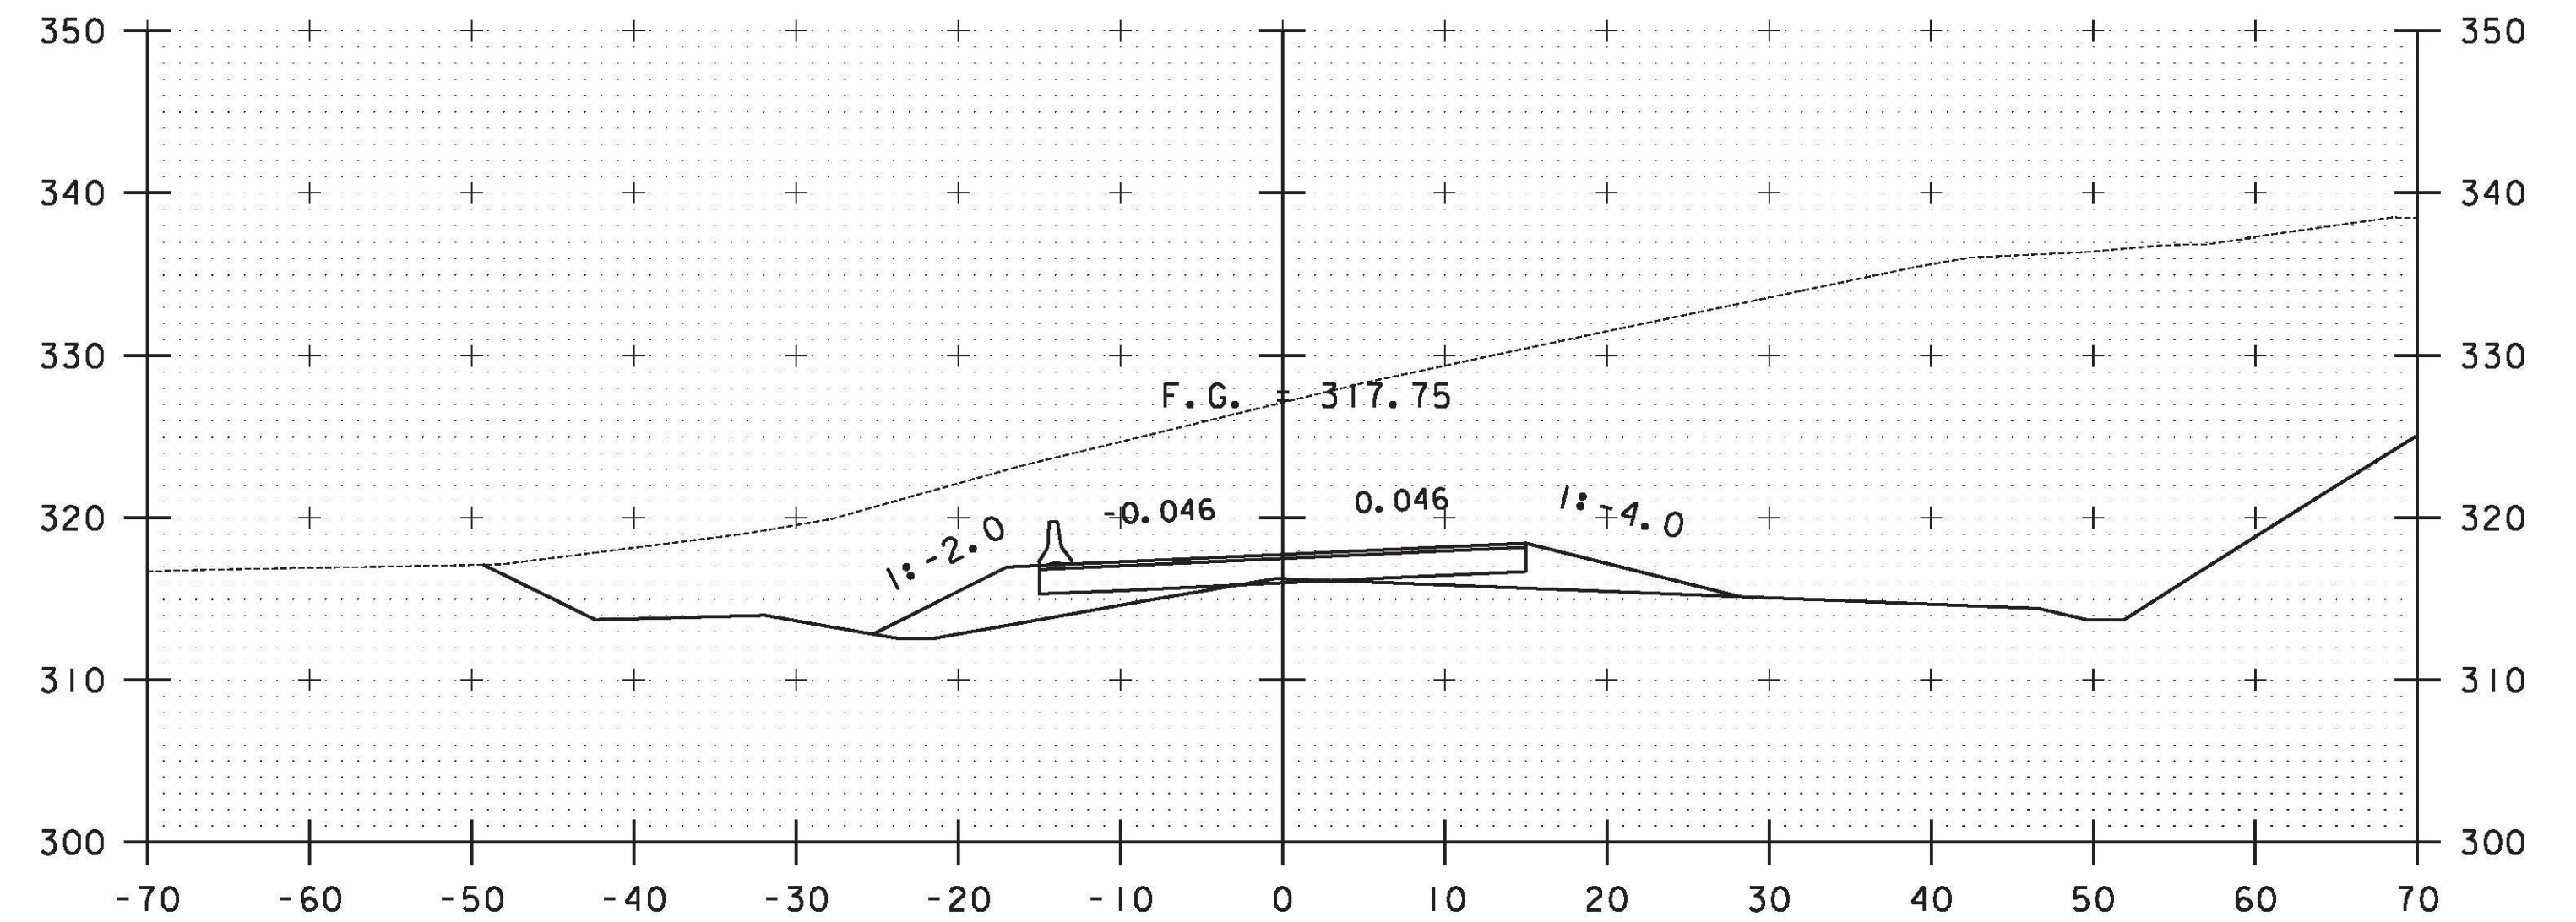

D 12+50

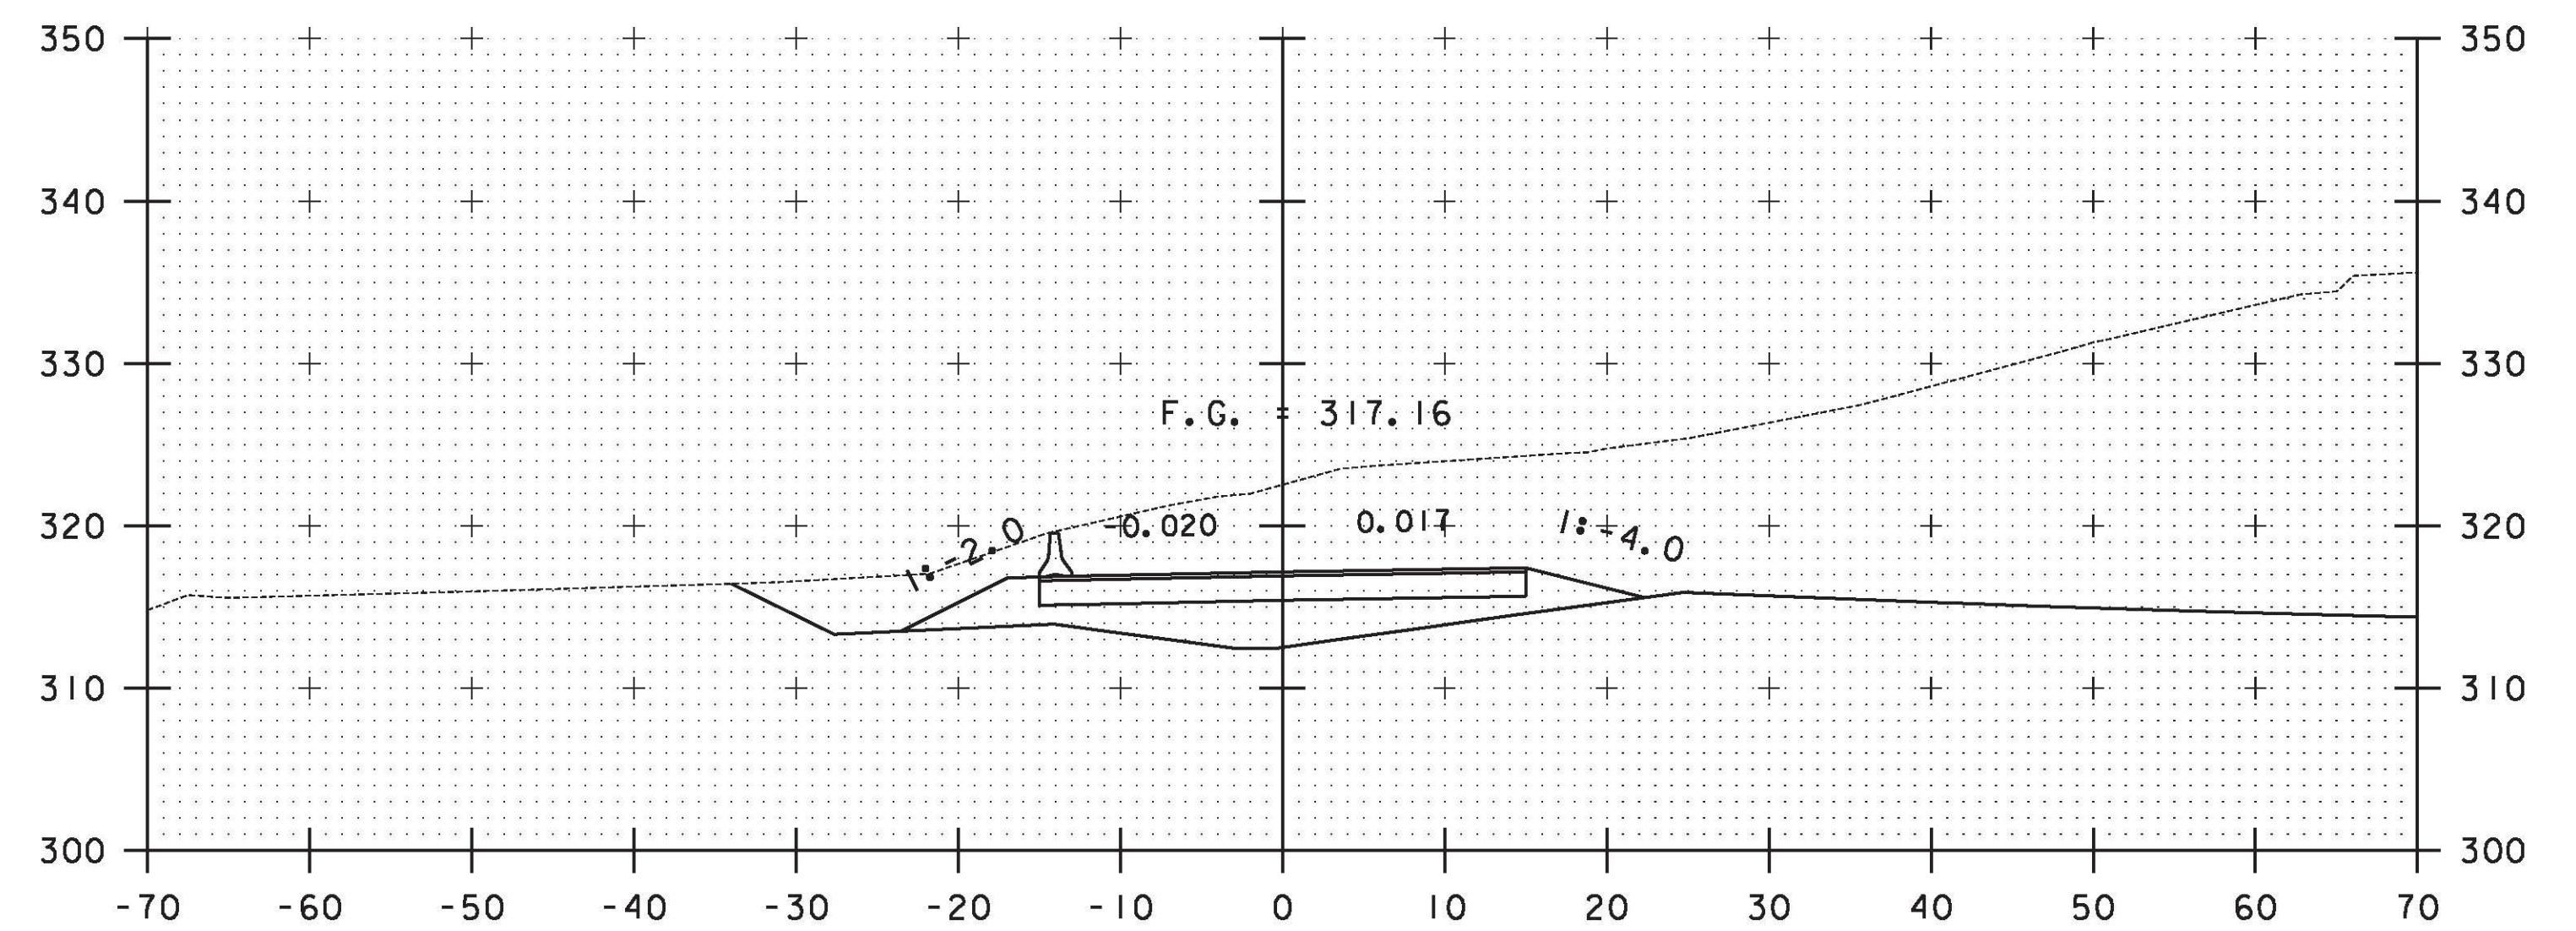

D 12+00

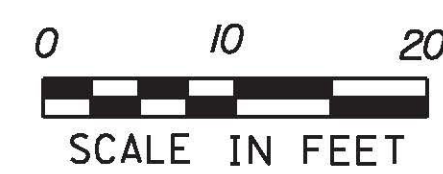

CROSS SECTIONS SHEET #2

PROJECT NAME: RICHMOND
 PROJECT NUMBER: STP-RS 0284(III)
 FILE NAME: z90c092_XSL13.dgn
 PROJECT LEADER: D.E.G.
 DESIGNED BY: B.T.H.
 DWG. NO.: XS-2

PLOT DATE: 6/17/2011
 DRAWN BY: C.A.K.
 CHECKED BY: D.E.G.
 SHEET 21 OF 29