


D 15+00

D 16+00

FILE NAME = V:\P\Projects\A\NY\K2\22076\CAOD\JSTN\WBS 01-131 DETOUR\XSL\13.dgn
DATE/TIME = 6/17/2011
USER = 3086

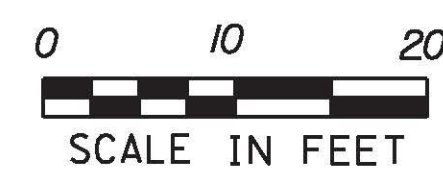

CROSS SECTIONS SHEET #4

PROJECT NAME: RICHMOND
PROJECT NUMBER: STP-RS 0284(III)
FILE NAME: z90c092_XSL13.dgn
PROJECT LEADER: D.E.G.
DESIGNED BY: B.T.H.
DWG. NO.: XS-4

PLOT DATE: 6/17/2011
DRAWN BY: C.A.K.
CHECKED BY: D.E.G.
SHEET 23 OF 29