




FILE NAME = V:\P\Projects\2007\2075\CAOD\MSTN\MS-1-131 DETOUR\X90c092_xsl13.dgn
 DATE/TIME = 6/17/2011
 USER = 3086

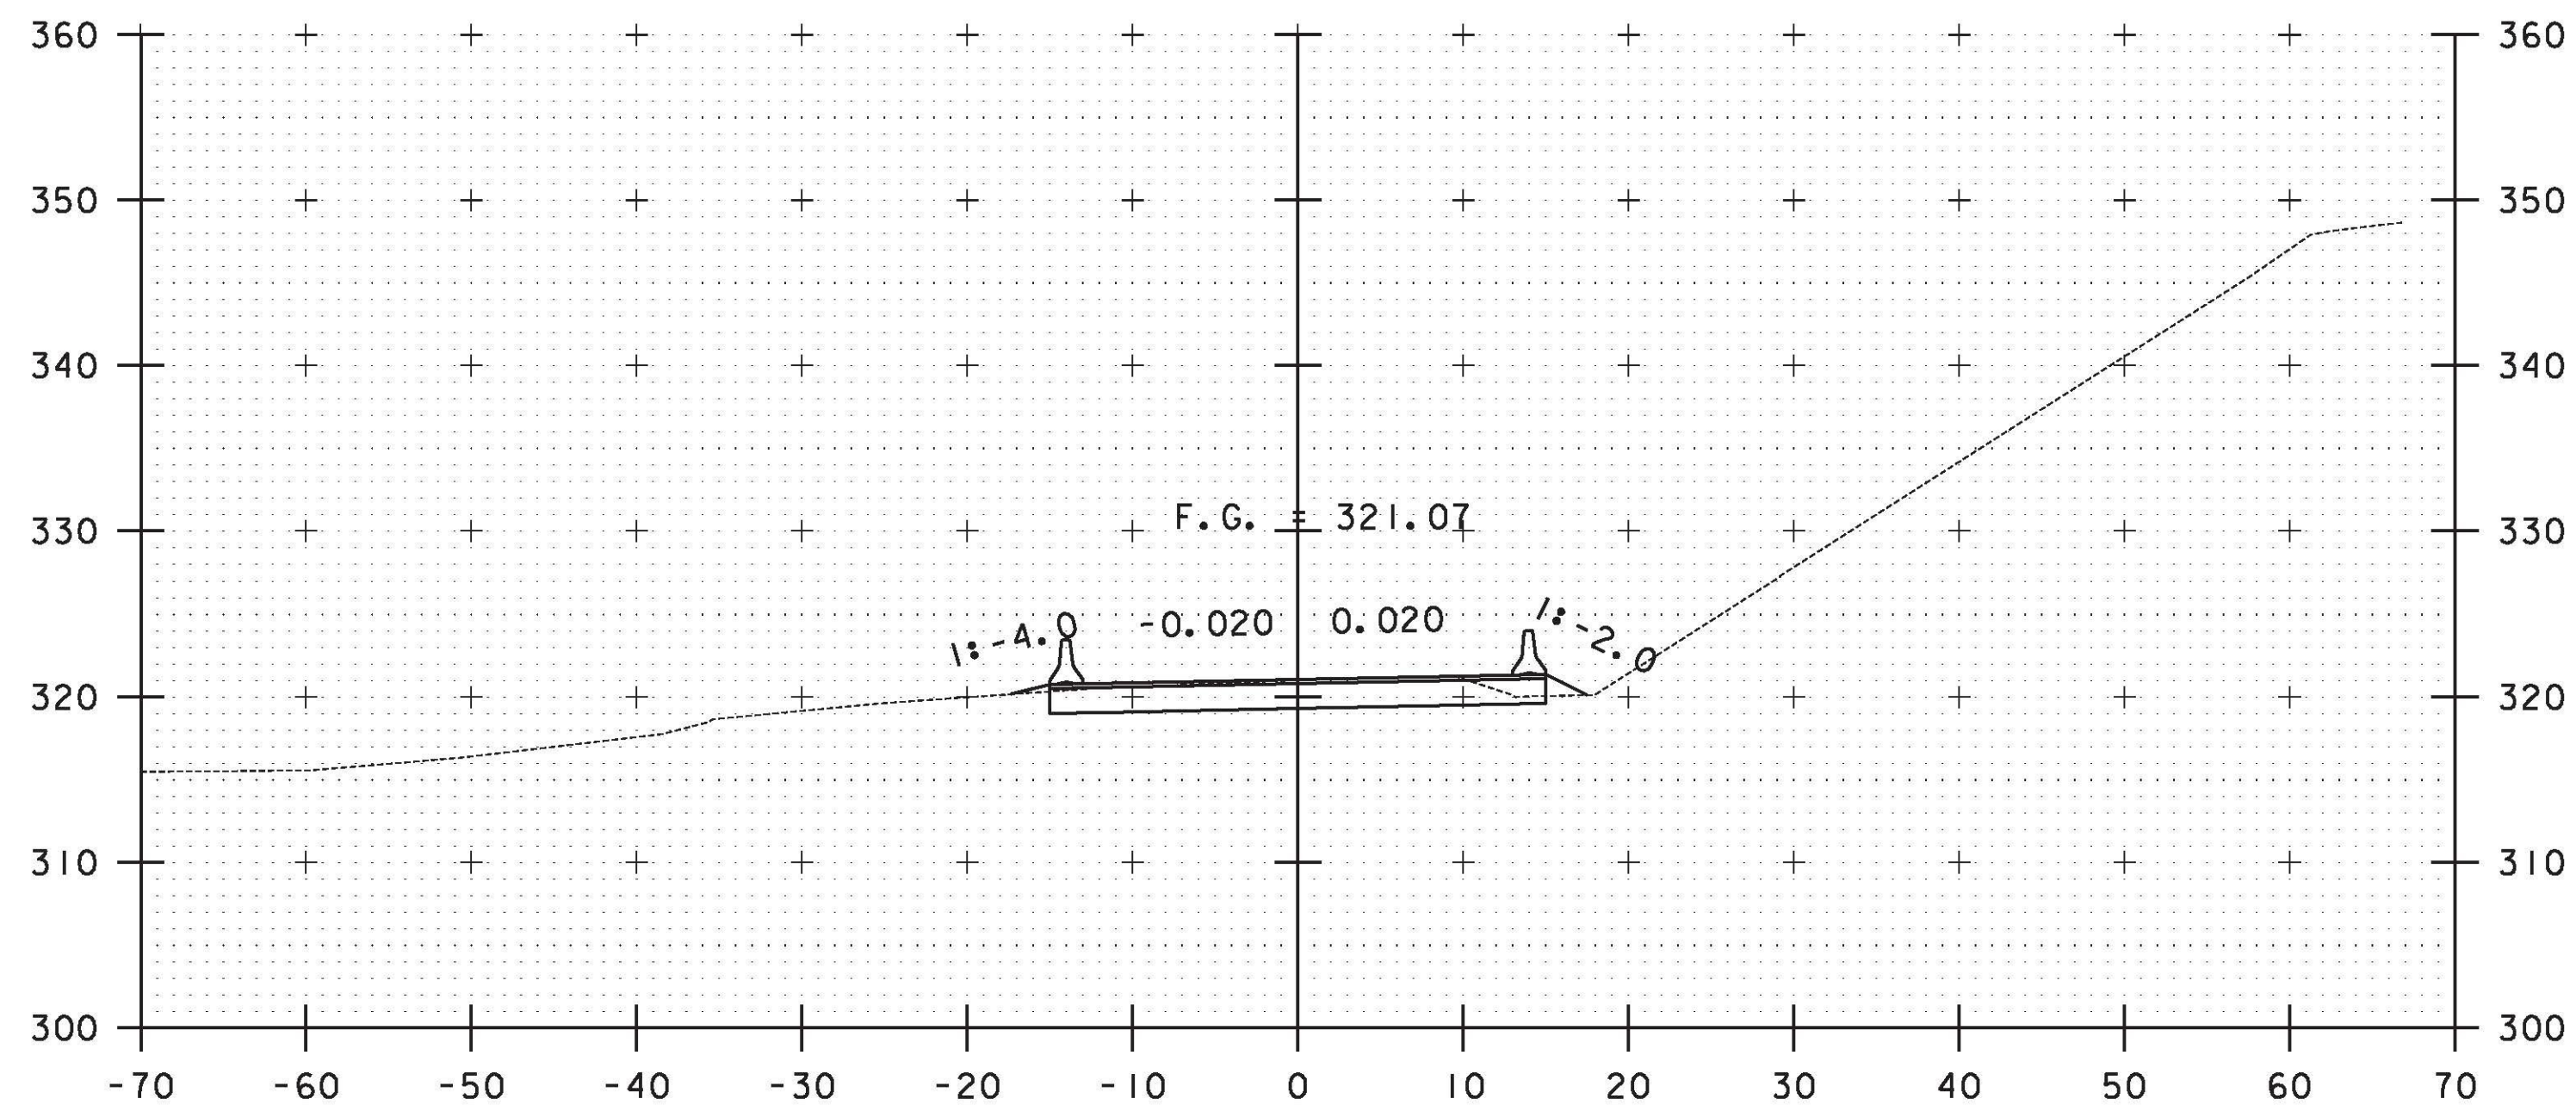


D 19+50

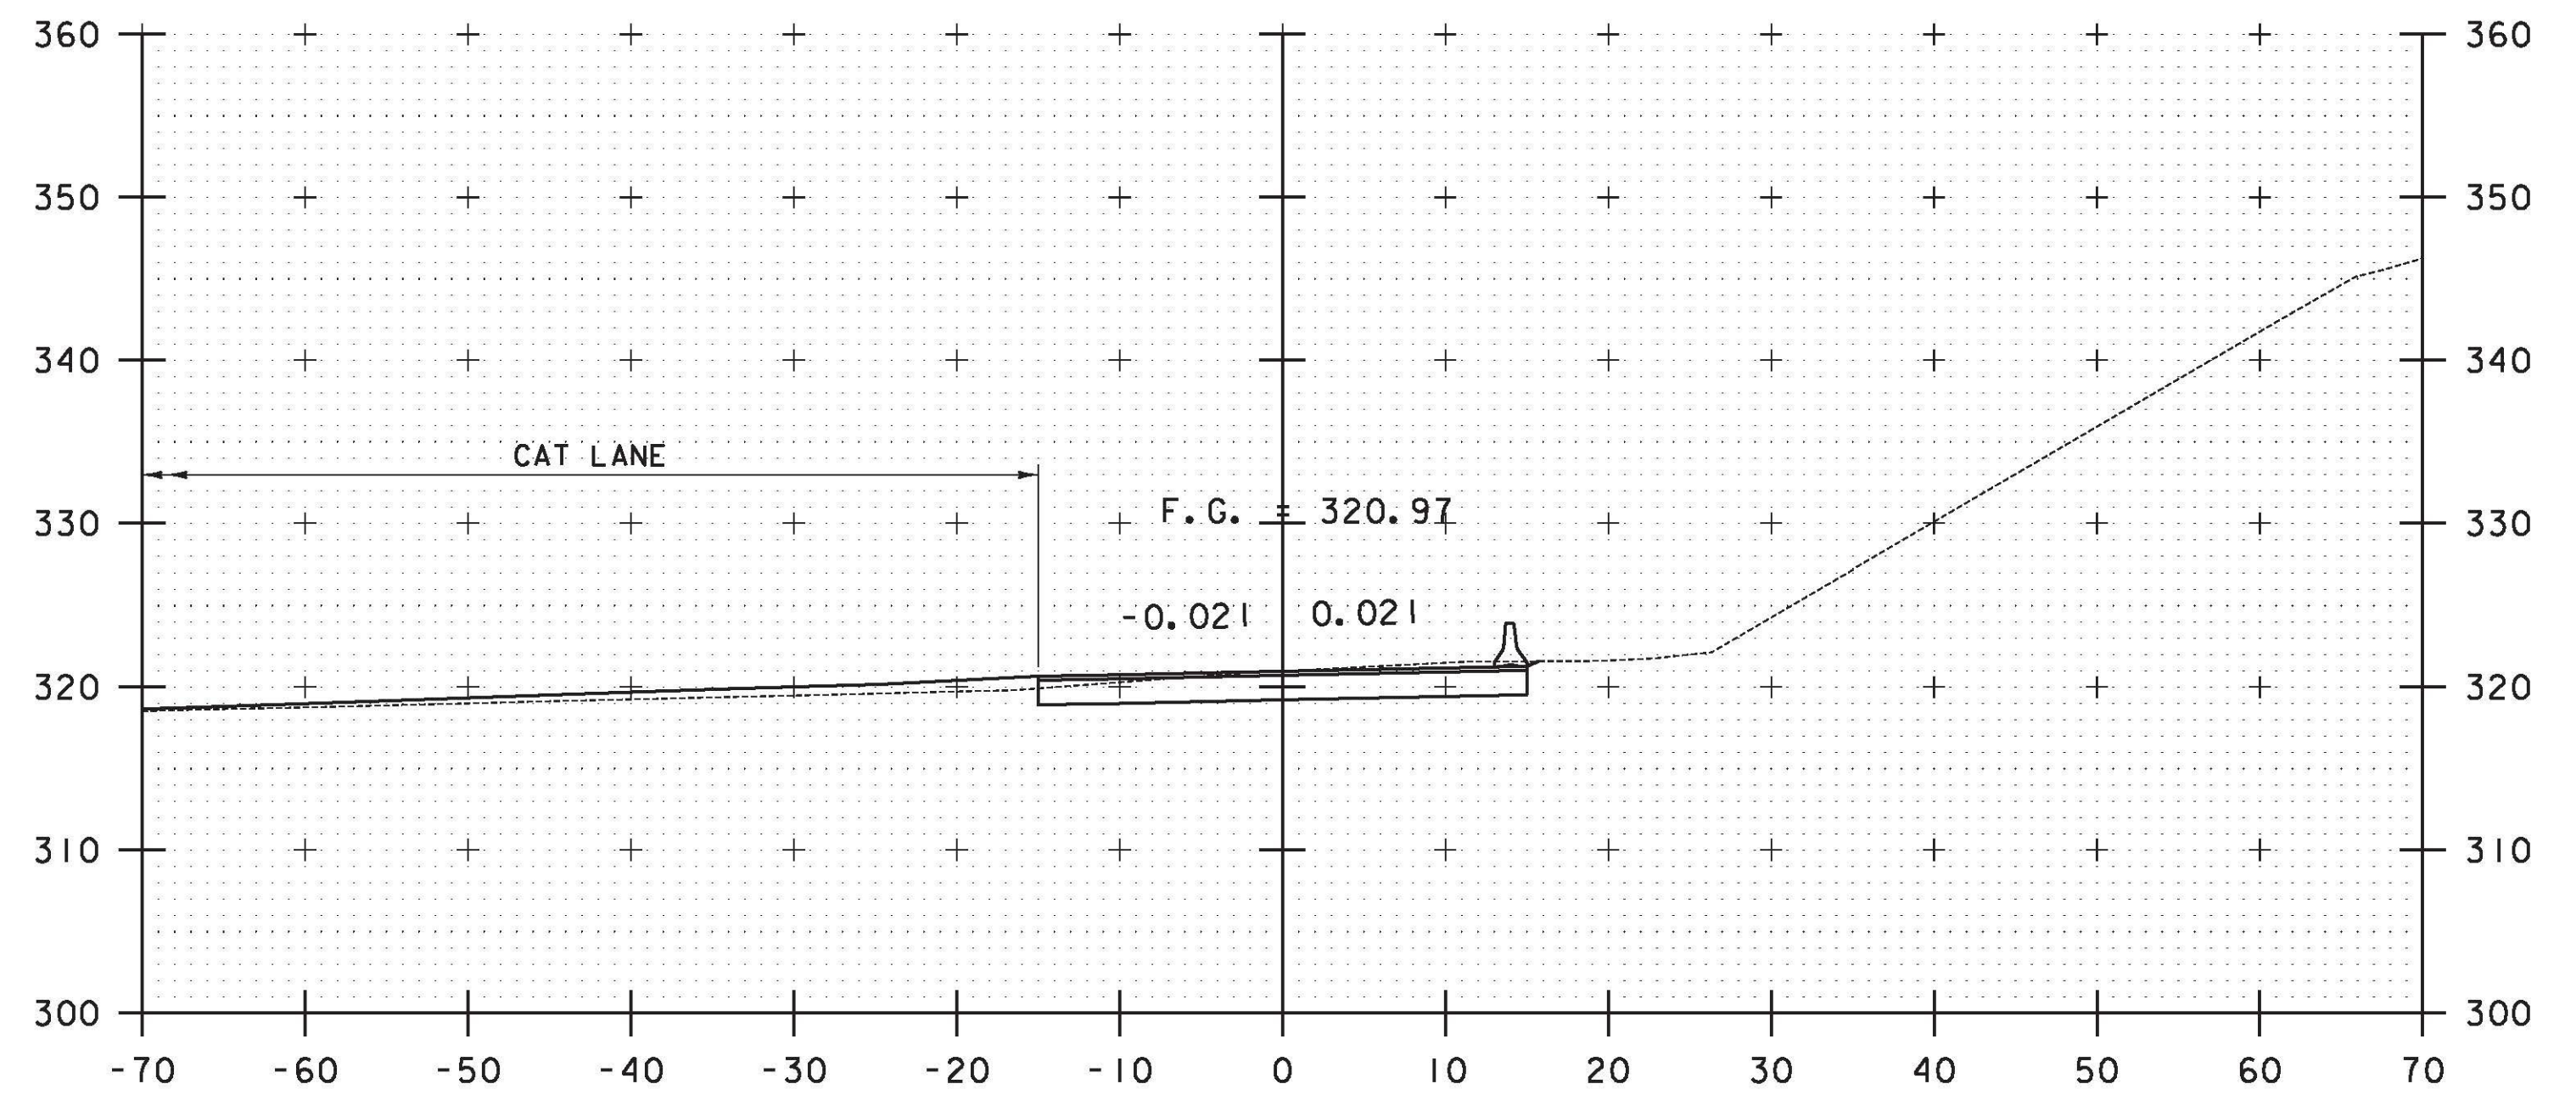


D 20+50

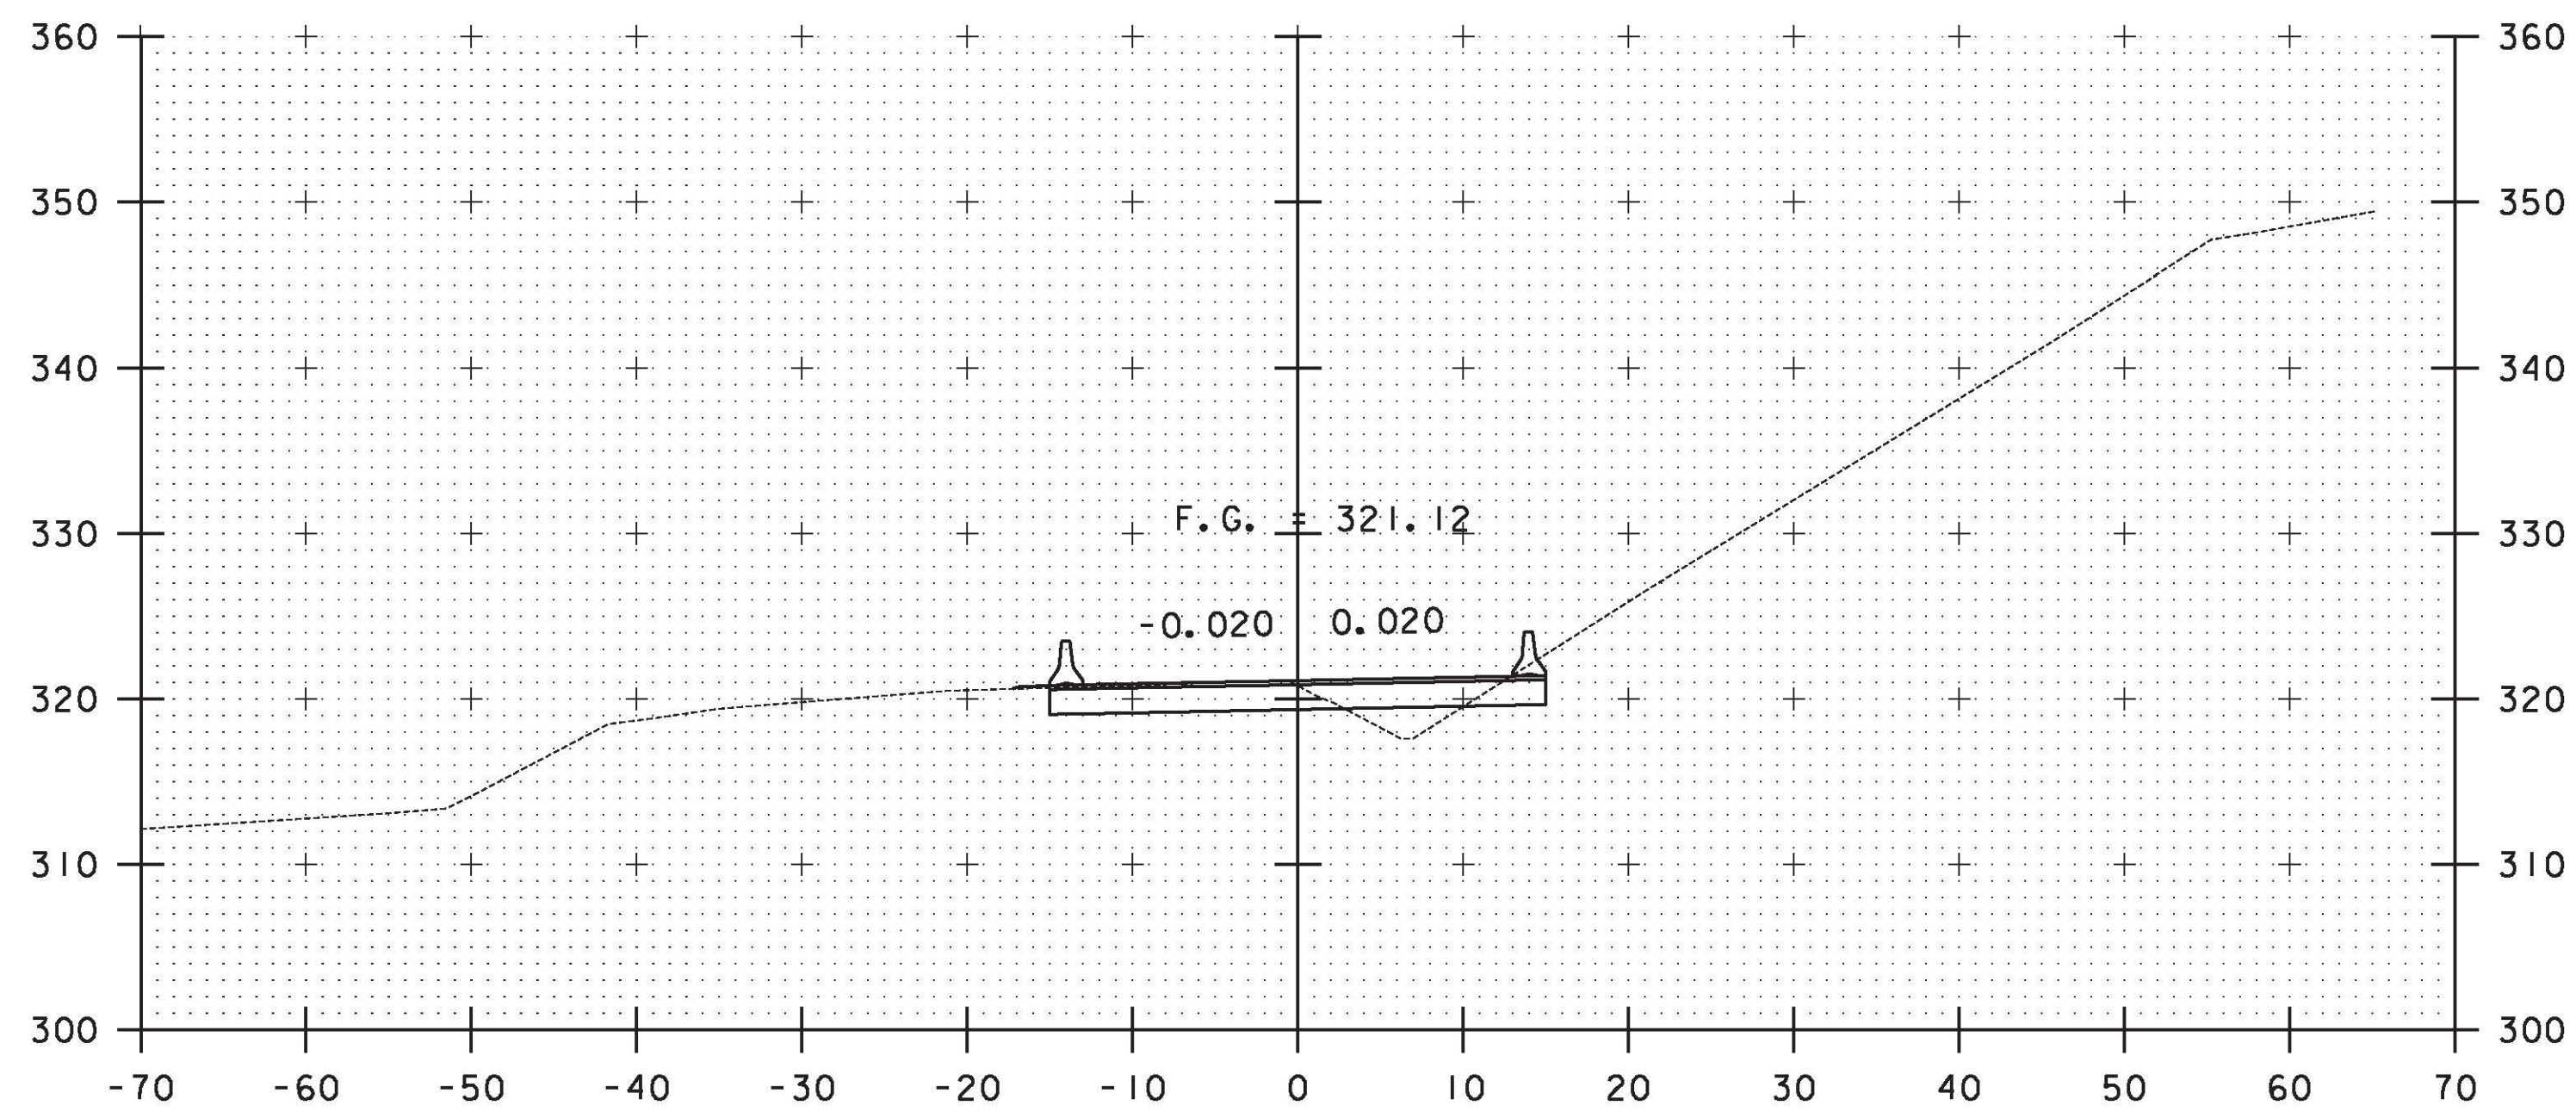

D 19+00

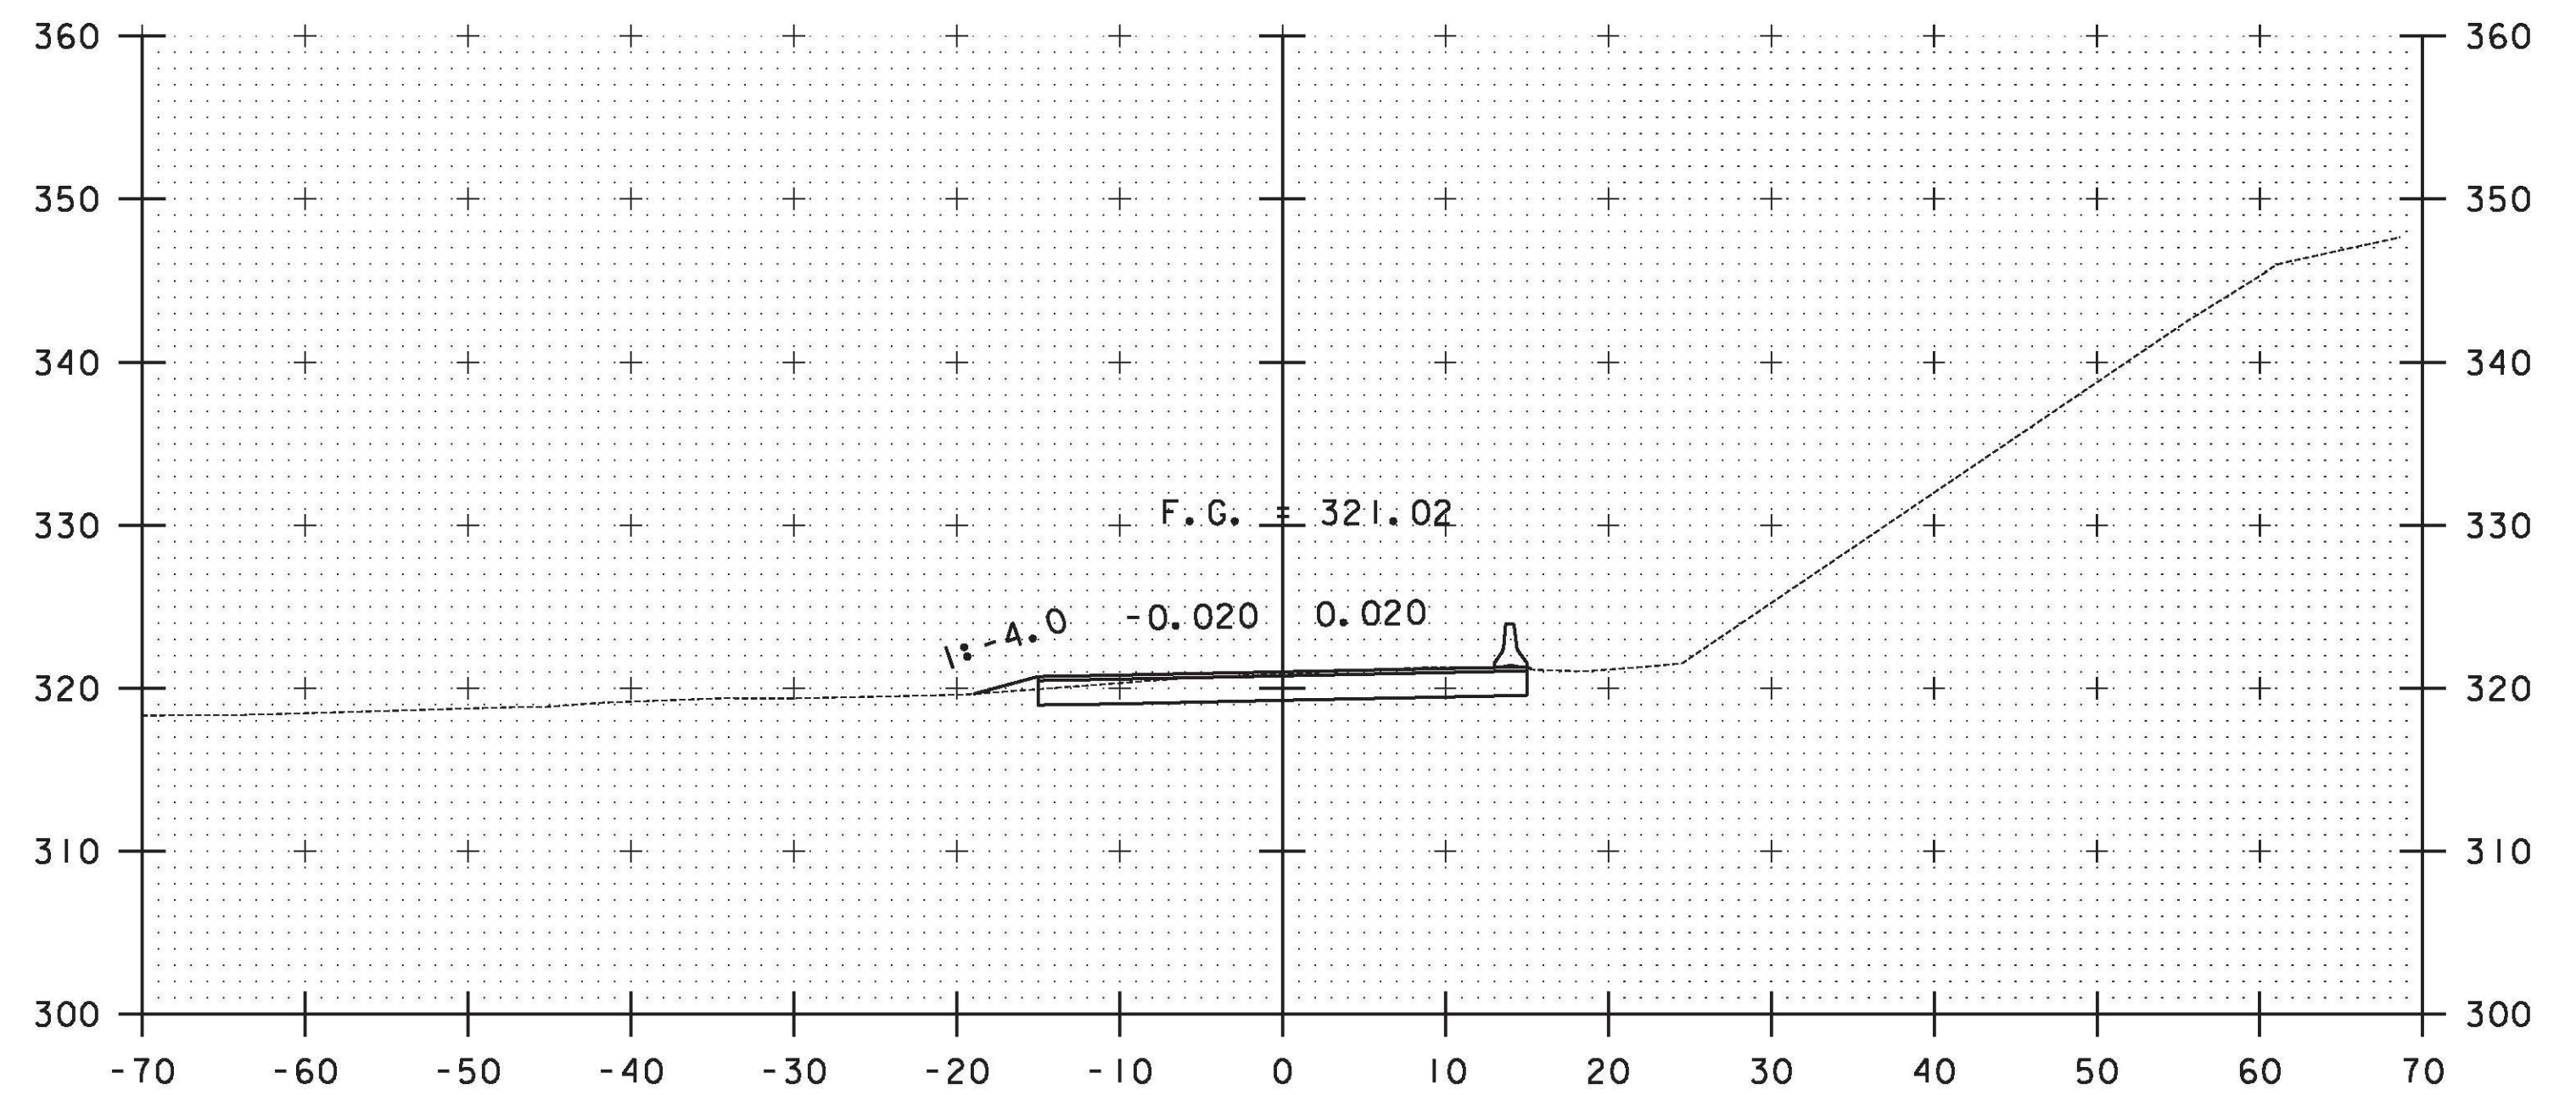

D 20+00

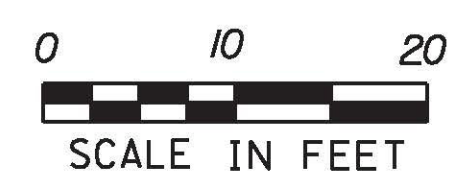

CROSS SECTIONS SHEET #6

PROJECT NAME: RICHMOND
 PROJECT NUMBER: STP-RS 0284(III)
 FILE NAME: z90c092_XSL13.dgn
 PROJECT LEADER: D.E.G.
 DESIGNED BY: B.T.H.
 DWG. NO.: XS-6

PLOT DATE: 6/17/2011
 DRAWN BY: C.A.K.
 CHECKED BY: D.E.G.
 SHEET 25 OF 29