




FILE NAME = V:\Projects\2009\22075\CADD\MSTN\BBS-1-131\DETOUR\z90c092_xsl13.dgn
 DATE/TIME = 6/17/2011
 USER = 3086

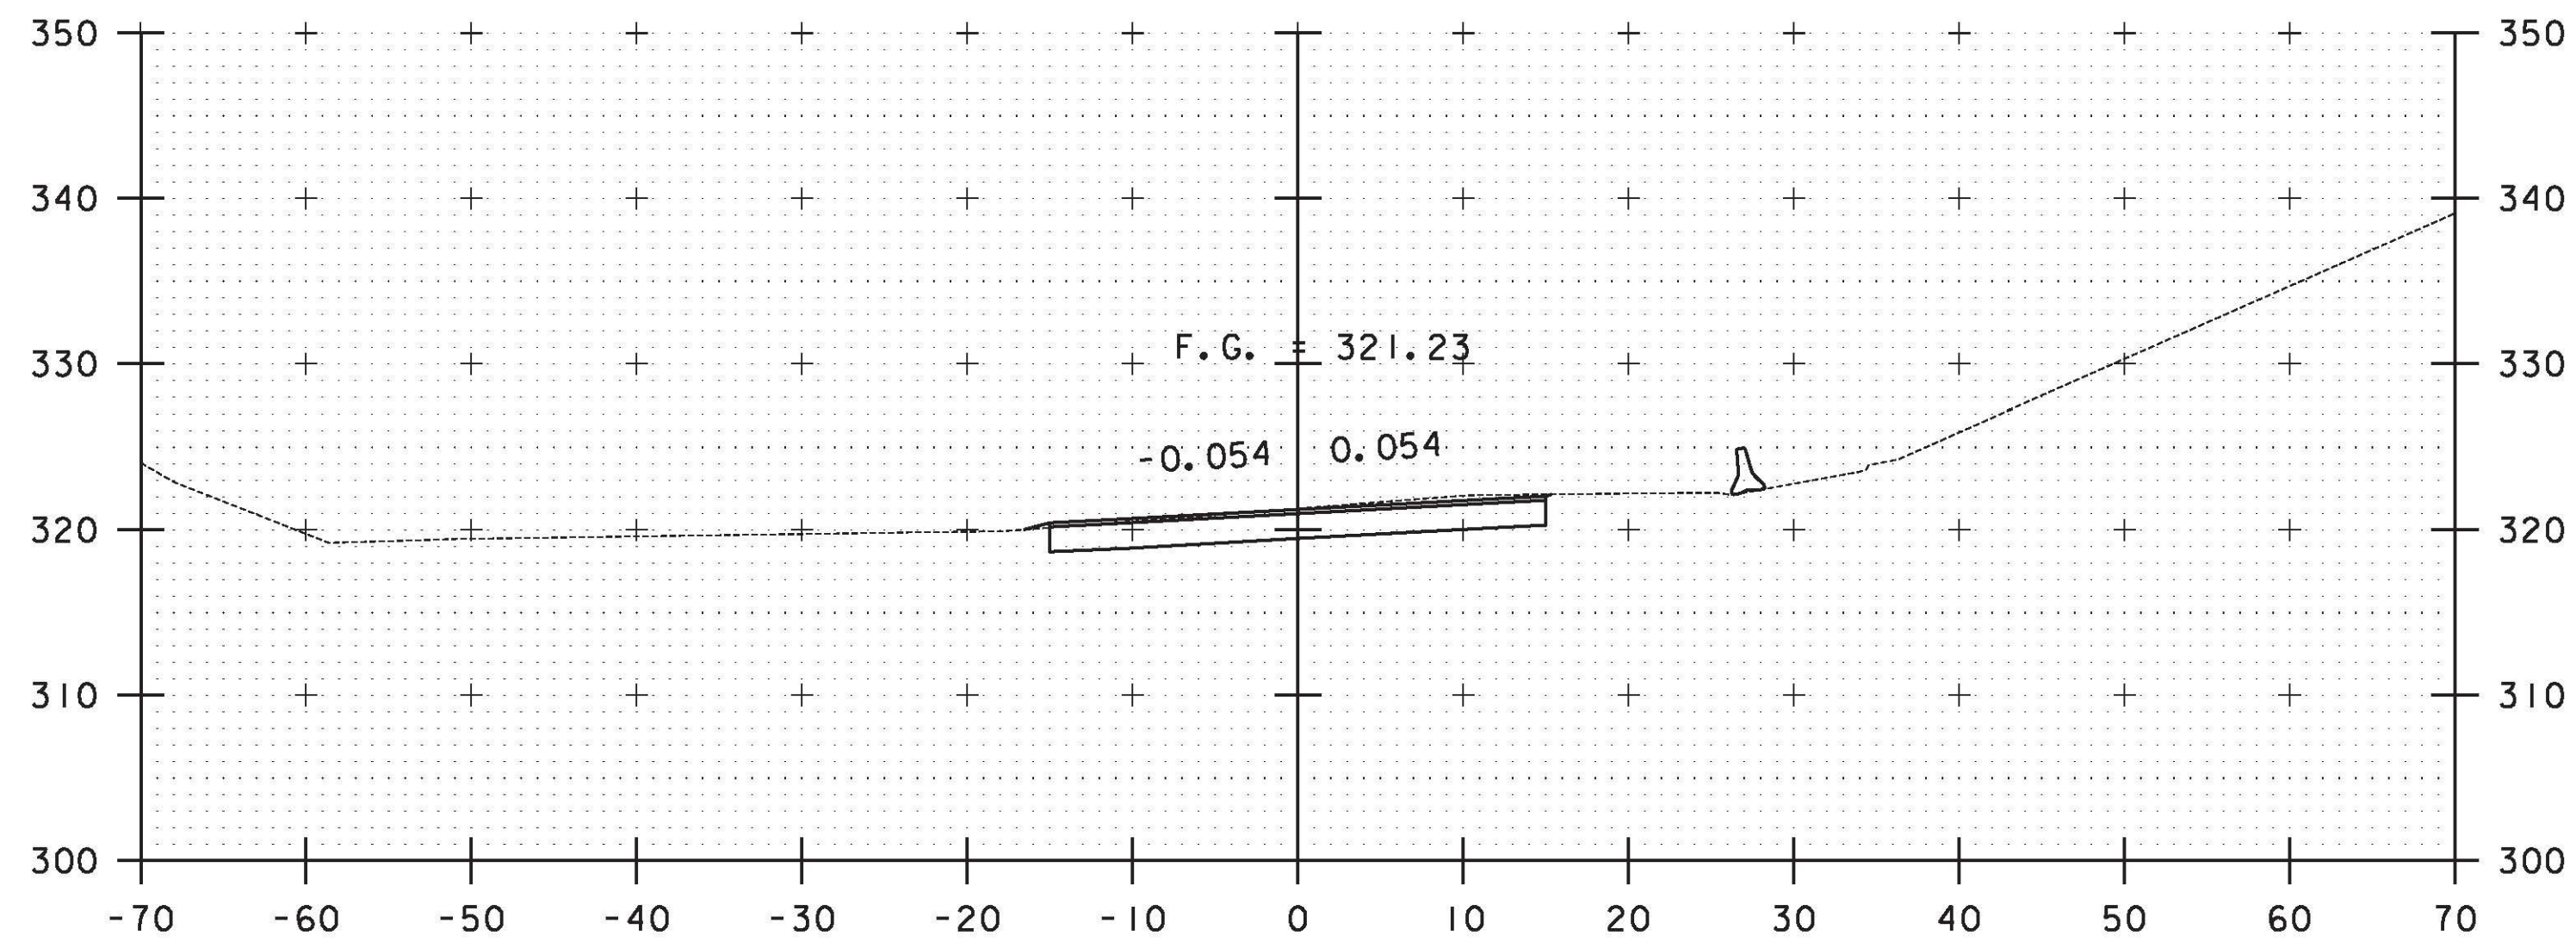


D 21+50

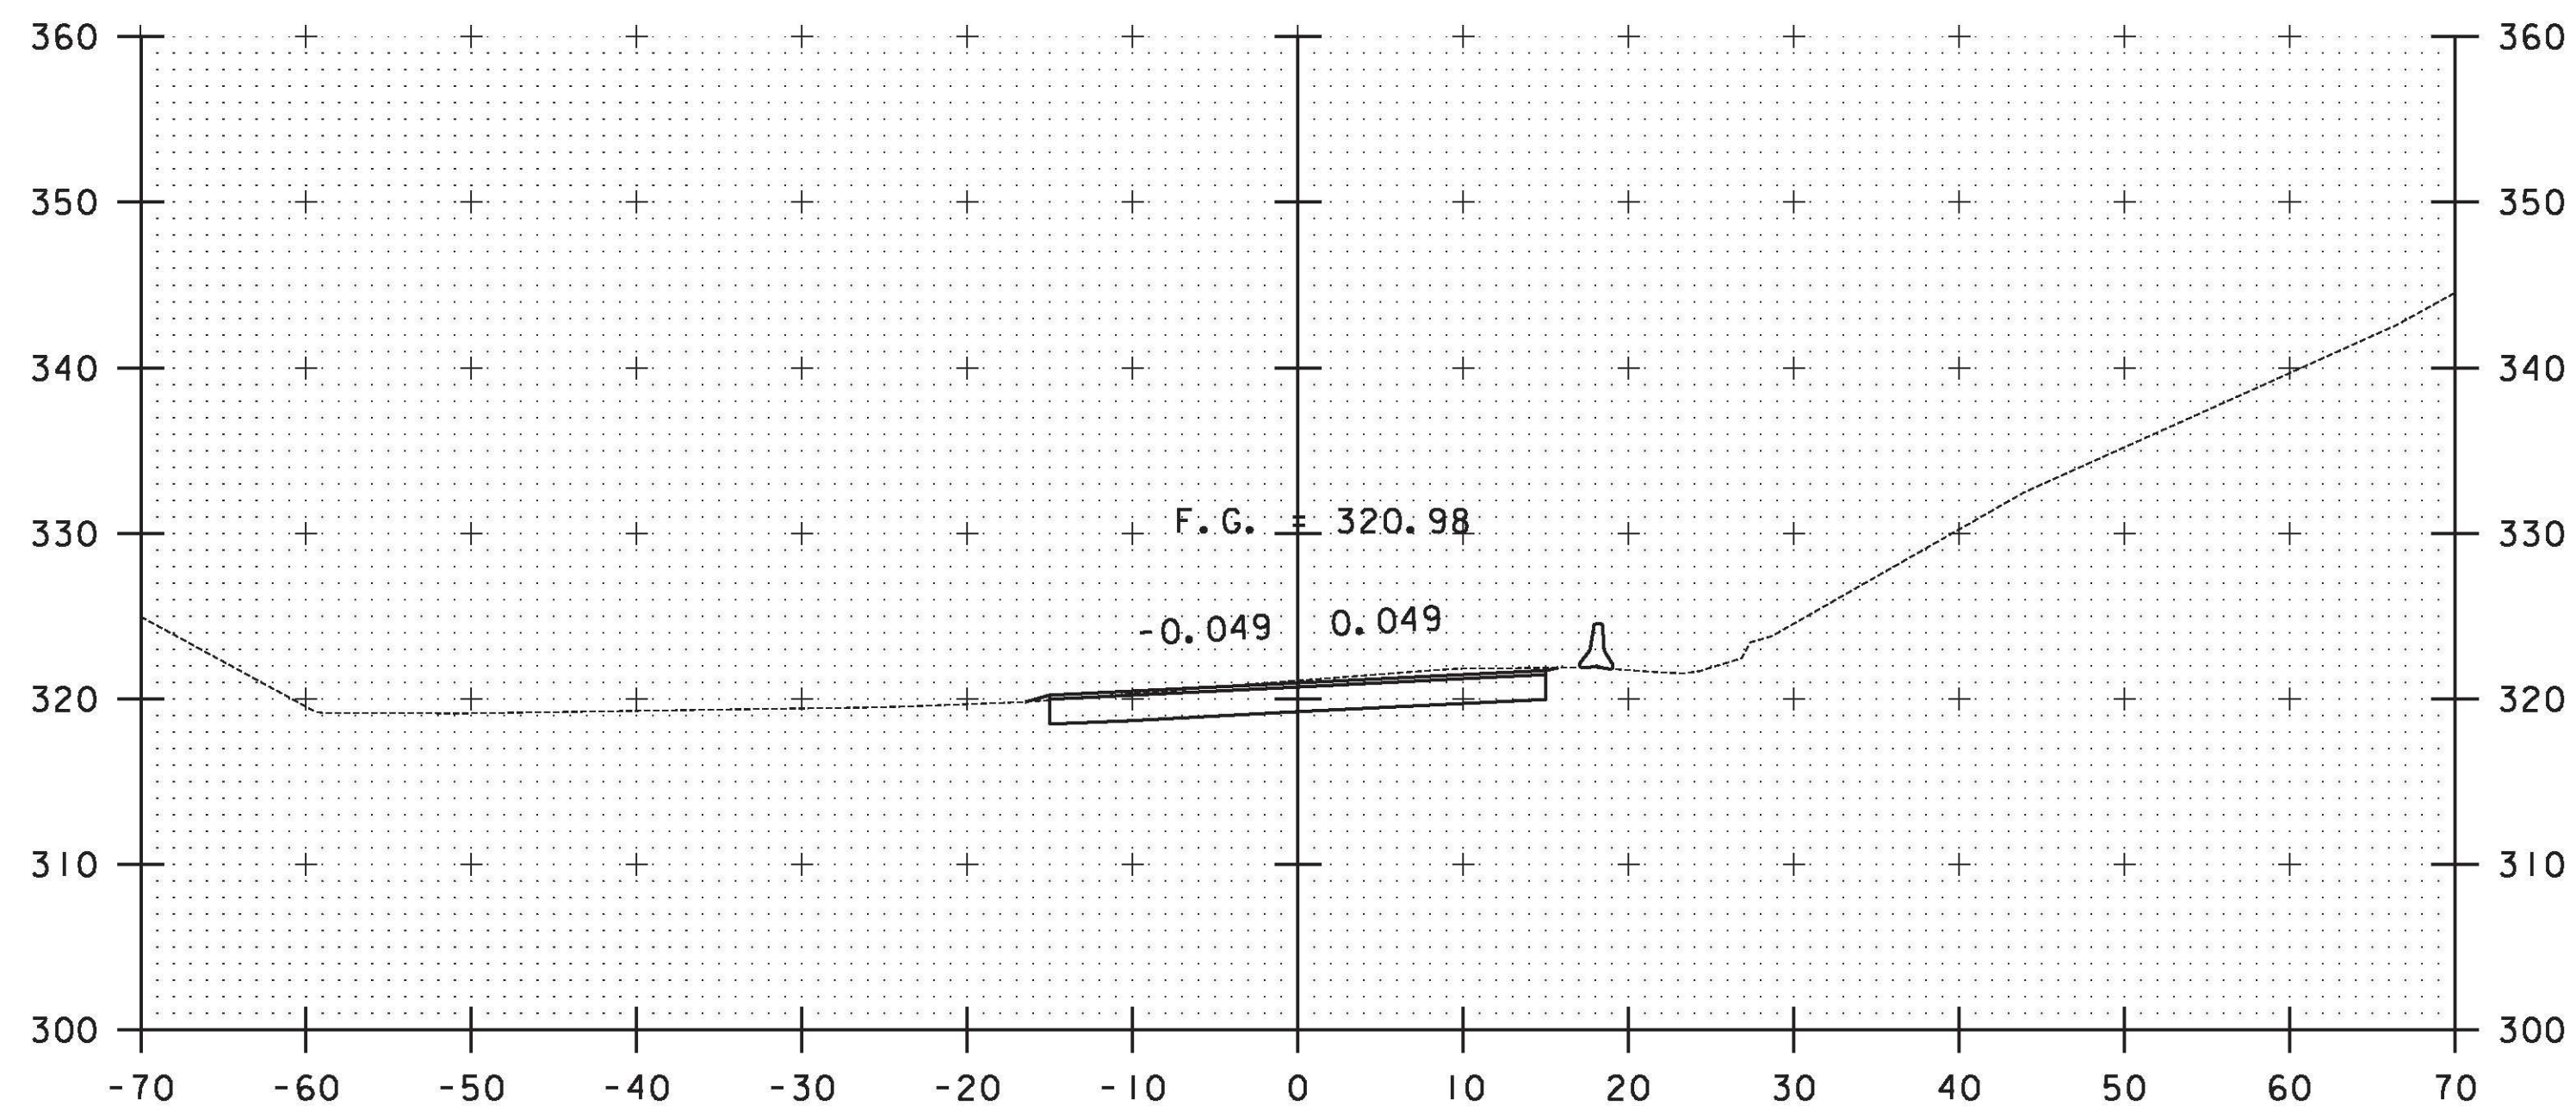


D 21+00

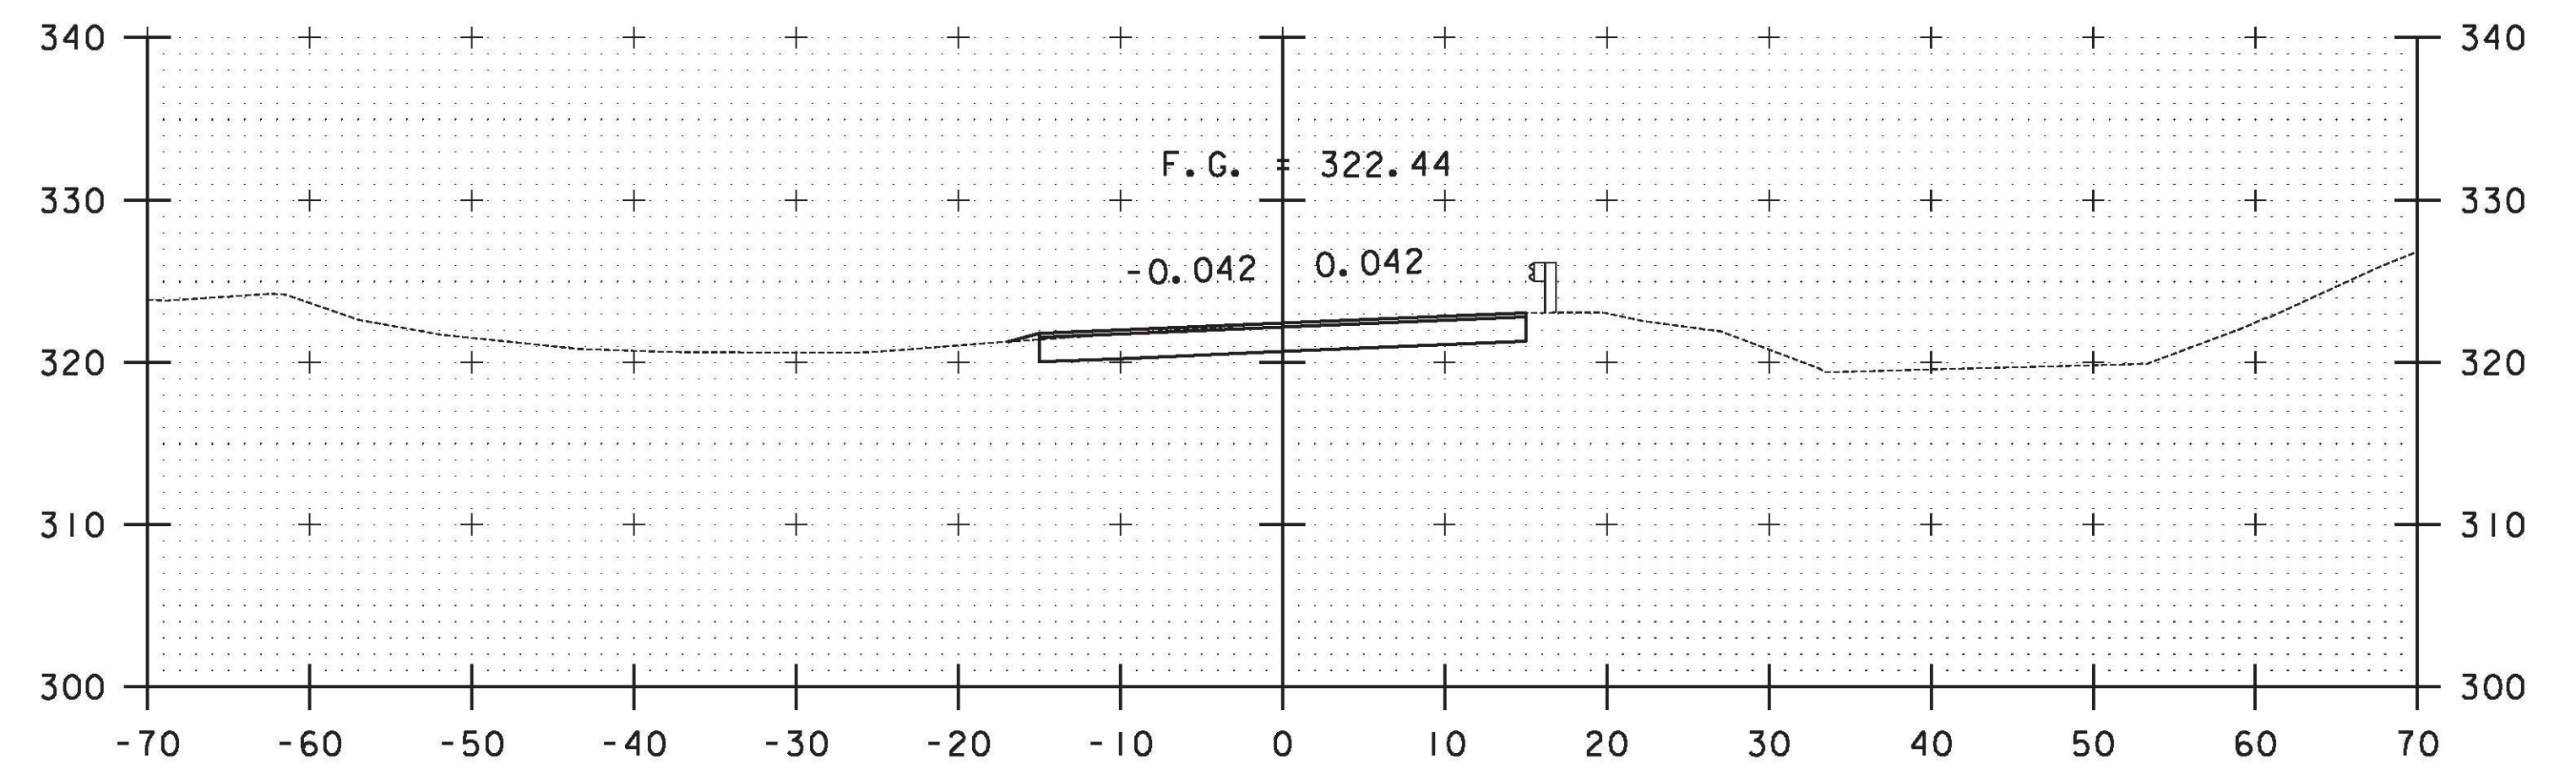

D 22+50

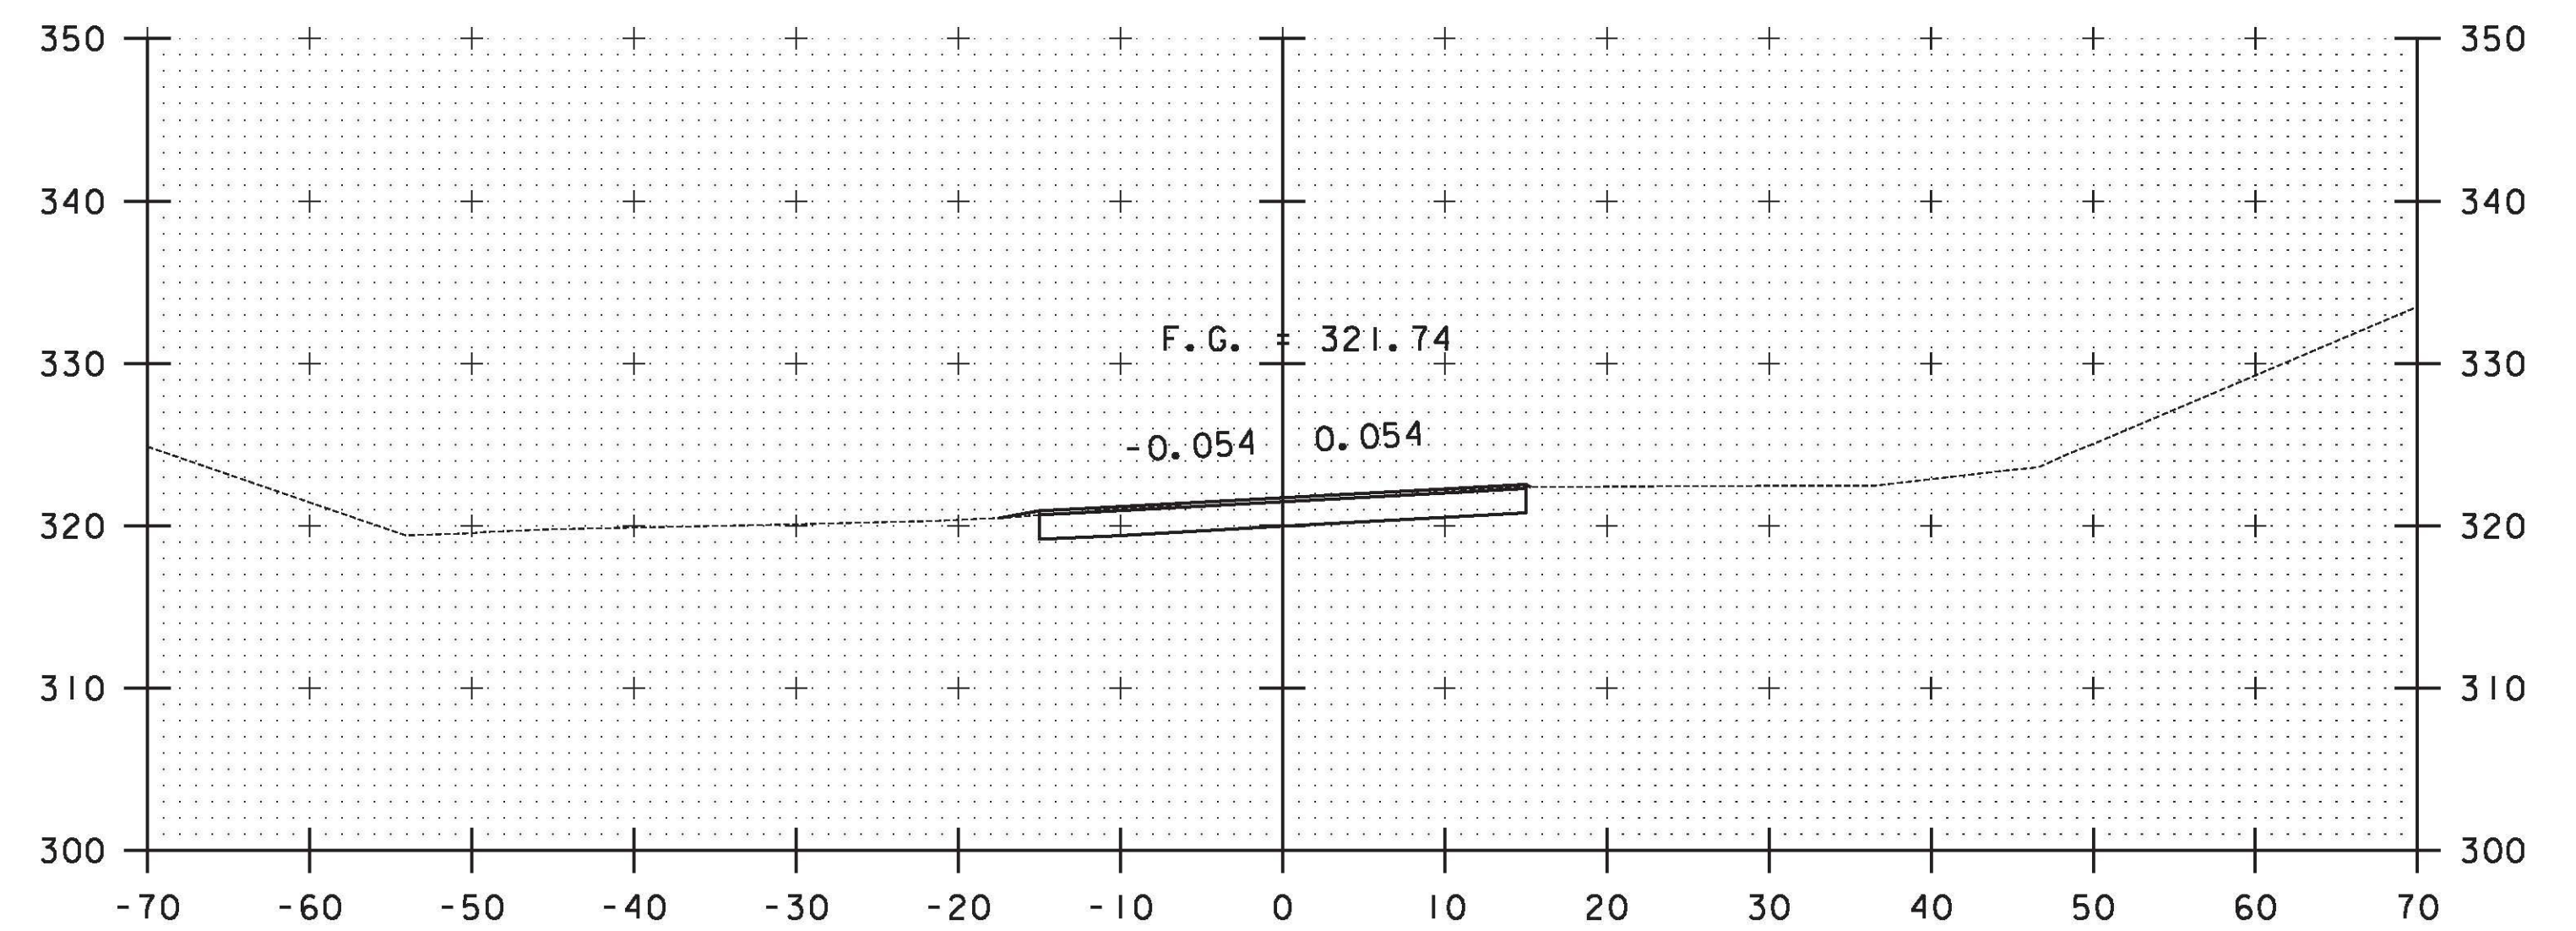

D 22+00

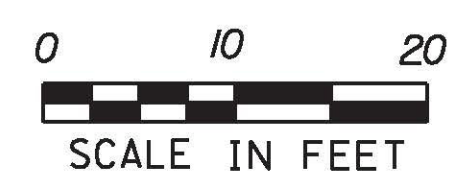

CROSS SECTIONS SHEET #7

PROJECT NAME: RICHMOND
 PROJECT NUMBER: STP-RS 0284(III)
 FILE NAME: z90c092_XSL13.dgn
 PROJECT LEADER: D.E.G.
 DESIGNED BY: B.T.H.
 DWG. NO.: XS-7

PLOT DATE: 6/17/2011
 DRAWN BY: C.A.K.
 CHECKED BY: D.E.G.
 SHEET 26 OF 29