




FILE NAME = V:\Projects\2007\2076\CAOD\JSTN\WBS 01-131 DETOUR\X90c092.spl.dgn
 DATE/TIME = 6/17/2011
 USER = 3086

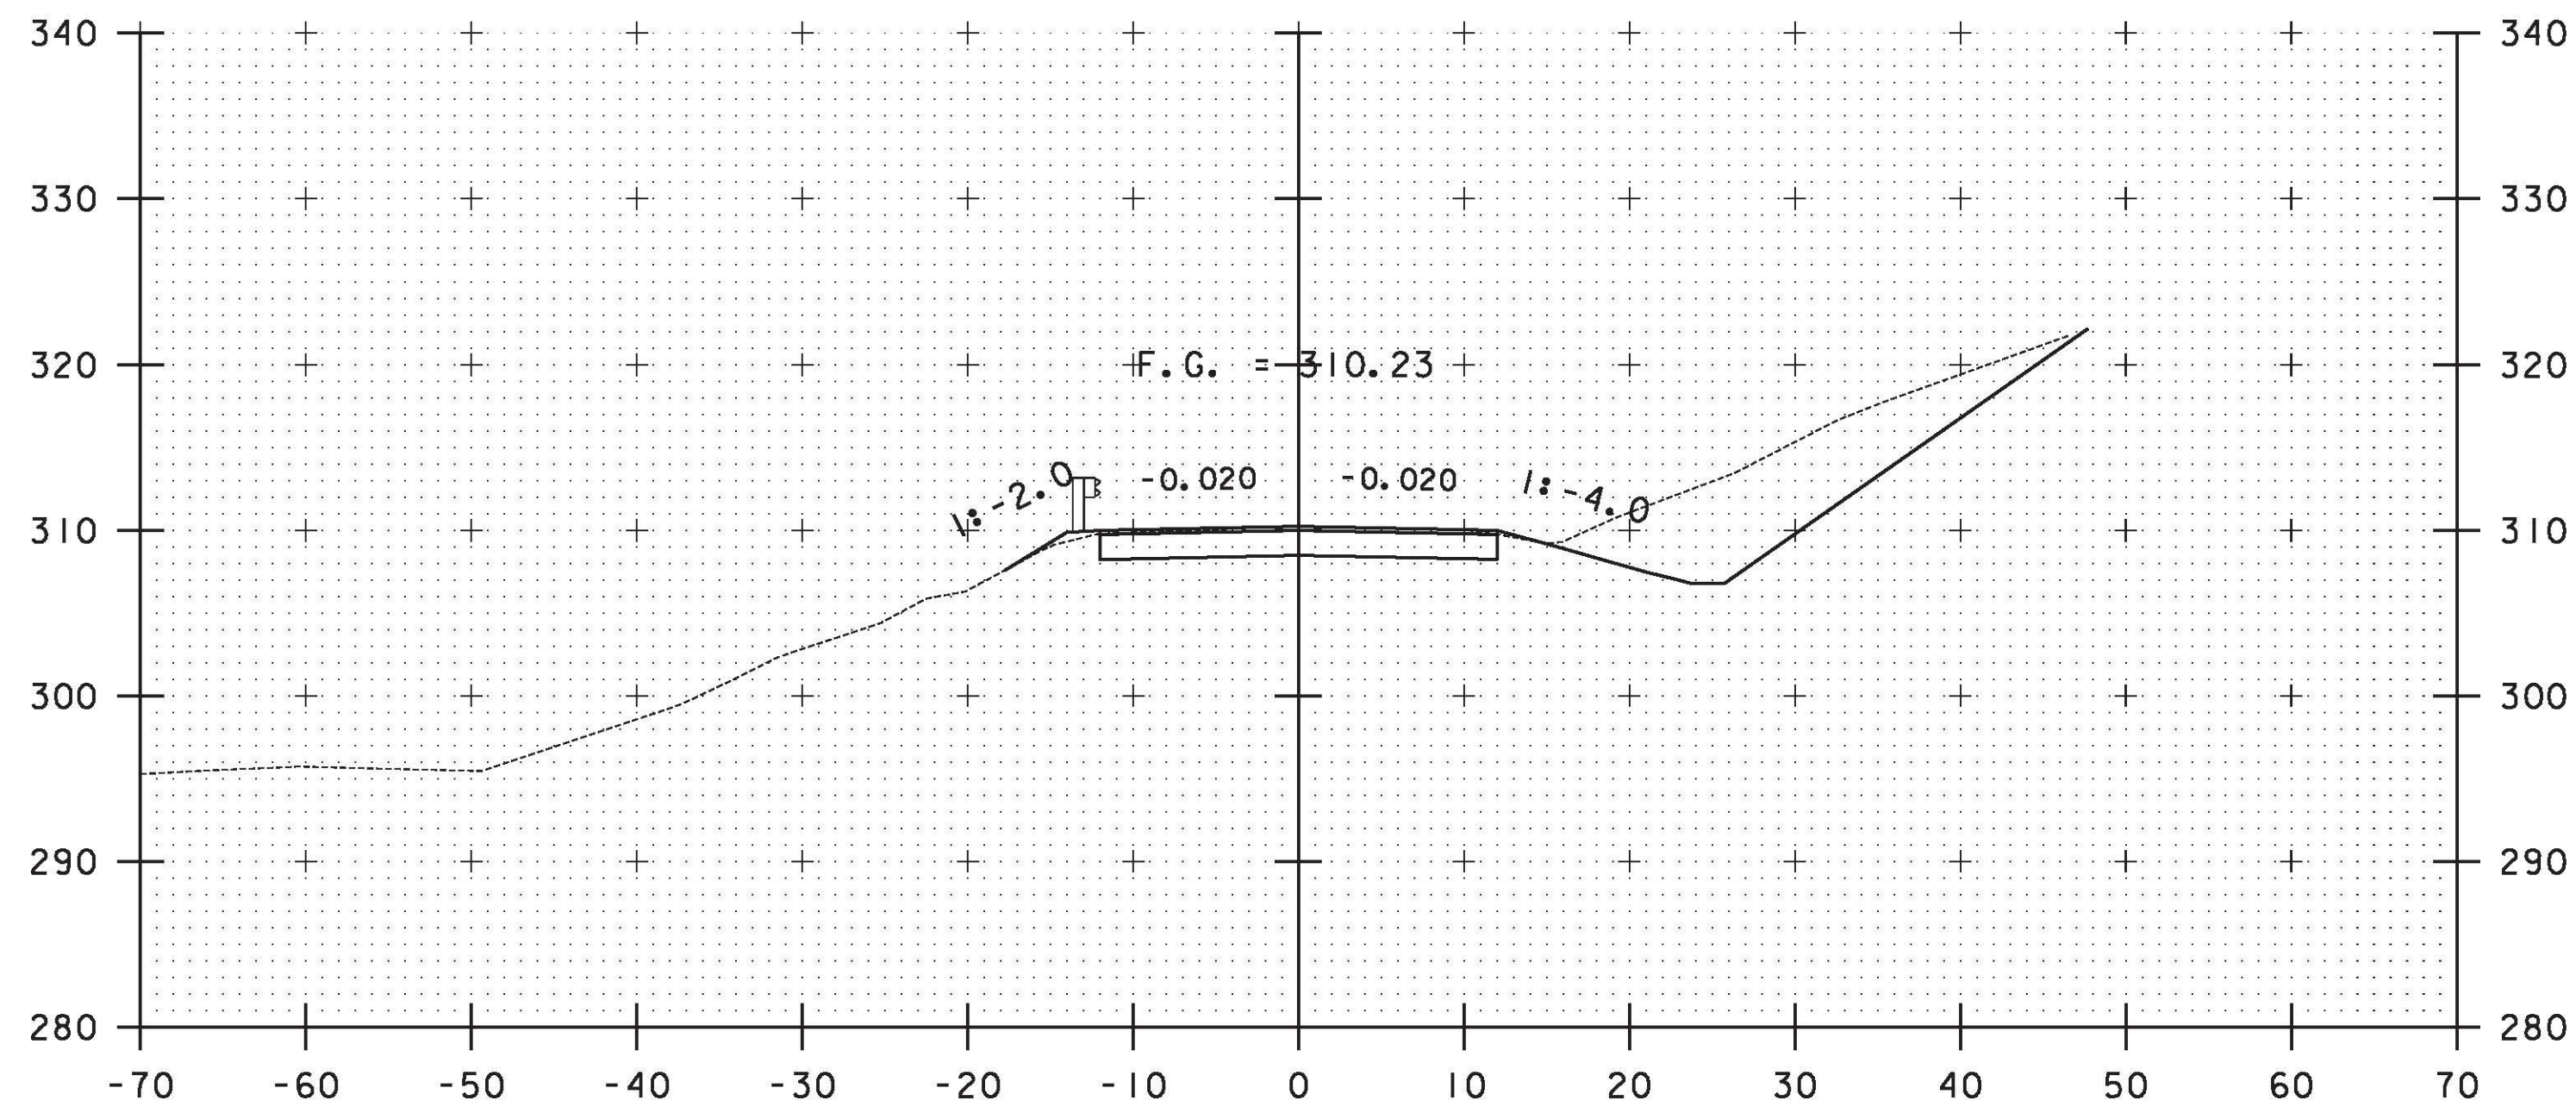

DJ 7+25

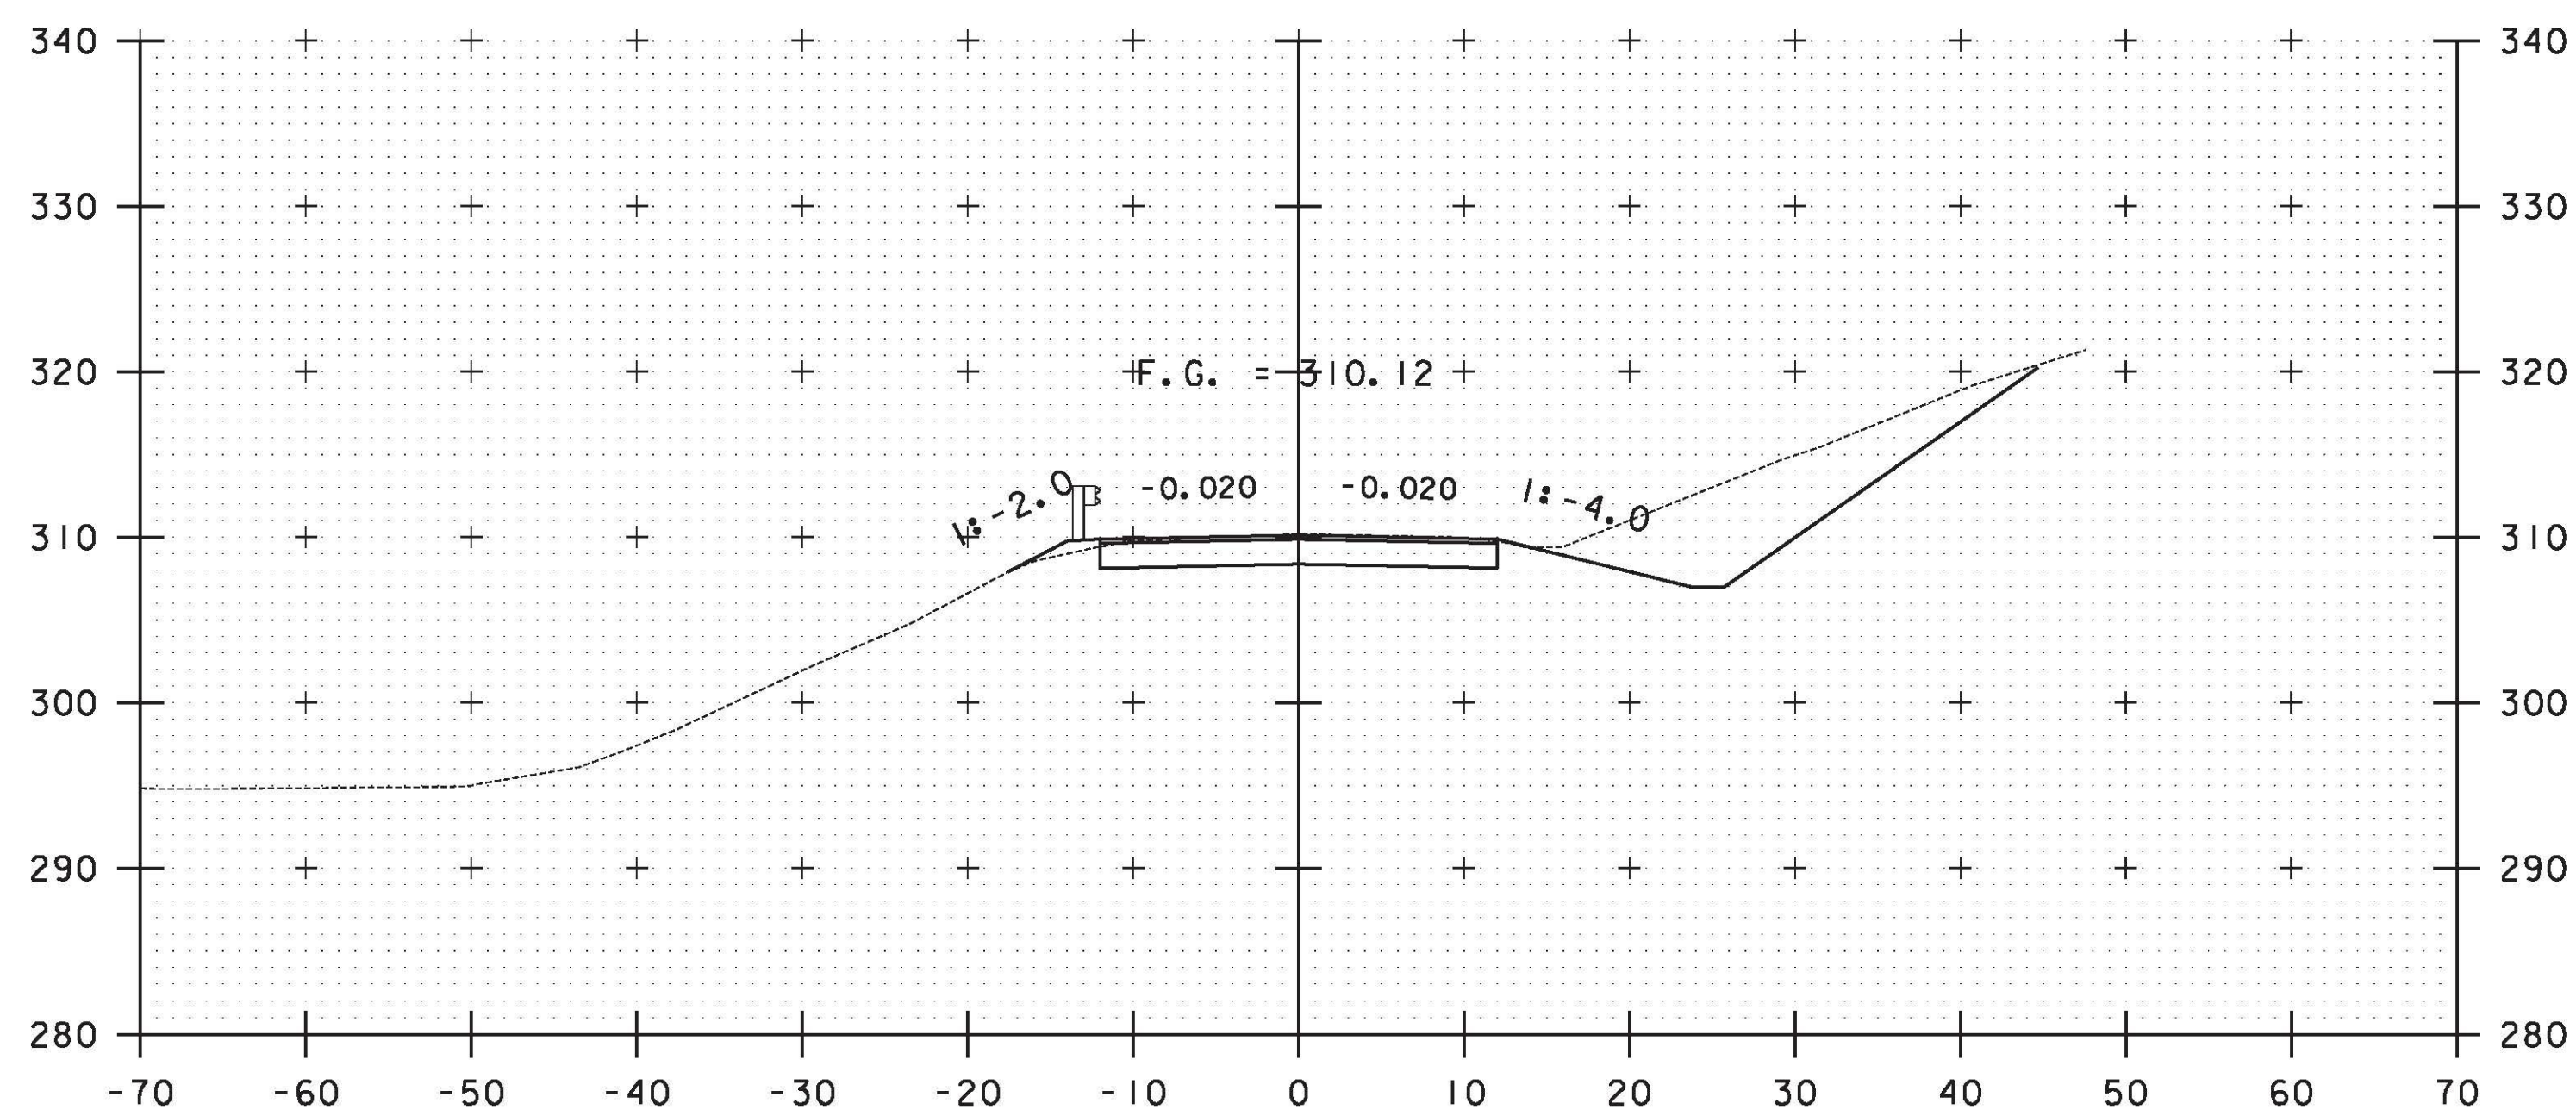

DJ 7+00

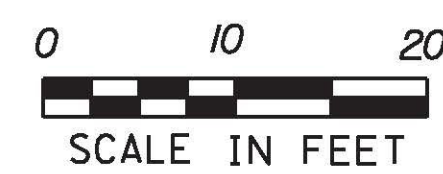

CROSS SECTIONS SHEET #9

PROJECT NAME: RICHMOND	PLOT DATE: 6/17/2011
PROJECT NUMBER: STP-RS 0284(III)	DRAWN BY: C.A.K.
FILE NAME:	CHECKED BY: D.E.G.
PROJECT LEADER: D.E.G.	SHEET 28 OF 29
DESIGNED BY: B.T.H.	
DWG. NO.: XS-9	