




FILE NAME = V:\P\Projects\A\NY\K2\22076\CADD\MSTN\WBS-1\131 DETOUR\X90a092.dwg  
 DATE/TIME = 6/17/2011  
 USER = 3086

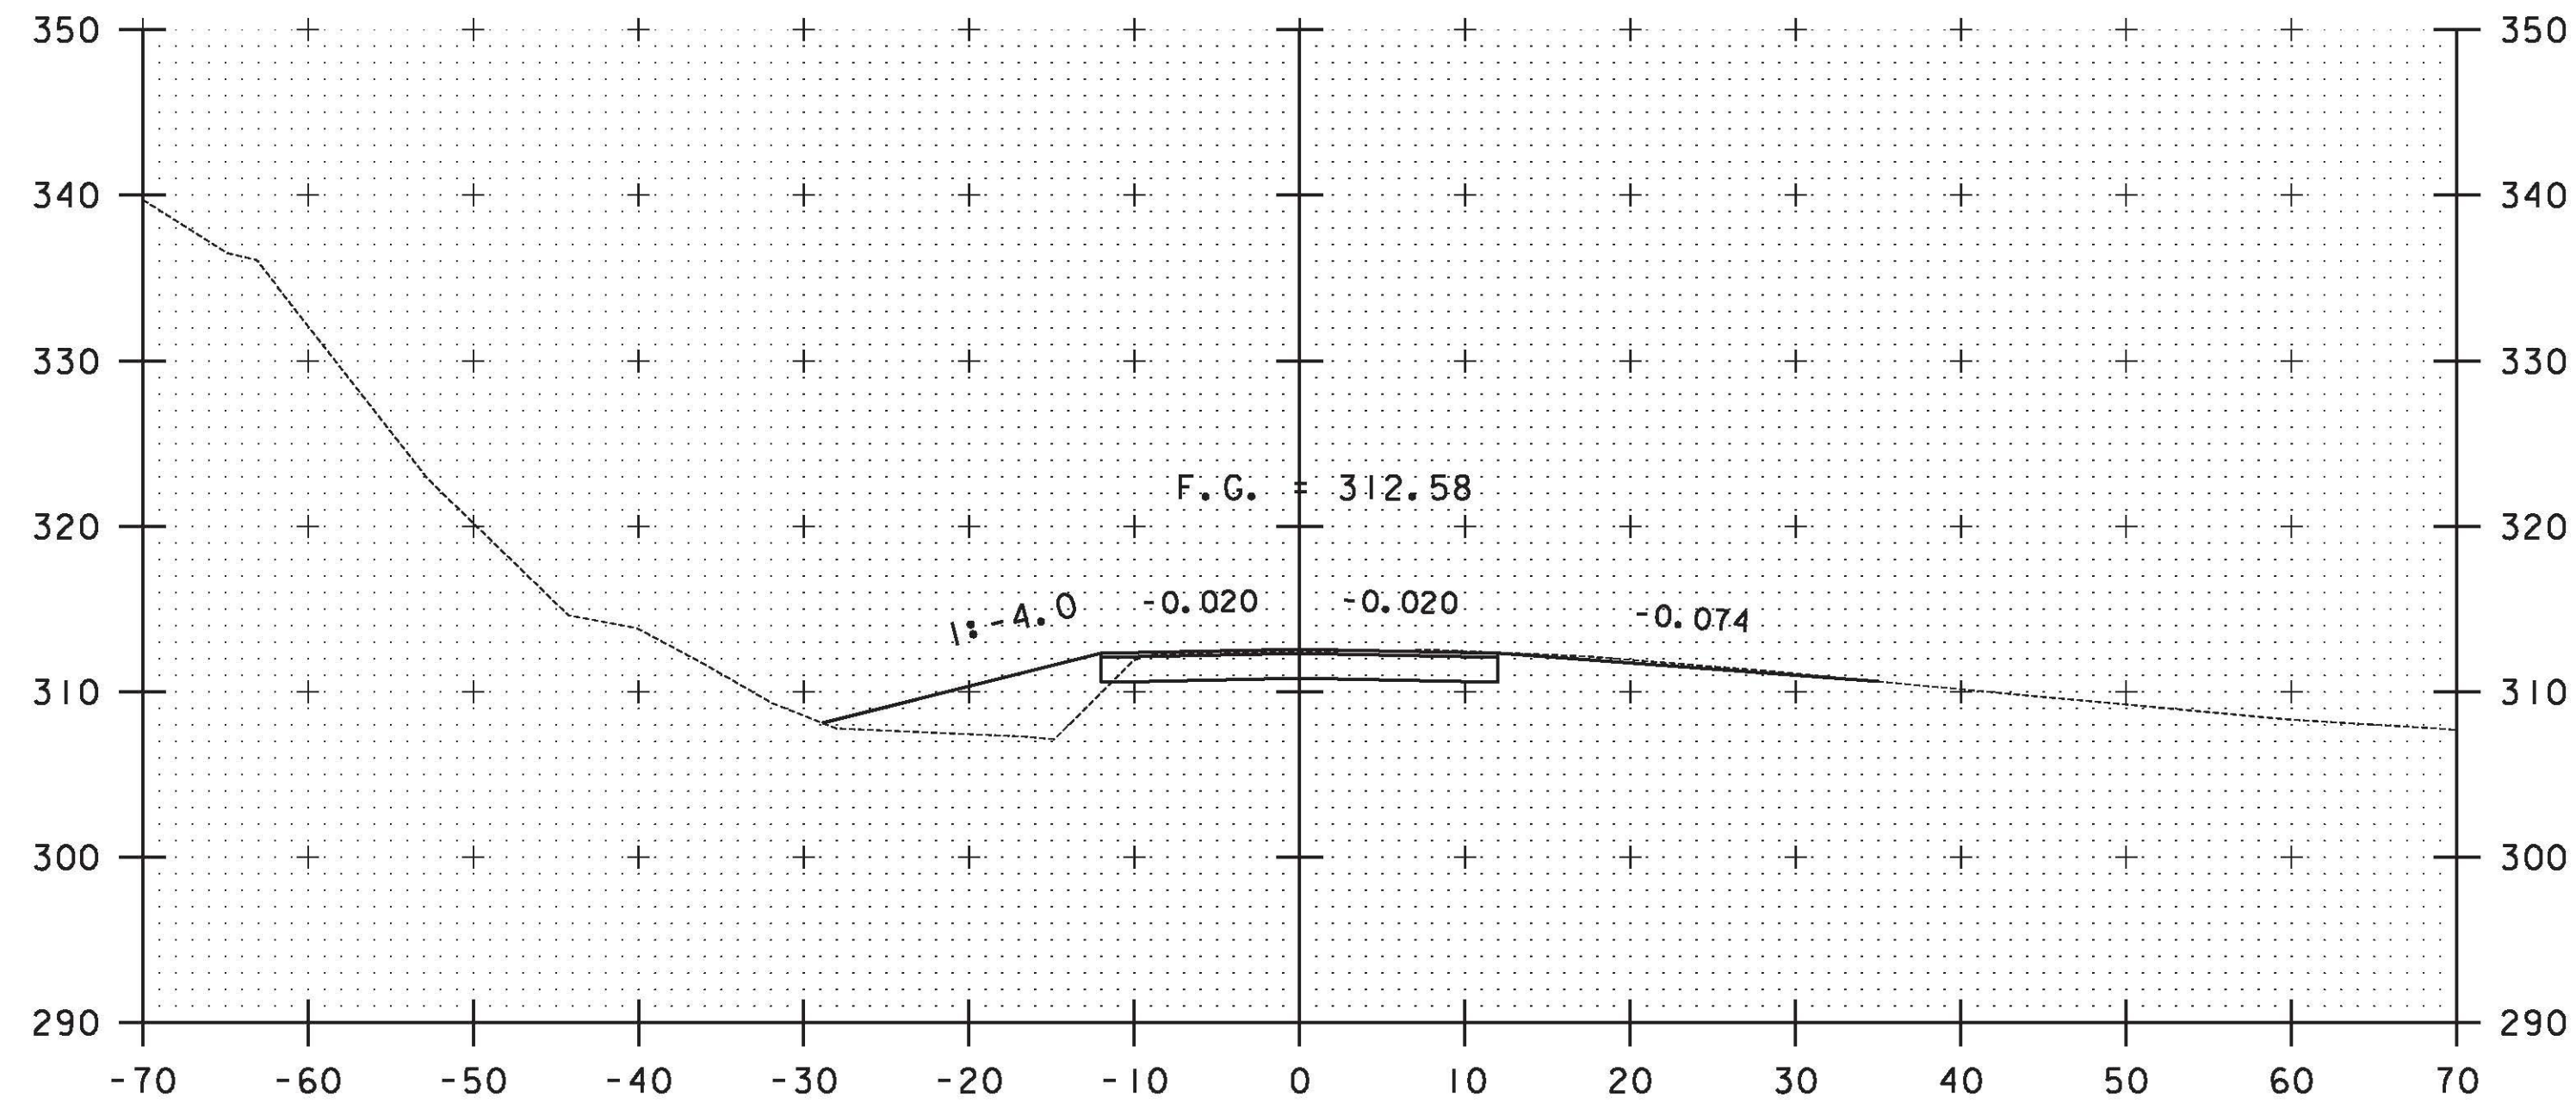


DK 11+00

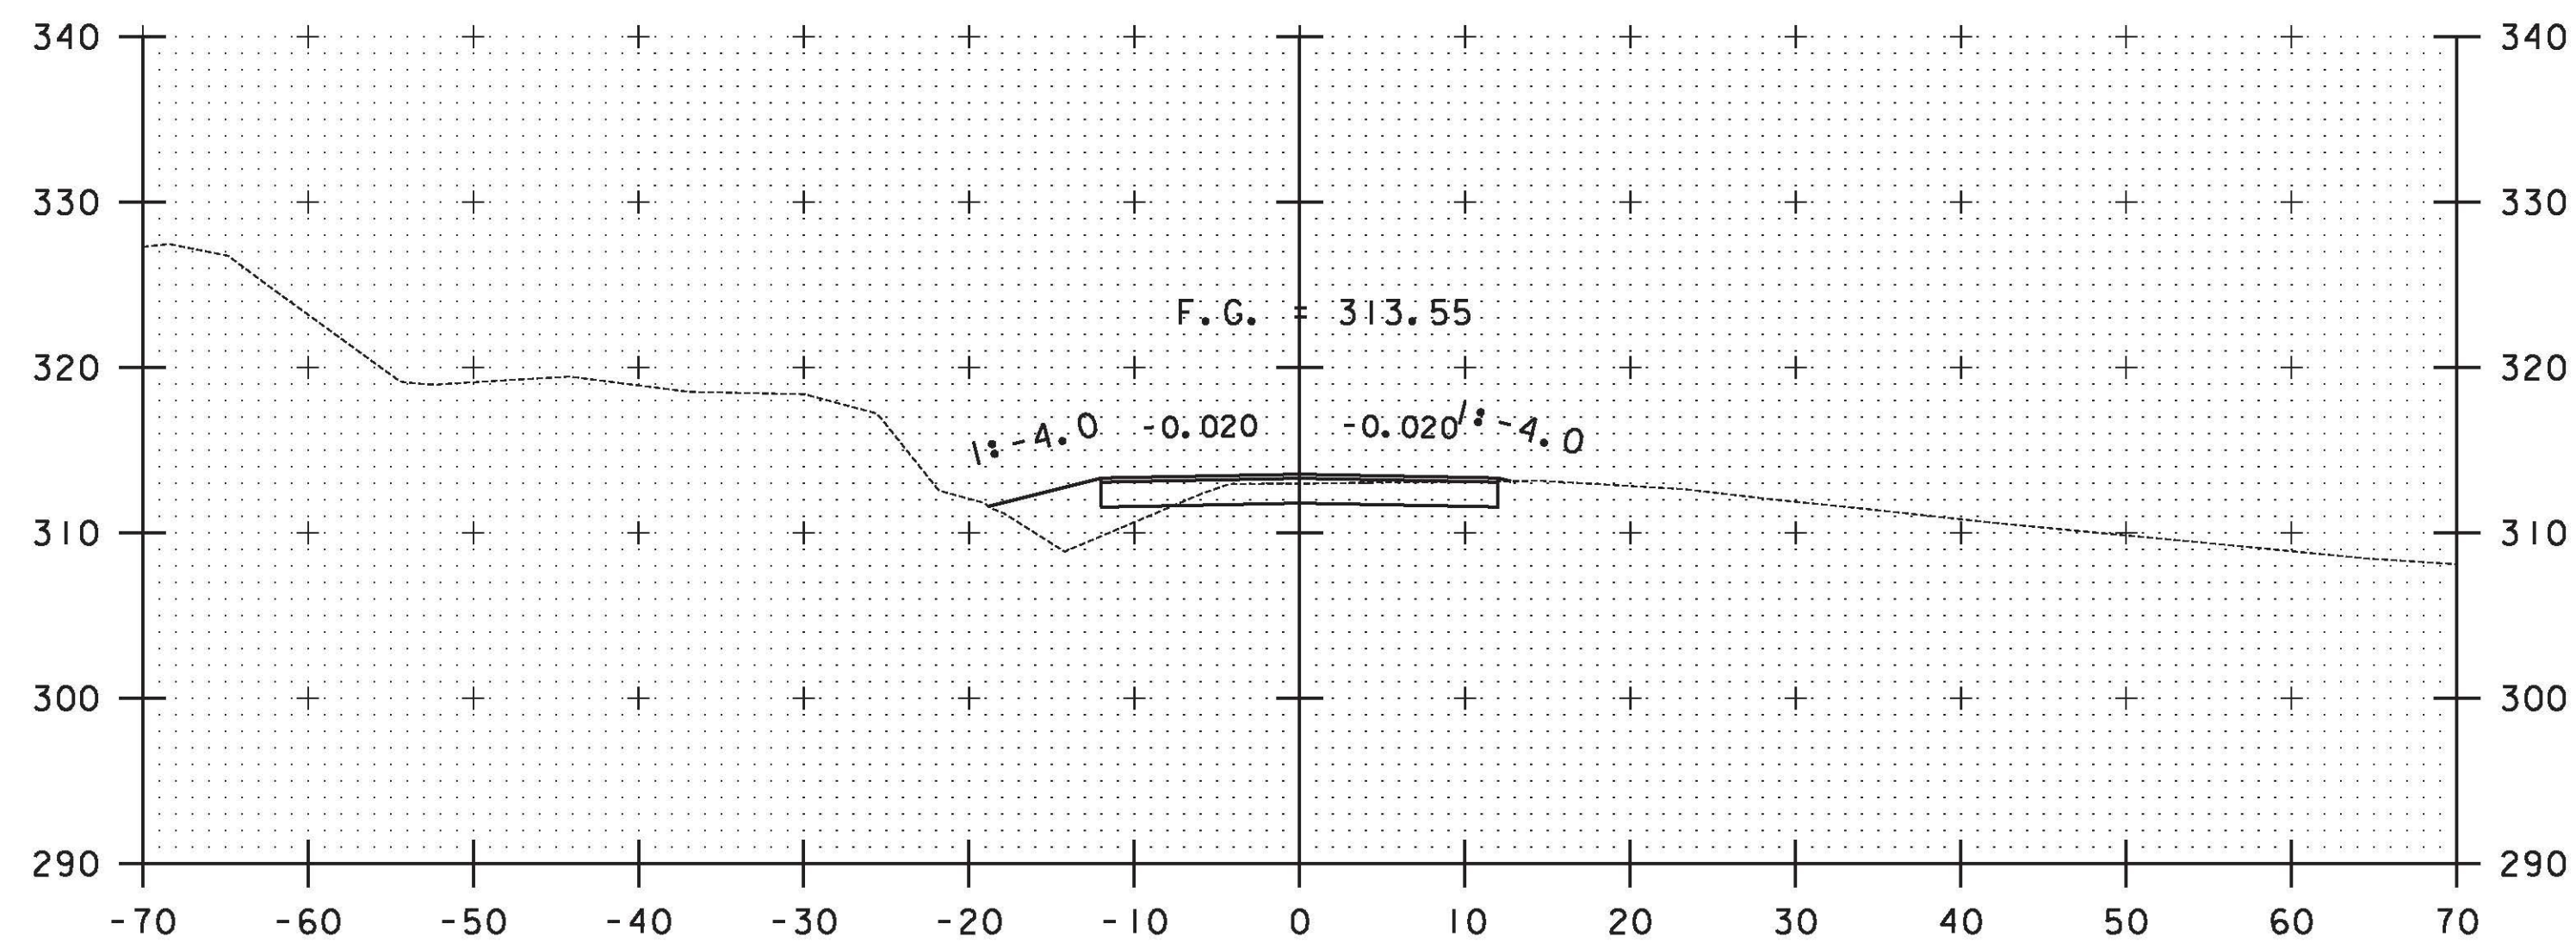


DK 10+50

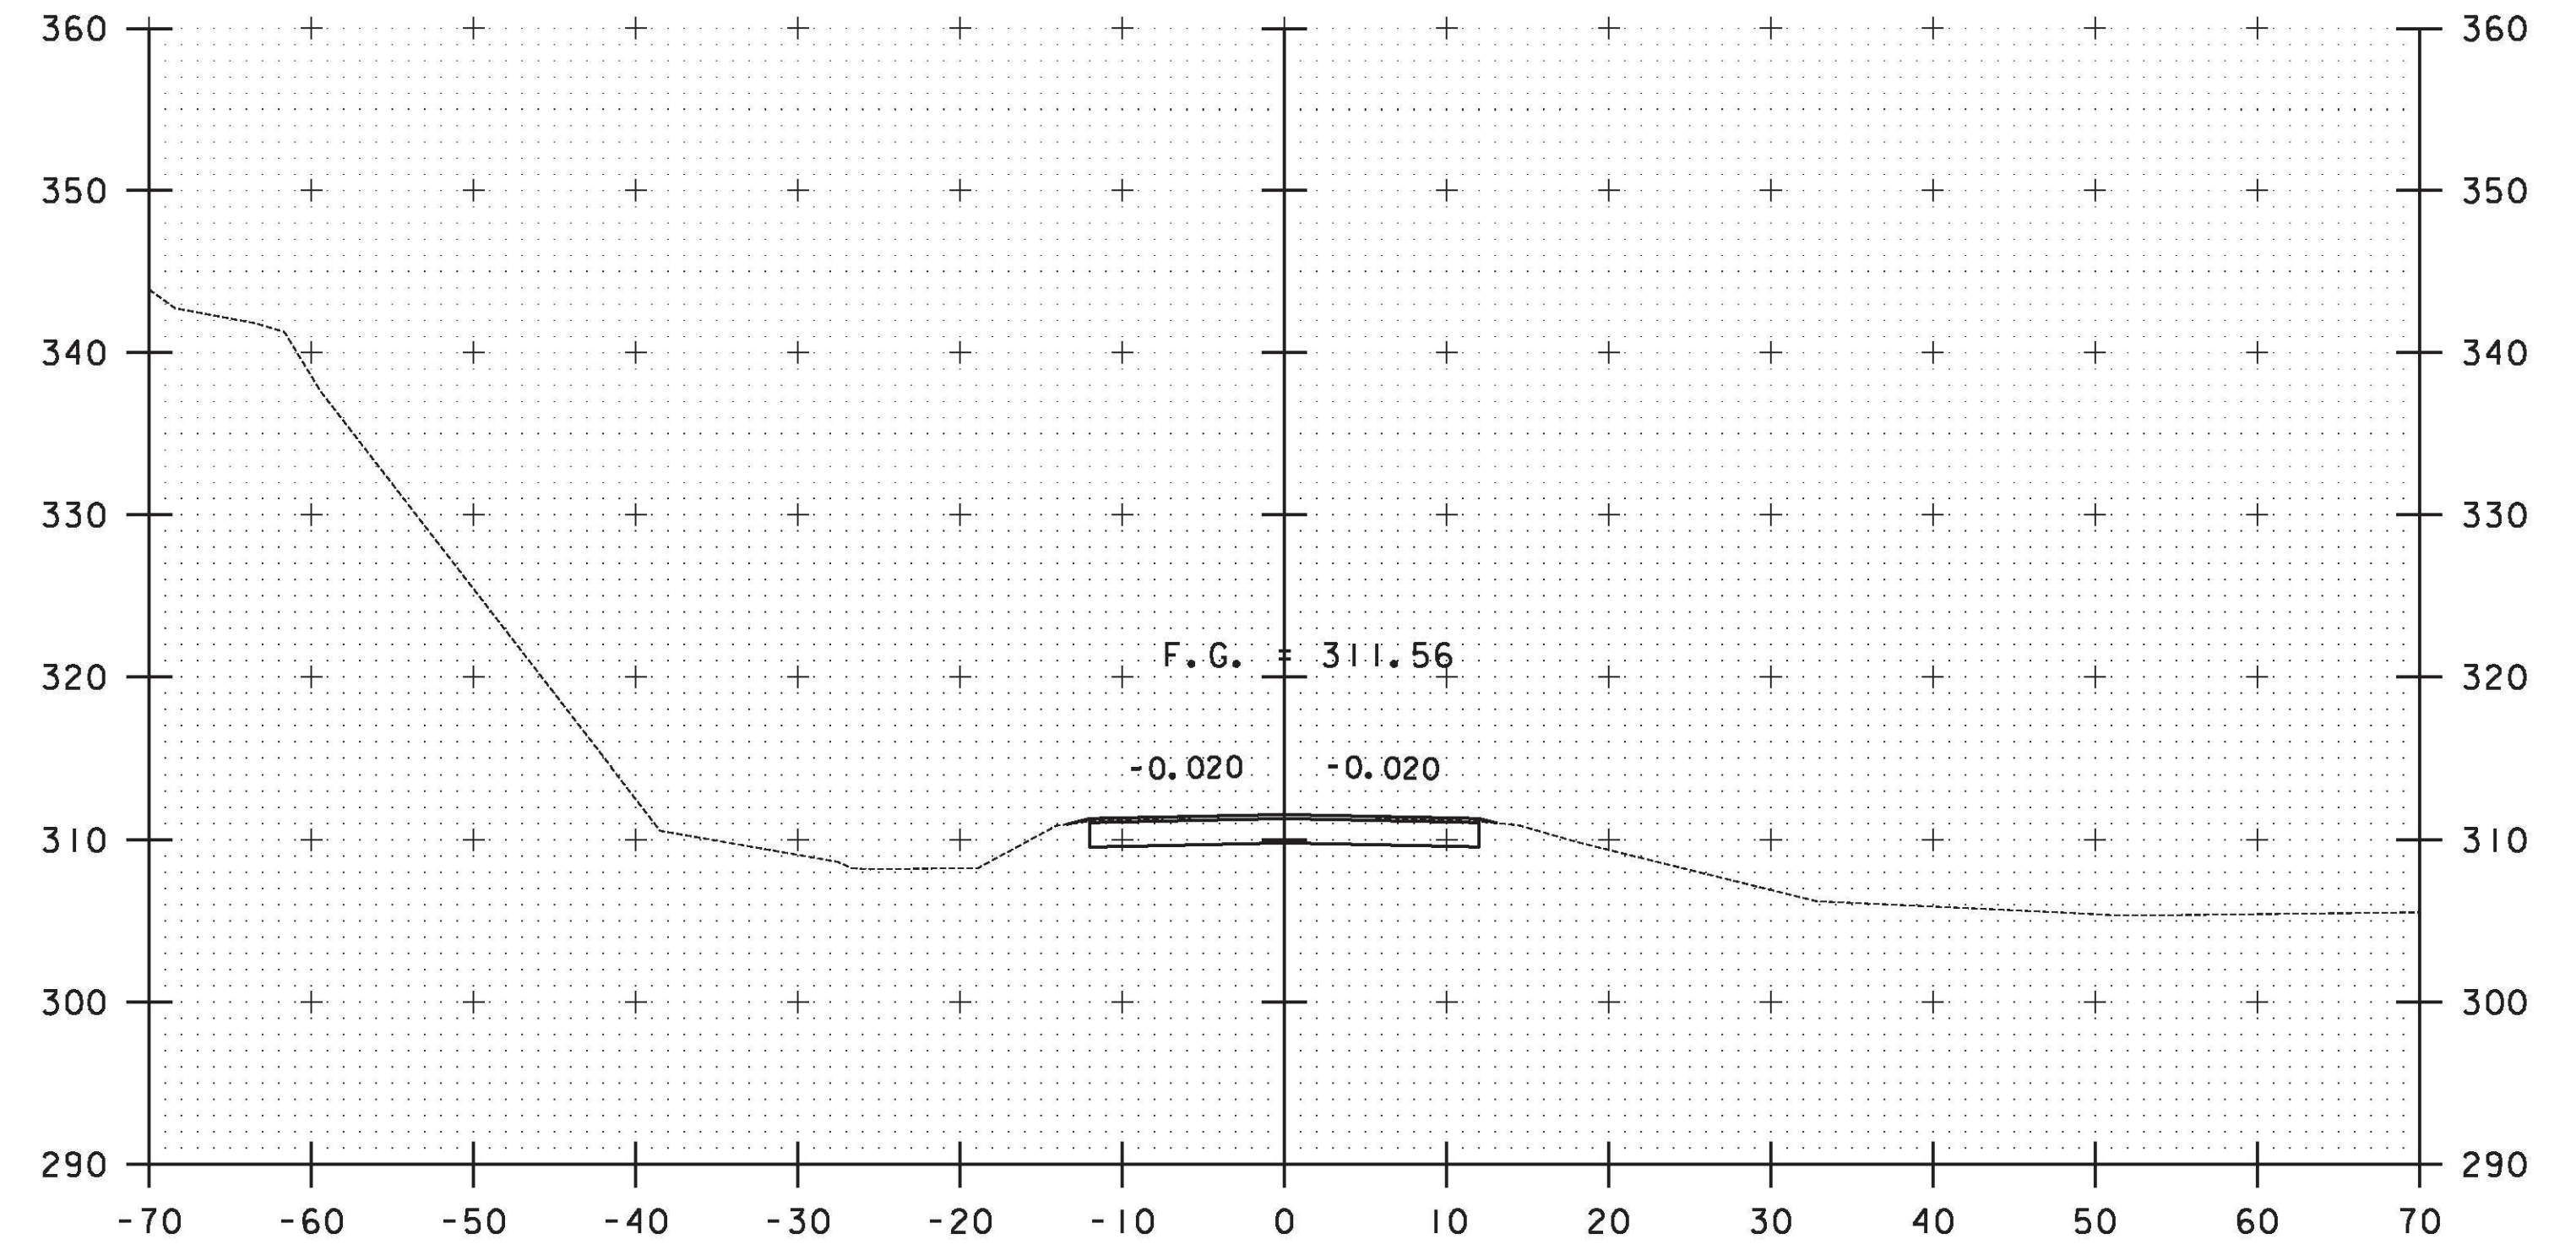

DK 11+60

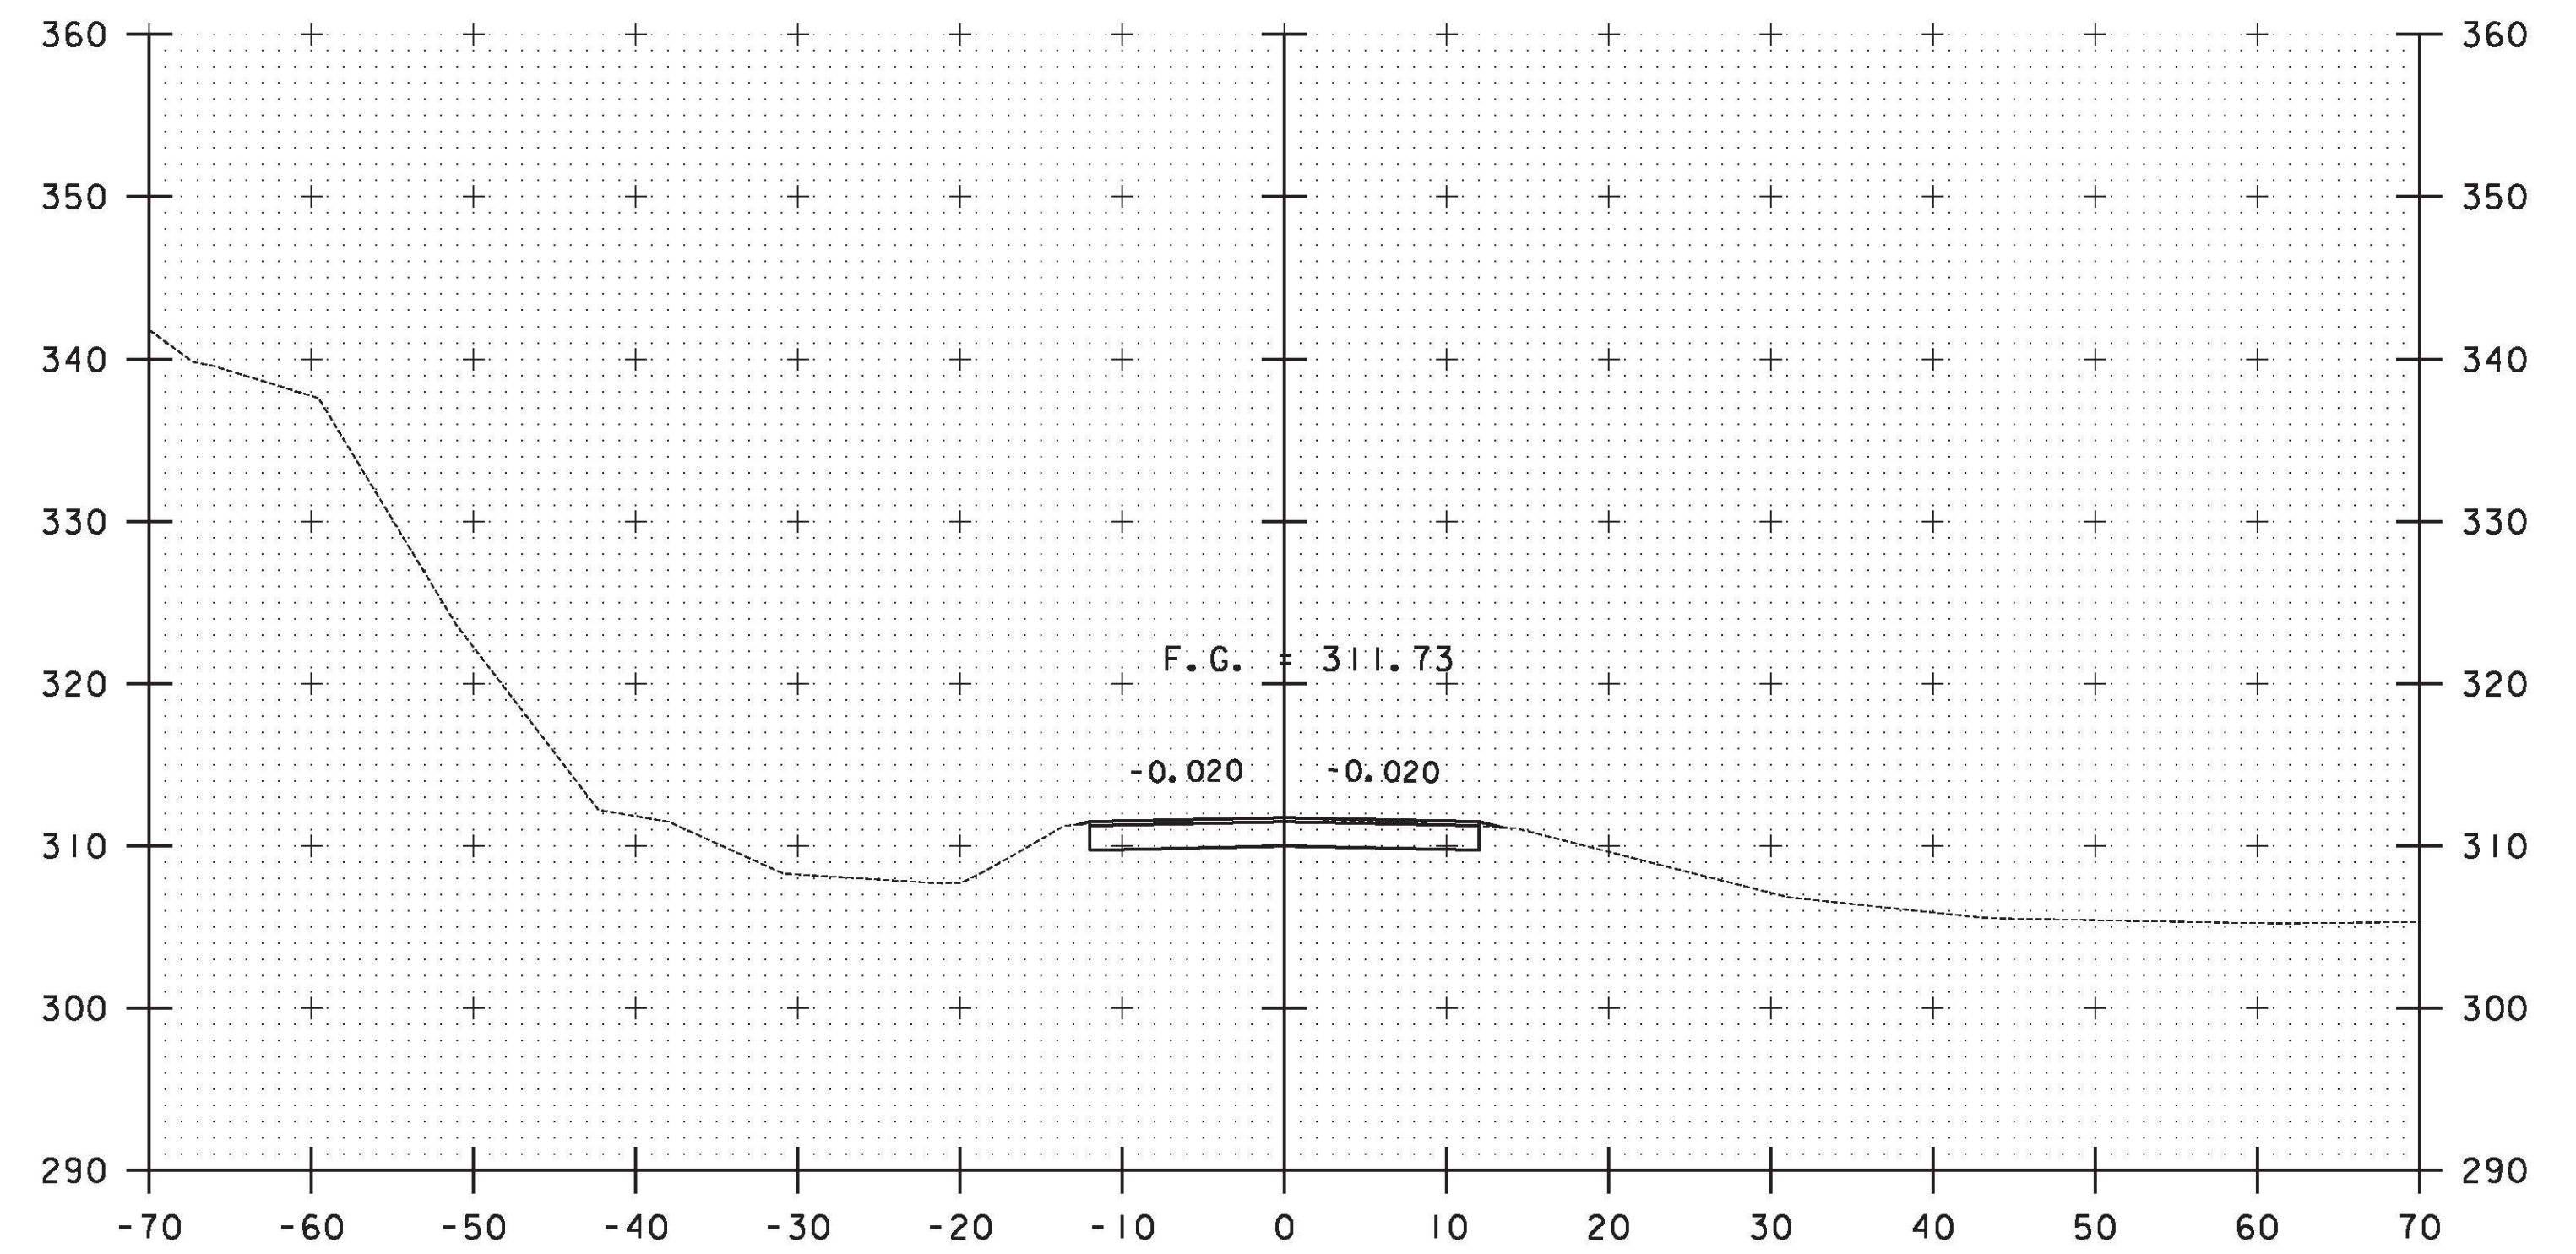

DK 11+50

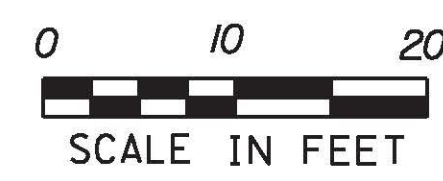

<b>CROSS SECTIONS SHEET #10</b>	PROJECT NAME: RICHMOND	PLOT DATE: 6/17/2011
	PROJECT NUMBER: STP-RS 0284(III)	DRAWN BY: C.A.K.
	FILE NAME:	CHECKED BY: D.E.G.
	PROJECT LEADER: D.E.G.	SHEET 29 OF 29
	DESIGNED BY: B.T.H.	
	DWG. NO.: XS-10	