


FILE NAME = v:\projects\env\22276\cadd\mstr\ubs (1-5) erosion\90c092\_exc\_04\_15.dgn  
 DATE/TIME = 3/16/2011  
 USER = 3066

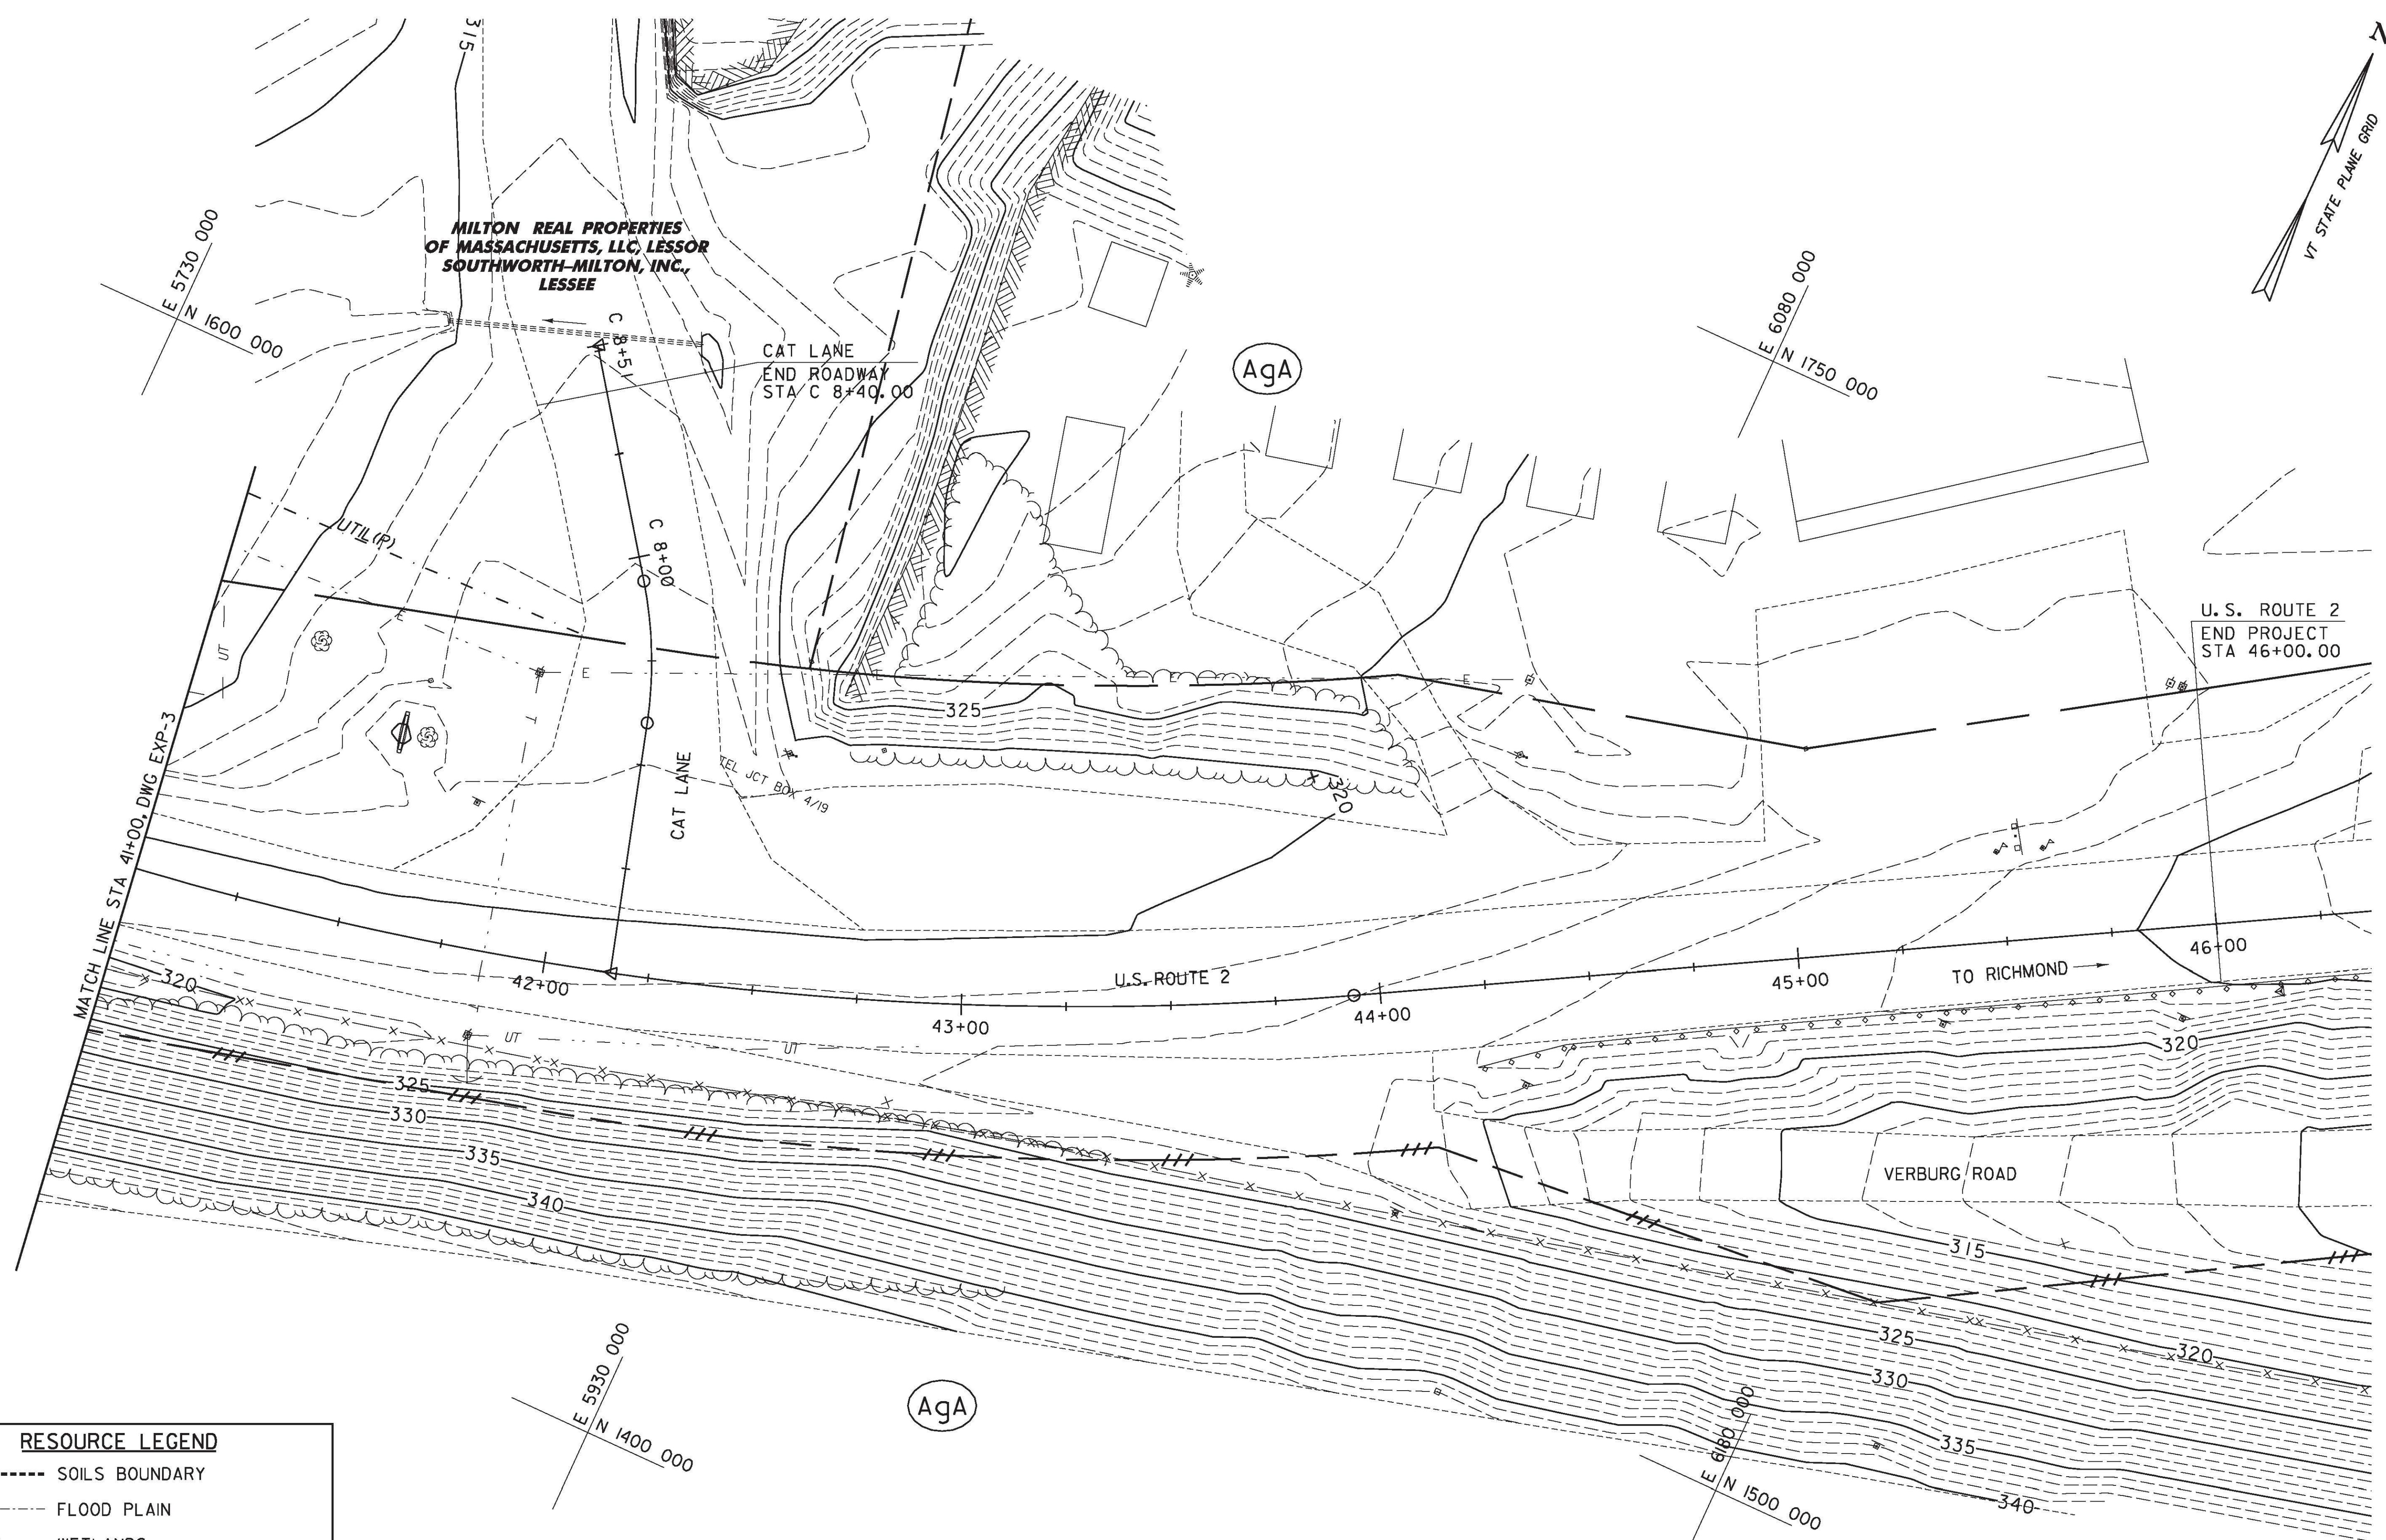

MILTON REAL PROPERTIES  
 OF MASSACHUSETTS, LLC, LESSOR  
 SOUTHWORTH-MILTON, INC.,  
 LESSEE

CAT LANE  
 END ROADWAY  
 STA C 8+40.00

U.S. ROUTE 2  
 END PROJECT  
 STA 46+00.00

VERBURG ROAD

**RESOURCE LEGEND**

- SOILS BOUNDARY
- FLOOD PLAIN
- ▲ WETLANDS
- WETLAND BUFFER ZONE
- AG — AGRICULTURAL LAND
- (XX) SOIL MAP UNIT SYMBOL  
(SEE SHEET 2 FOR DETAILS)

**EXISTING  
 CONDITIONS  
 PLAN**

PROJECT NAME: RICHMOND	PLOT DATE: 3/16/2011
PROJECT NUMBER: STP-RS 0284(III)	DRAWN BY: C.A.K.
FILE NAME: z90c092_exc_04_15.dgn	CHECKED BY: D.E.G.
PROJECT LEADER: D.E.G.	SHEET II OF 27
DESIGNED BY: B.T.H.	
DWG. NO.: EXP-4	

