



FILE NAME = v:\projects\erect\erect\mstr\ubs (1-5) erosion\290c092.ec.pl02_15.dgn
 DATE/TIME = 3/16/2011
 USER = 3066

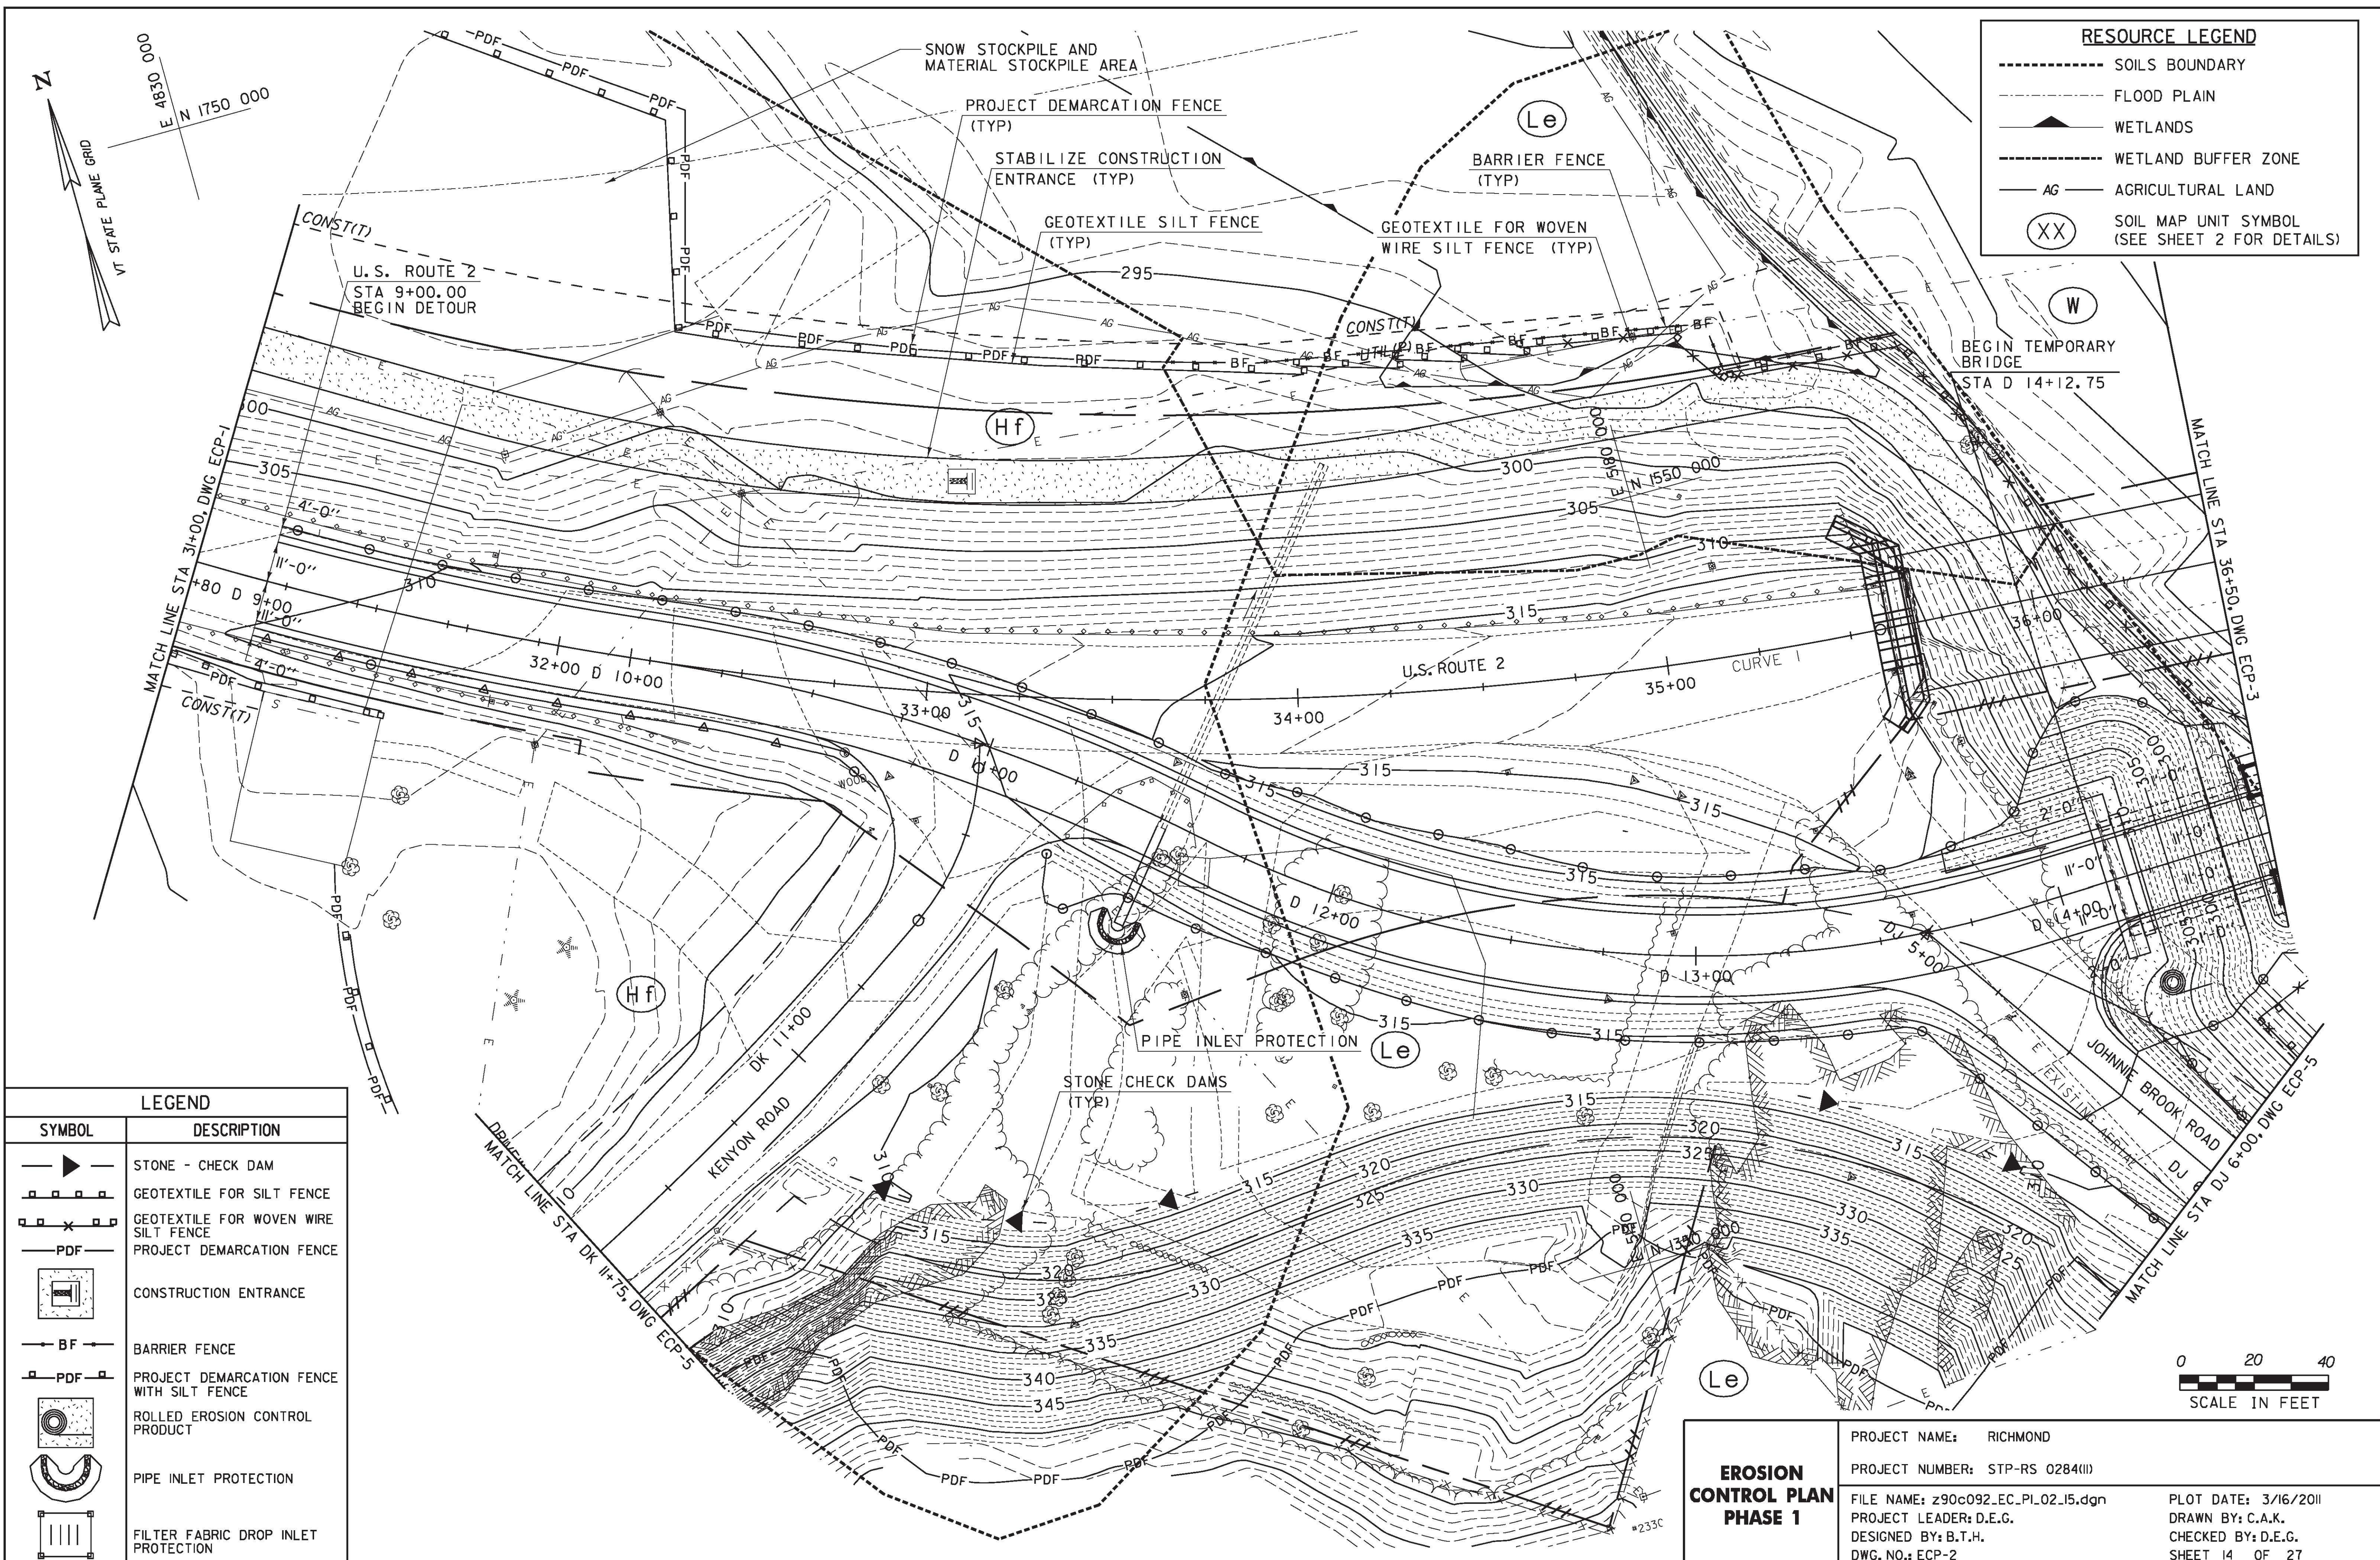

RESOURCE LEGEND	
-----	SOILS BOUNDARY
-----	FLOOD PLAIN
▲	WETLANDS
-----	WETLAND BUFFER ZONE
AG	AGRICULTURAL LAND
(XX)	SOIL MAP UNIT SYMBOL (SEE SHEET 2 FOR DETAILS)

LEGEND	
SYMBOL	DESCRIPTION
▲	STONE - CHECK DAM
□	GEOTEXTILE FOR SILT FENCE
□	GEOTEXTILE FOR WOVEN WIRE SILT FENCE
PDF	PROJECT DEMARCATION FENCE
□	CONSTRUCTION ENTRANCE
BF	BARRIER FENCE
PDF	PROJECT DEMARCATION FENCE WITH SILT FENCE
○	ROLLED EROSION CONTROL PRODUCT
○	PIPE INLET PROTECTION
□	FILTER FABRIC DROP INLET PROTECTION

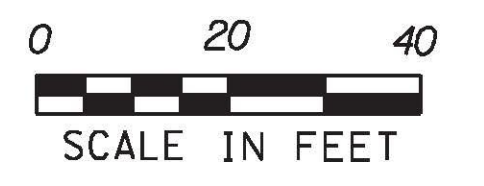

EROSION CONTROL PLAN PHASE 1		
PROJECT NAME:	RICHMOND	
PROJECT NUMBER:	STP-RS 0284(II)	
FILE NAME:	z90c092_EC.PL02_15.dgn	PLOT DATE: 3/16/2011
PROJECT LEADER:	D.E.G.	DRAWN BY: C.A.K.
DESIGNED BY:	B.T.H.	CHECKED BY: D.E.G.
DWG. NO.:	ECP-2	SHEET 14 OF 27