
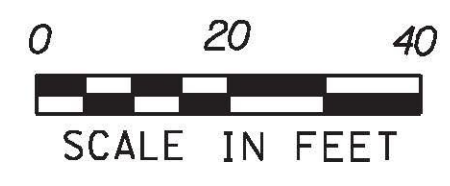


RESOURCE LEGEND	
	SOILS BOUNDARY
	FLOOD PLAIN
	WETLANDS
	WETLAND BUFFER ZONE
	AGRICULTURAL LAND
	SOIL MAP UNIT SYMBOL (SEE SHEET 2 FOR DETAILS)

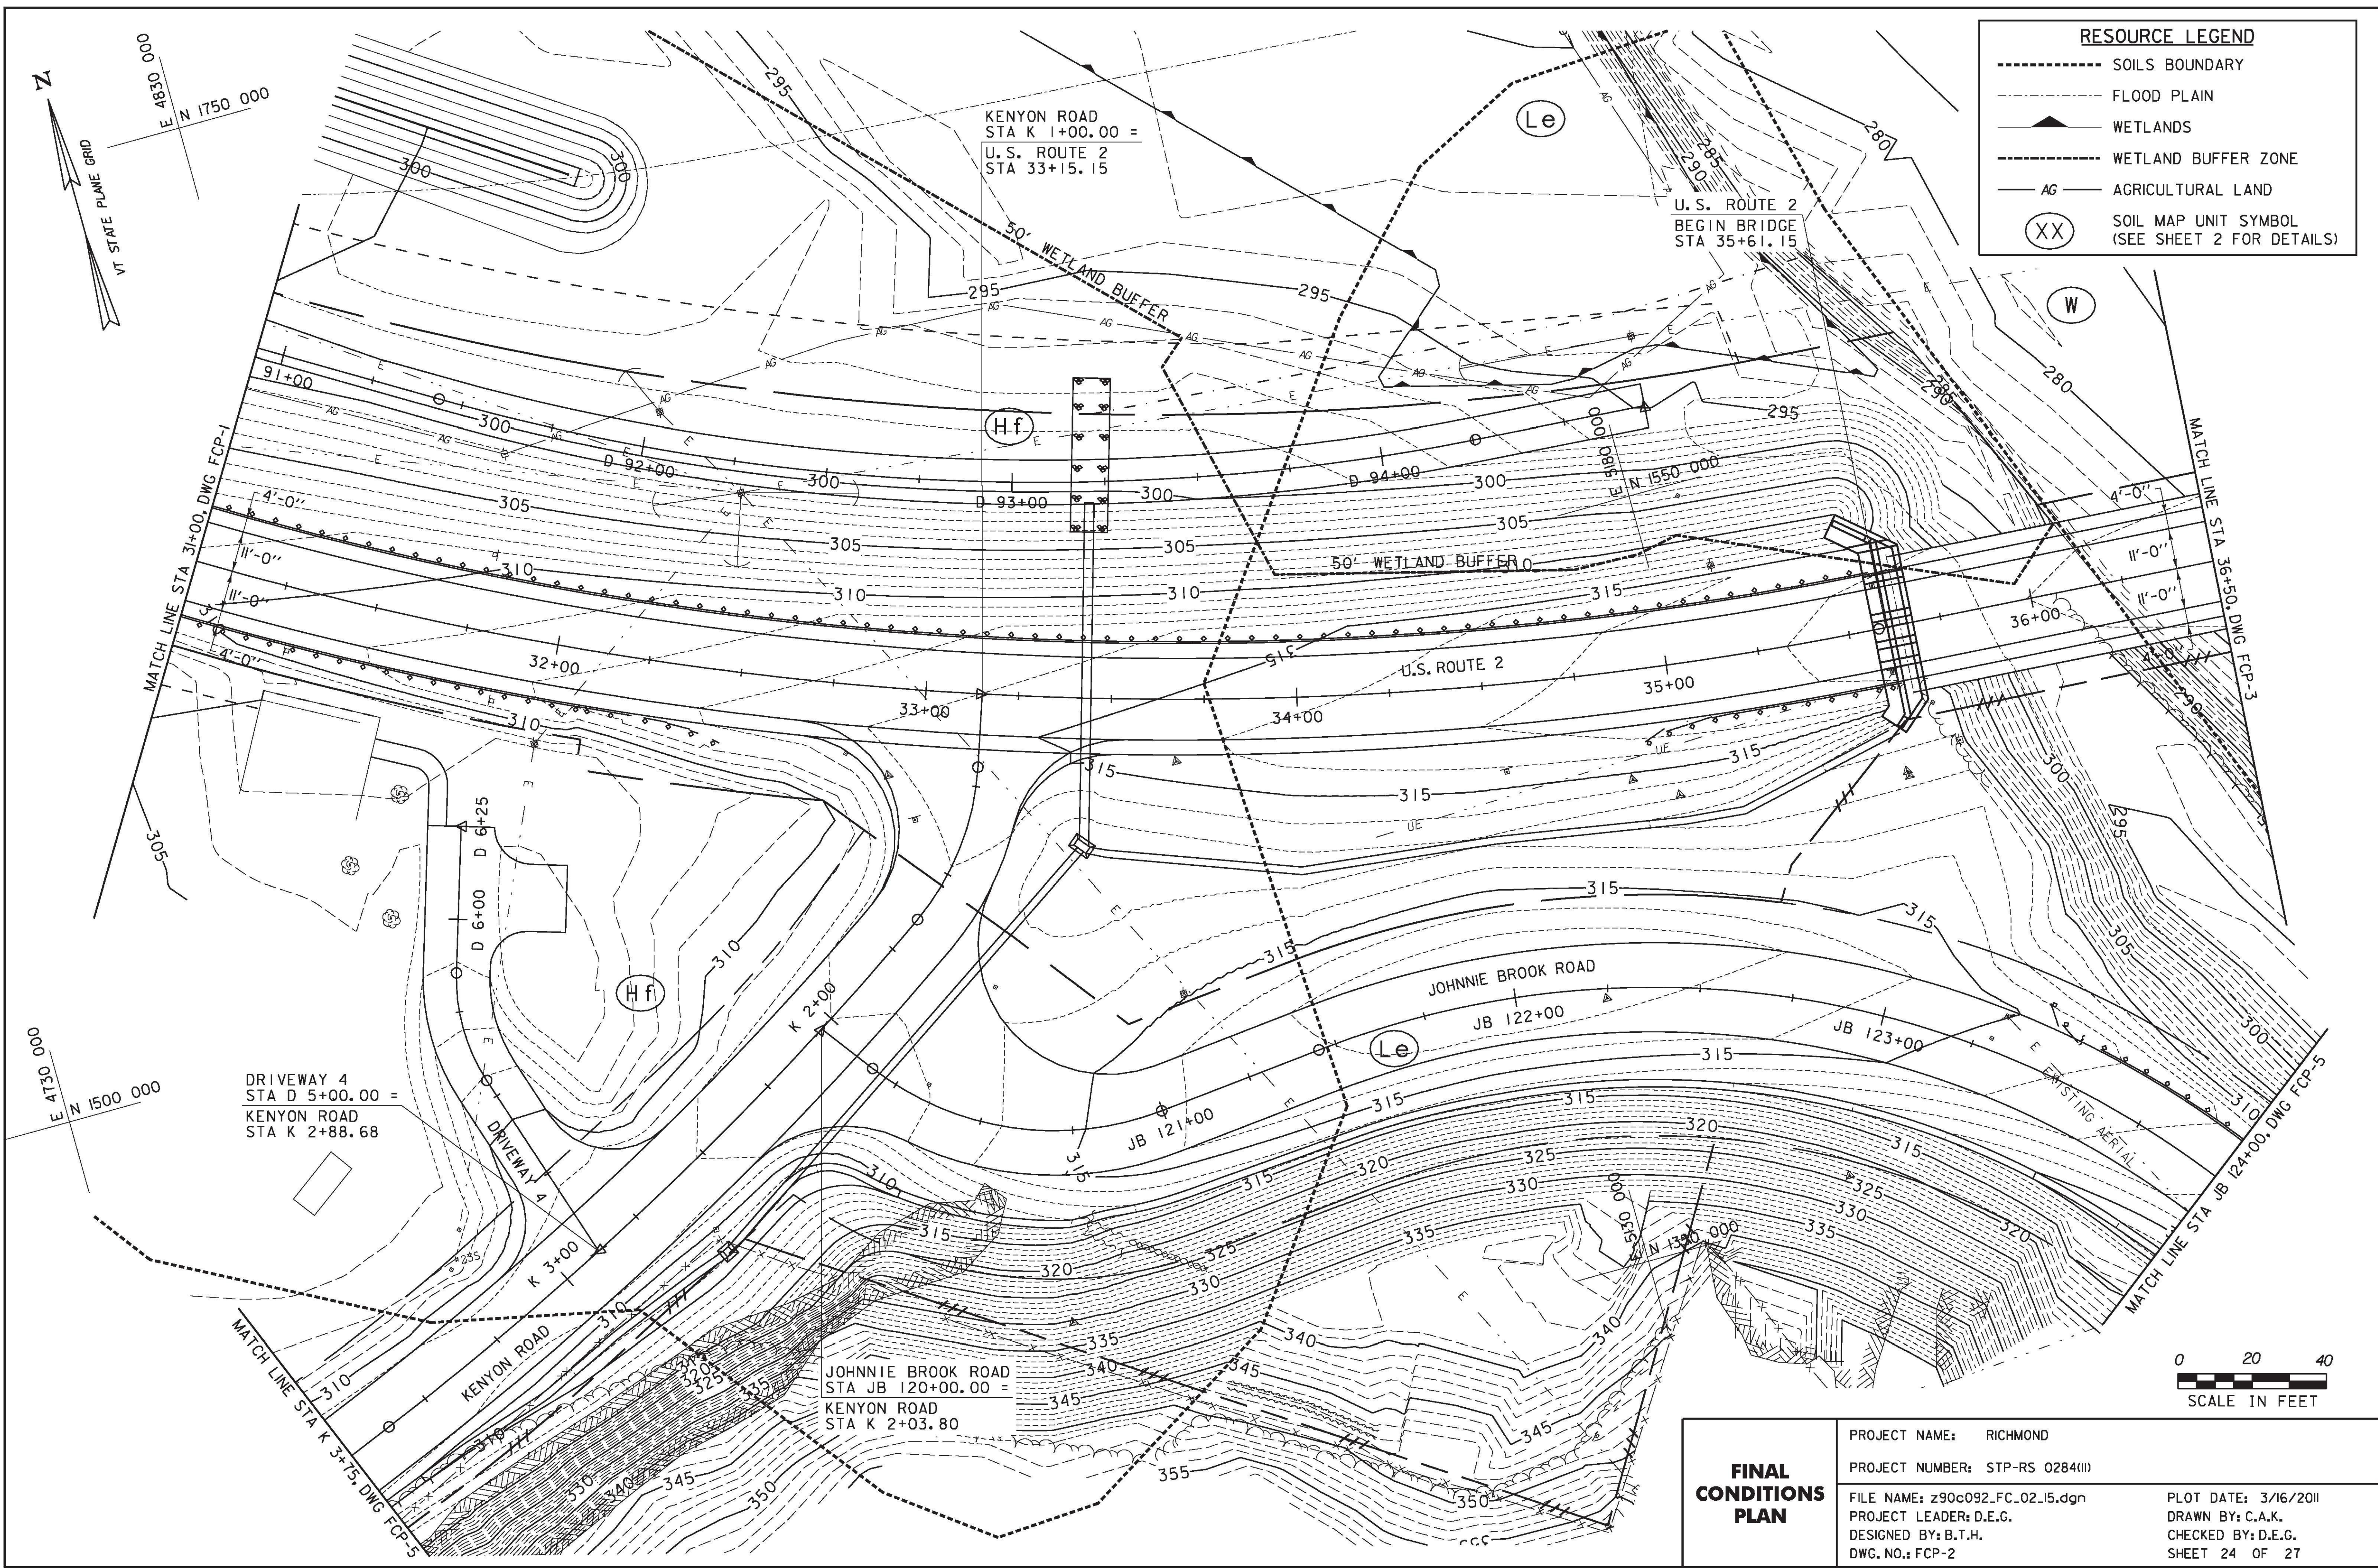

FILE NAME = v:\projects\env\222876\cadd\mstr\ubs (1-5) erosion\490c092\_FC\_02\_15.dgn  
 DATE/TIME = 3/16/2011  
 USER = 3066

<b>FINAL CONDITIONS PLAN</b>	PROJECT NAME: RICHMOND	PLOT DATE: 3/16/2011
	PROJECT NUMBER: STP-RS 0284(II)	DRAWN BY: C.A.K.
	FILE NAME: z90c092_FC_02_15.dgn	CHECKED BY: D.E.G.
	DESIGNED BY: B.T.H.	SHEET 24 OF 27
	DWG. NO.: FCP-2	