



FILE NAME = v:\projects\envy\22276\cadd\mstr\ubs (1-5) erosion\490c092\_FC\_04\_15.dgn  
 DATE/TIME = 3/16/2011  
 USER = 3066

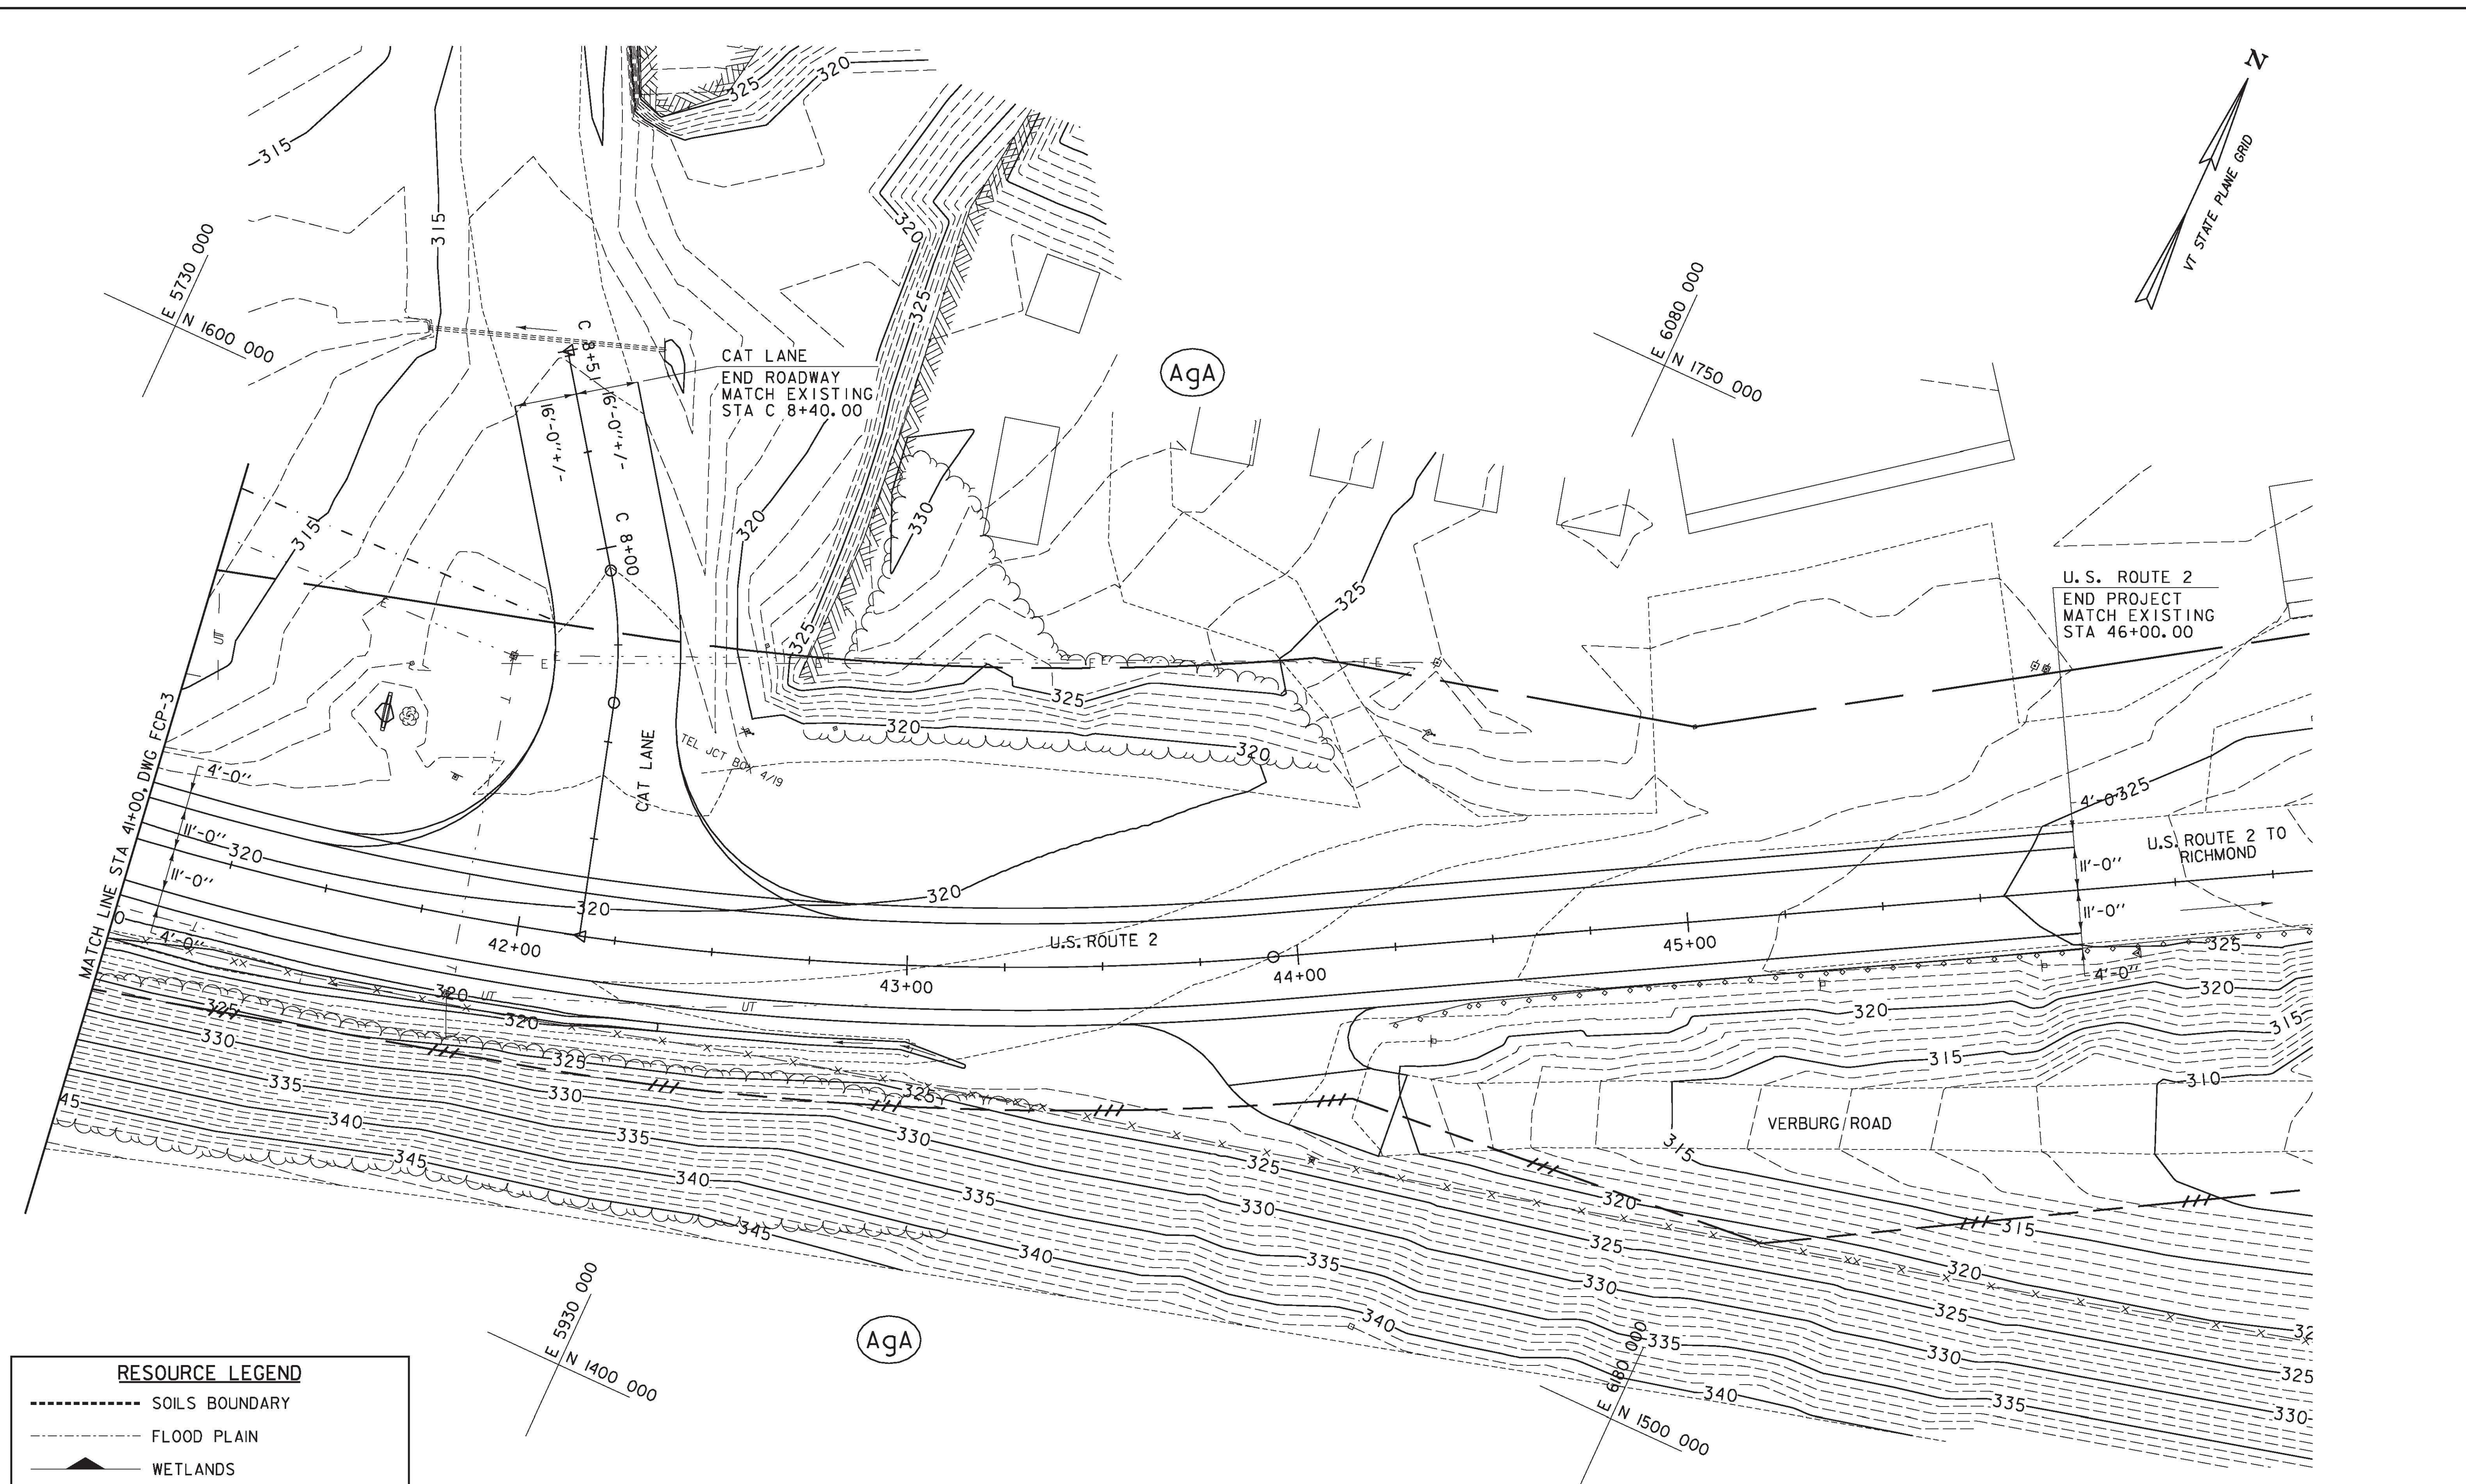

RESOURCE LEGEND	
	SOILS BOUNDARY
	FLOOD PLAIN
	WETLANDS
	WETLAND BUFFER ZONE
	AGRICULTURAL LAND
	SOIL MAP UNIT SYMBOL (SEE SHEET 2 FOR DETAILS)

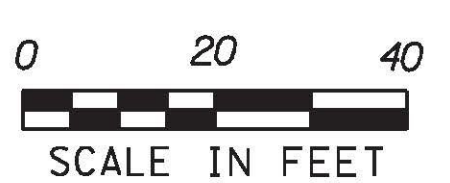

FINAL CONDITIONS PLAN	
PROJECT NAME:	RICHMOND
PROJECT NUMBER:	STP-RS 0284(II)
FILE NAME:	z90c092_FC_04_15.dgn
PROJECT LEADER:	D.E.G.
DESIGNED BY:	B.T.H.
DWG. NO.:	FCP-4
PLOT DATE:	3/16/2011
DRAWN BY:	C.A.K.
CHECKED BY:	D.E.G.
SHEET	26 OF 27