


KENYON ROAD
END ROADWAY
MATCH EXISTING
STA K 4+60.00

JOHNNIE BROOK ROAD
END ROADWAY
MATCH EXISTING
STA JB 126+50.00

RESOURCE LEGEND

- SOILS BOUNDARY
- FLOOD PLAIN
- ▲ WETLANDS
- WETLAND BUFFER ZONE
- AG — AGRICULTURAL LAND
- (XX) SOIL MAP UNIT SYMBOL
(SEE SHEET 2 FOR DETAILS)

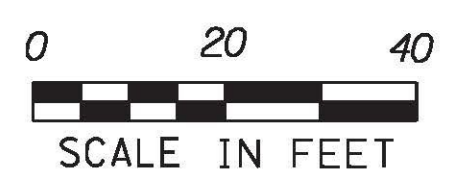

**FINAL
CONDITIONS
PLAN**

PROJECT NAME: RICHMOND	PLOT DATE: 3/16/2011
PROJECT NUMBER: STP-RS 0284(II)	DRAWN BY: C.A.K.
FILE NAME: z90c092_FC_05_15.dgn	CHECKED BY: D.E.G.
PROJECT LEADER: D.E.G.	SHEET 27 OF 27
DESIGNED BY: B.T.H.	
DWG. NO.: FCP-5	

FILE NAME = v:\projects\keny\k2\22876\ecadd\mstr\ubs (1-5) erosion\z90c092_FC_05_15.dgn
 DATE/TIME = 3/16/2011 10:58:00
 USER = 3066