


COLOR: BLACK BORDER & LEGEND  
YELLOW BACKGROUND (RETROREFLECTIVE)

MATERIAL: PER VAOT STANDARD E-151


LOCATION: US ROUTE 2  
RICHMOND:  
STA 25+25.0, RT

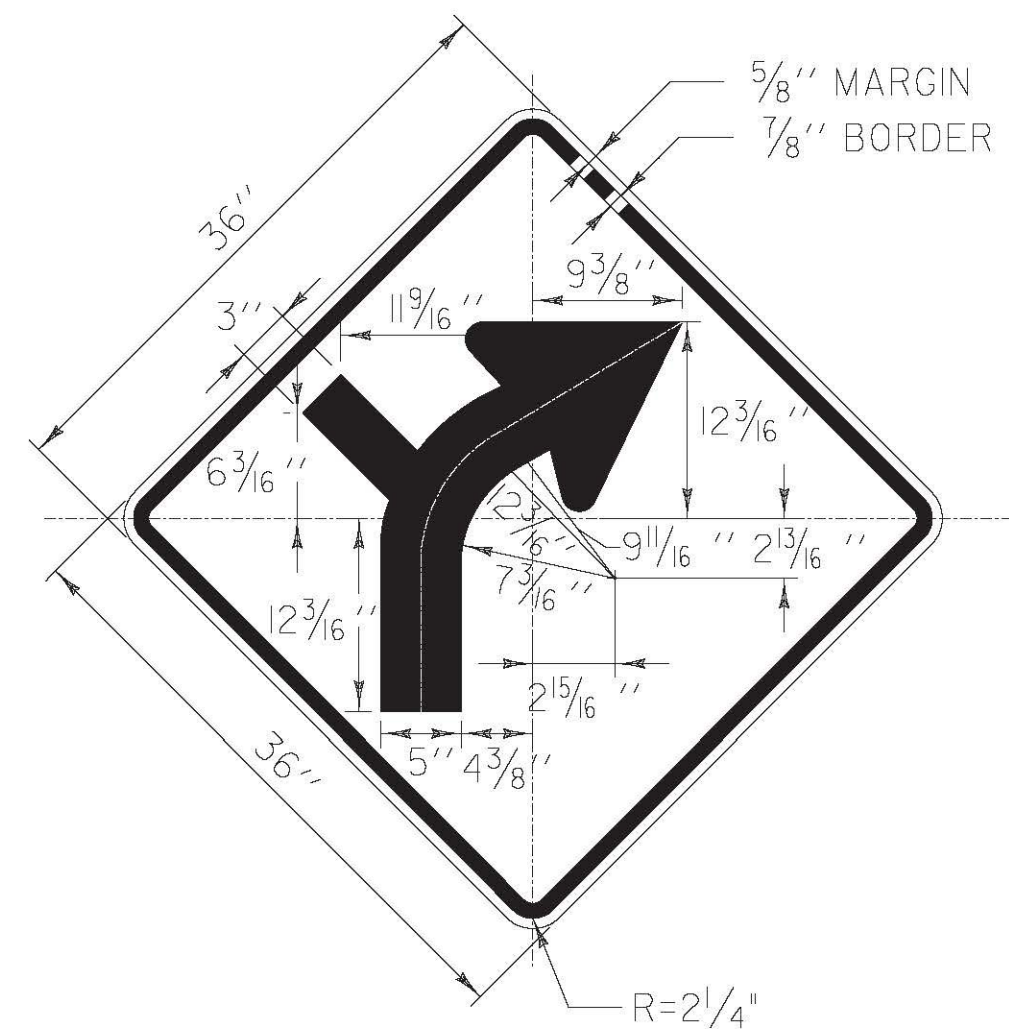

COLOR: BLACK BORDER & LEGEND  
YELLOW BACKGROUND (RETROREFLECTIVE)

MATERIAL: PER VAOT STANDARD E-151


LOCATION: US ROUTE 2  
RICHMOND:  
STA 44+31.9, RT  
STA 45+50.0, LT

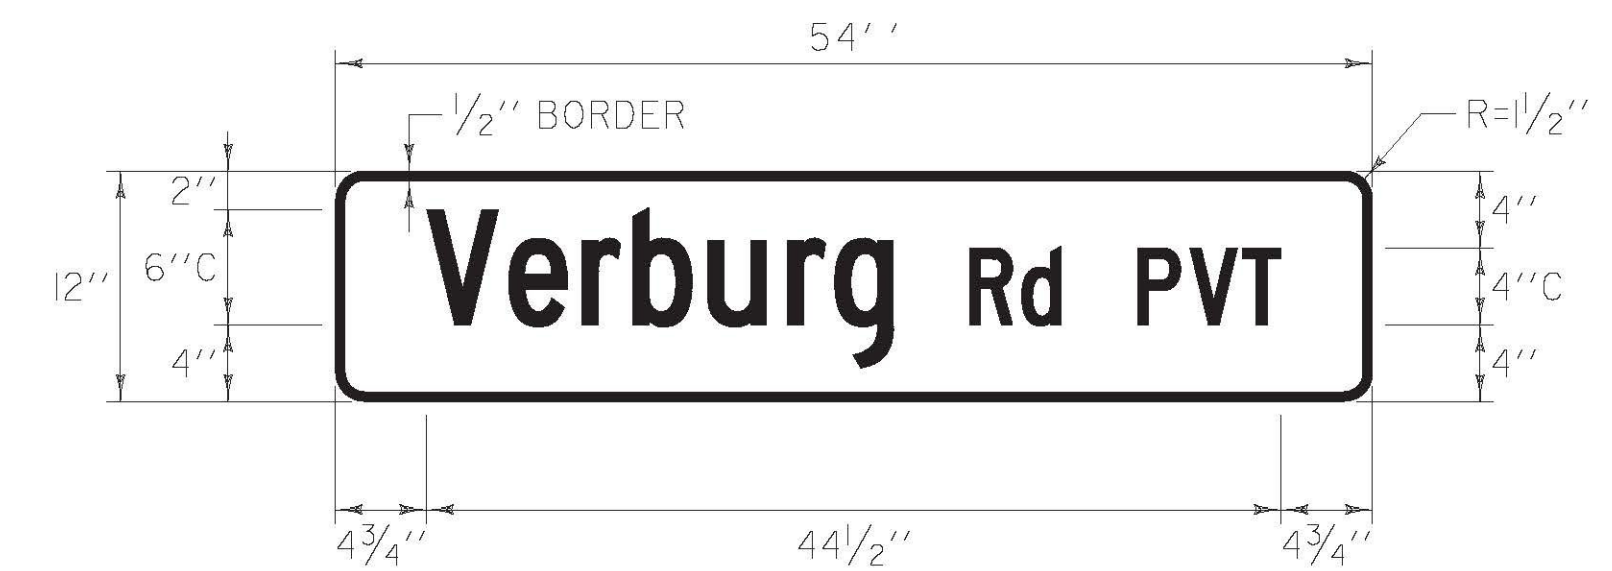

COLOR: WHITE BORDER & TEXT (REFLECTORIZED)  
GREEN BACKGROUND (REFLECTORIZED)

MATERIAL: PER VAOT STANDARD E-123


LOCATION: U.S. ROUTE 2  
RICHMOND:  
STA 44+17.0, RT

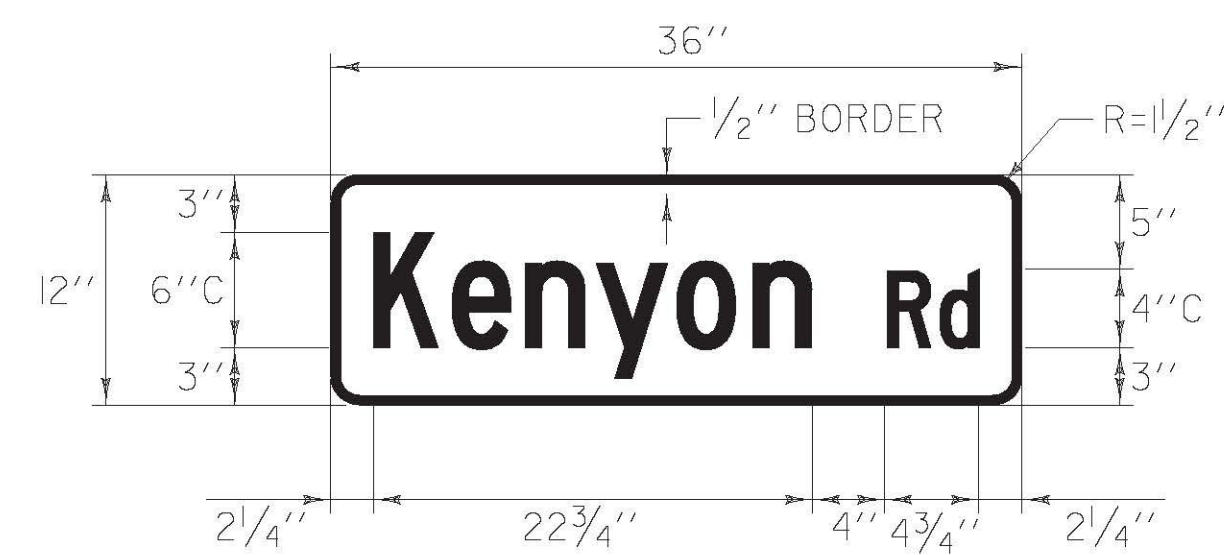

COLOR: WHITE BORDER & TEXT (REFLECTORIZED)  
GREEN BACKGROUND (REFLECTORIZED)

MATERIAL: PER VAOT STANDARD E-123


LOCATION: KENYON ROAD  
RICHMOND:  
STA K 1+25.0, RT

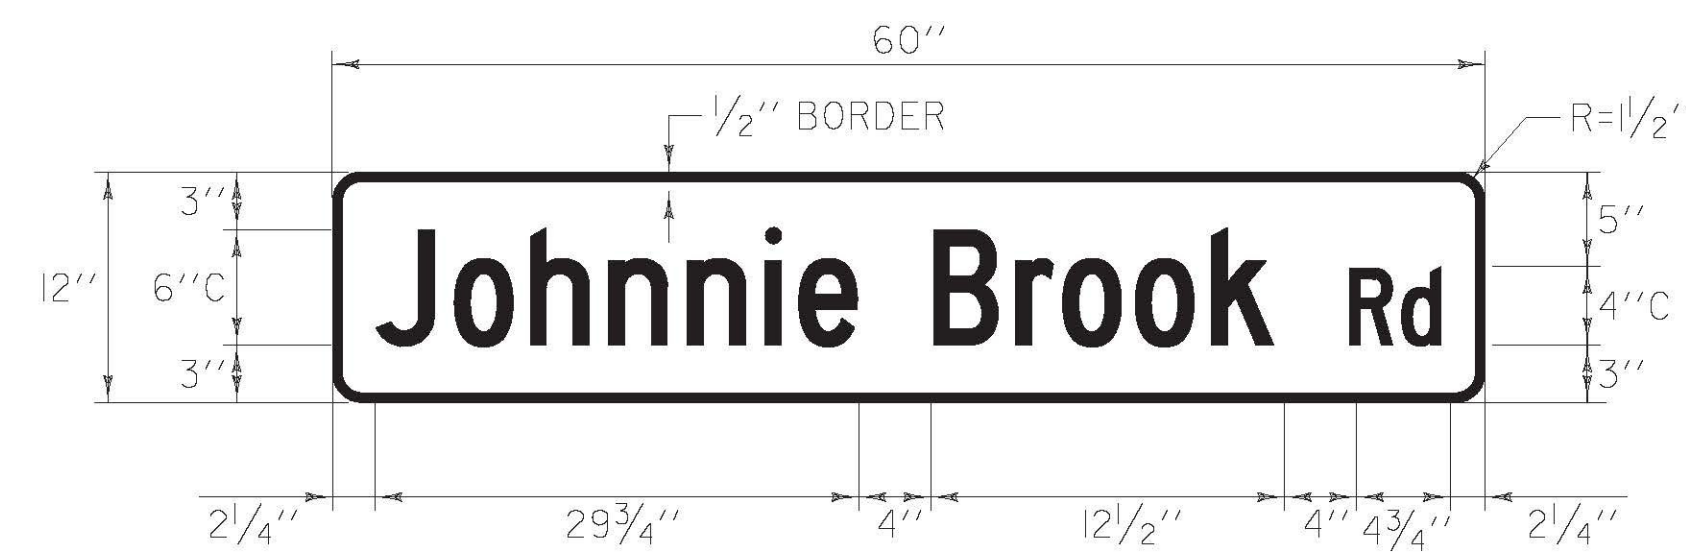

COLOR: WHITE BORDER & TEXT (REFLECTORIZED)  
GREEN BACKGROUND (REFLECTORIZED)

MATERIAL: PER VAOT STANDARD E-123

LOCATION: JOHNNIE BROOK ROAD  
RICHMOND:  
STA JB 120+25.0, LT

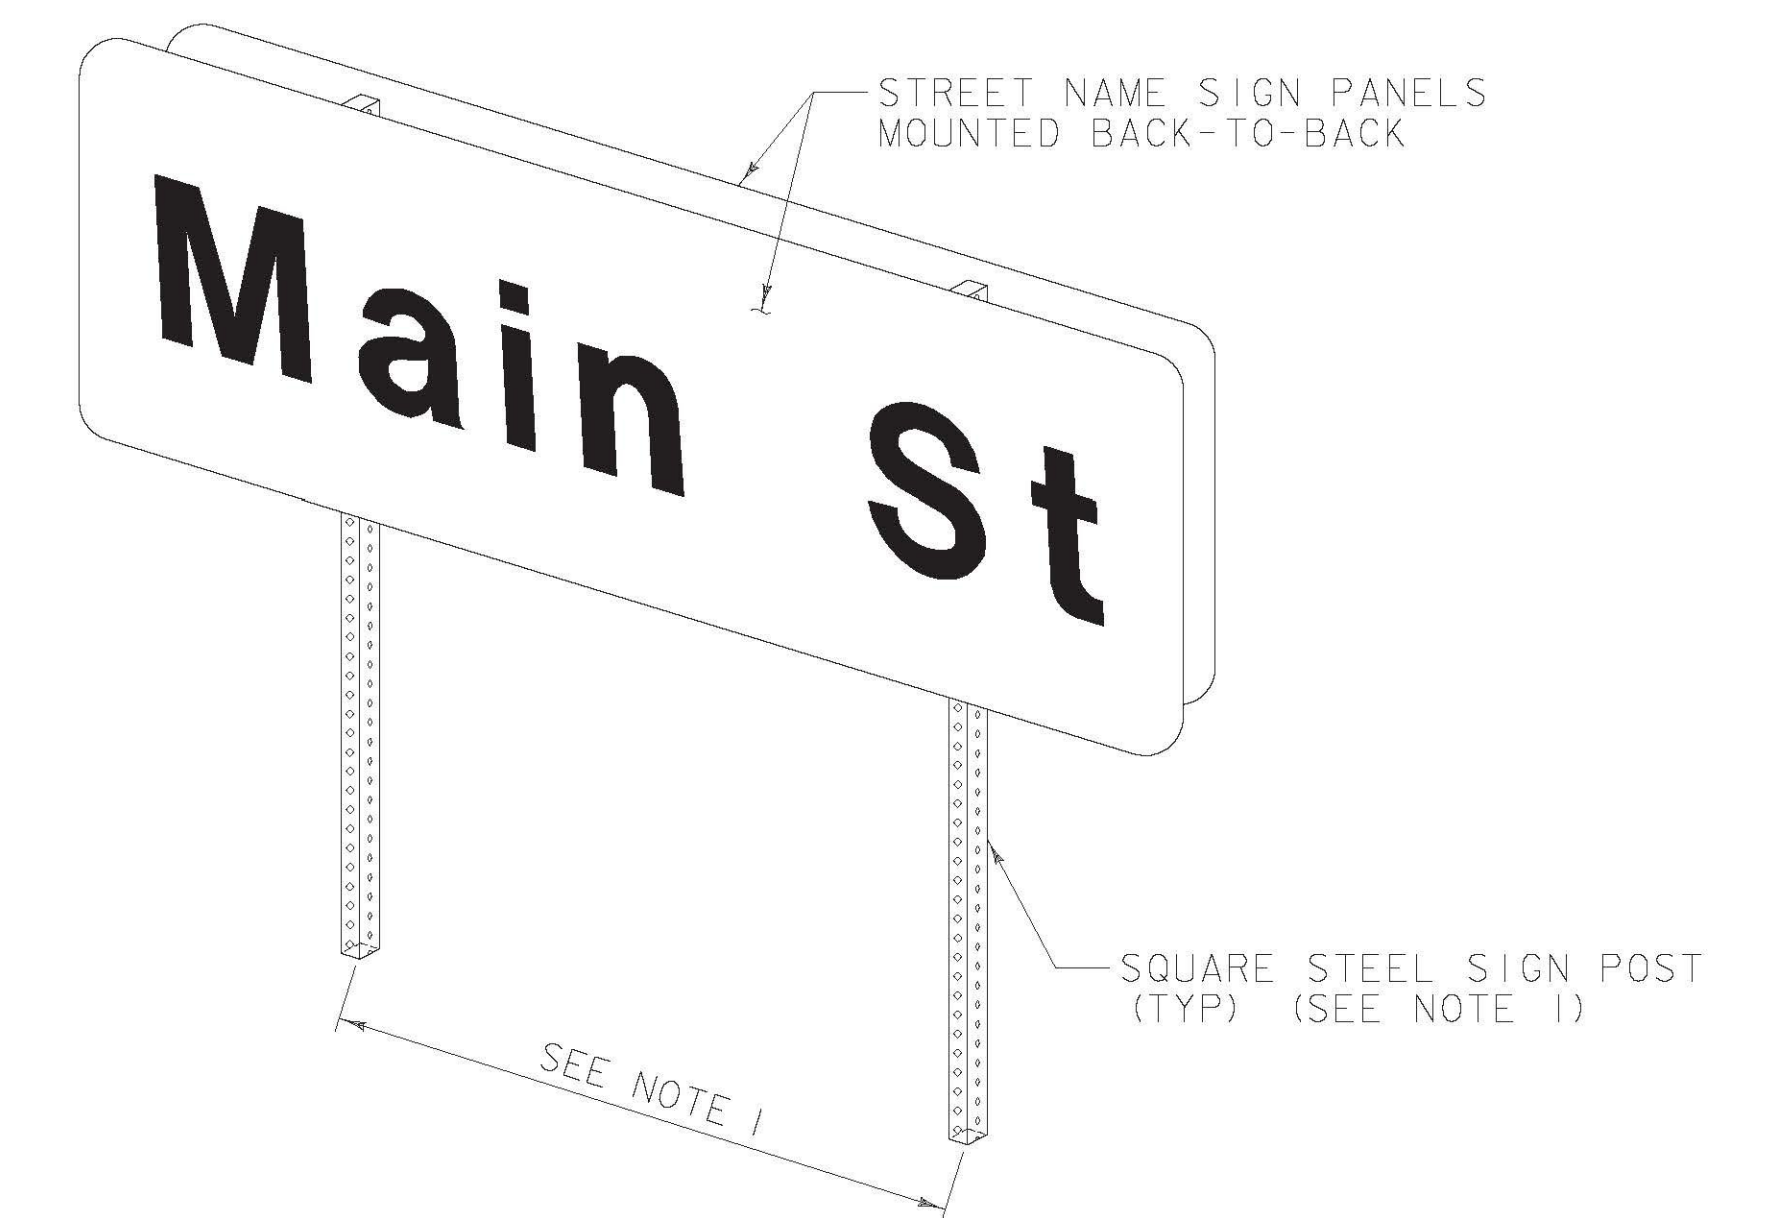

**TWO POST STREET NAME SIGN INSTALLATION  
FOR STREET NAME >48"**

NOTE:  
1. SEE VAOT STD E-164 FOR SQUARE STEEL SIGN  
POST DETAILS & POST SPACING REQUIREMENTS.

FILE NAME = v:\projects\keny\k2\22076\ceadd\mstr\shs (1-18) str\sign\z90a092.tsd.01.dgn  
DATE/TIME = 4/20/2011 10:58:00 AM  
USER = j3026

X	Reviewed	_____	Furnish As Corrected
_____	Rejected	_____	Revise and Resubmit
<p>This review is only for general conformance with the design concept and the information given in the Construction Documents. Corrections or comments made on the shop drawings during the review do not relieve the Contractor from compliance with the requirements of the Plans and Specifications. Review of a specific item shall not include review of an assembly of which an item is a component. The Contractor is responsible for dimensions to be confirmed and corrected at the job site; information that pertains solely to the fabrication process or to the means, methods, techniques, sequences and procedures of construction; coordination of the Work with that of other trades and performing all Work in a safe and satisfactory manner.</p>			
		Date: 4/21/2011 By: J. Santacruz	

<b>TRAFFIC SIGN DETAIL SHEET</b>	PROJECT NAME: RICHMOND	
	PROJECT NUMBER: STP-RS 0284(III)	
	FILE NAME:	PLOT DATE: 4/20/2011
	PROJECT LEADER: D.E.G. DESIGNED BY: B.T.H. DWG. NO.: TSD-1	DRAWN BY: C.A.K. CHECKED BY: D.E.G. SHEET II OF II