
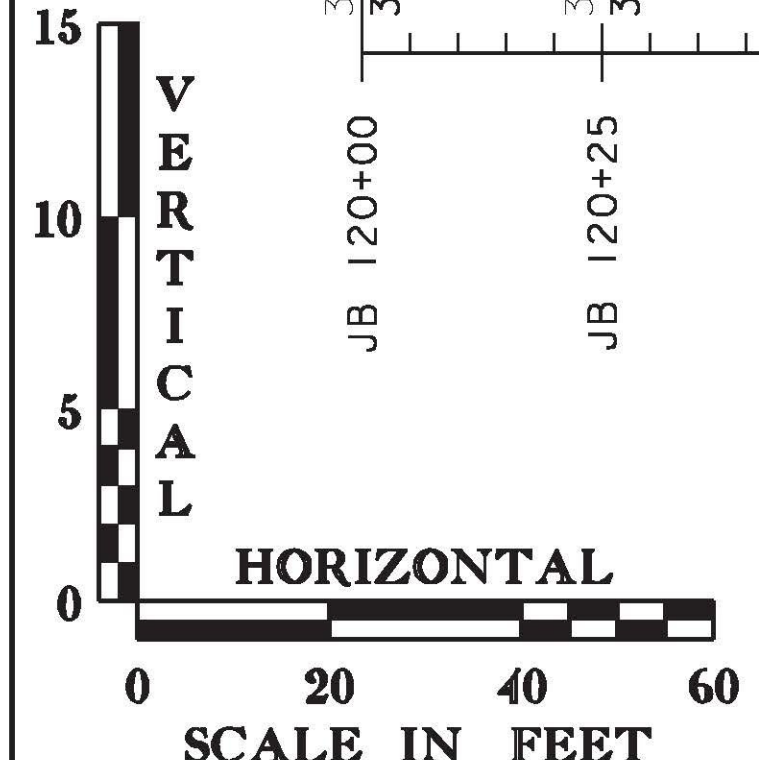
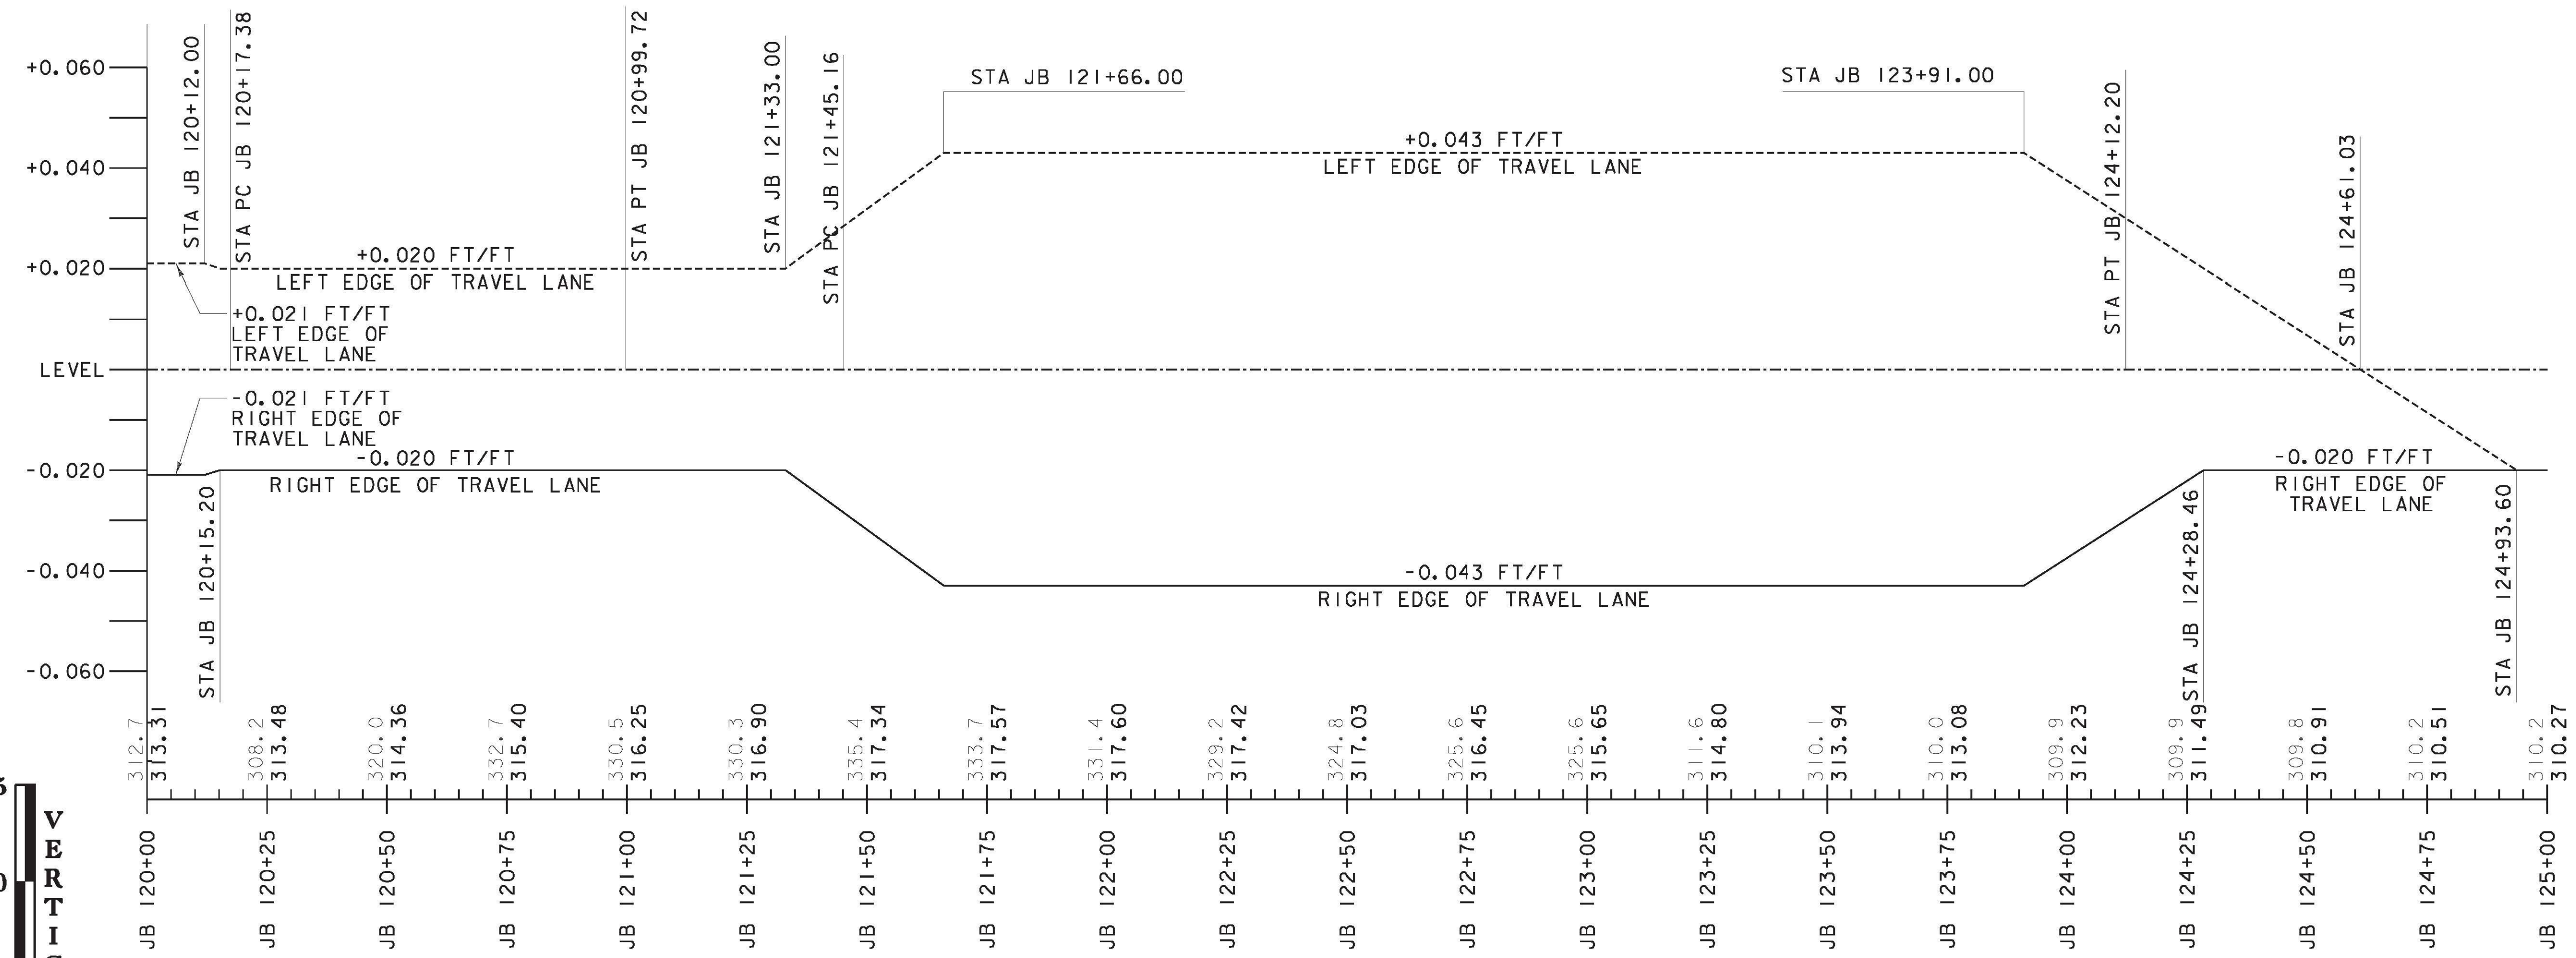


FILE NAME = v:\projects\keny\22276\ceadd\mstr\ubs (1-19)\rock cut\96d092-pro-01.dgn  
 DATE/TIME = 4/13/2011  
 USER = 3066

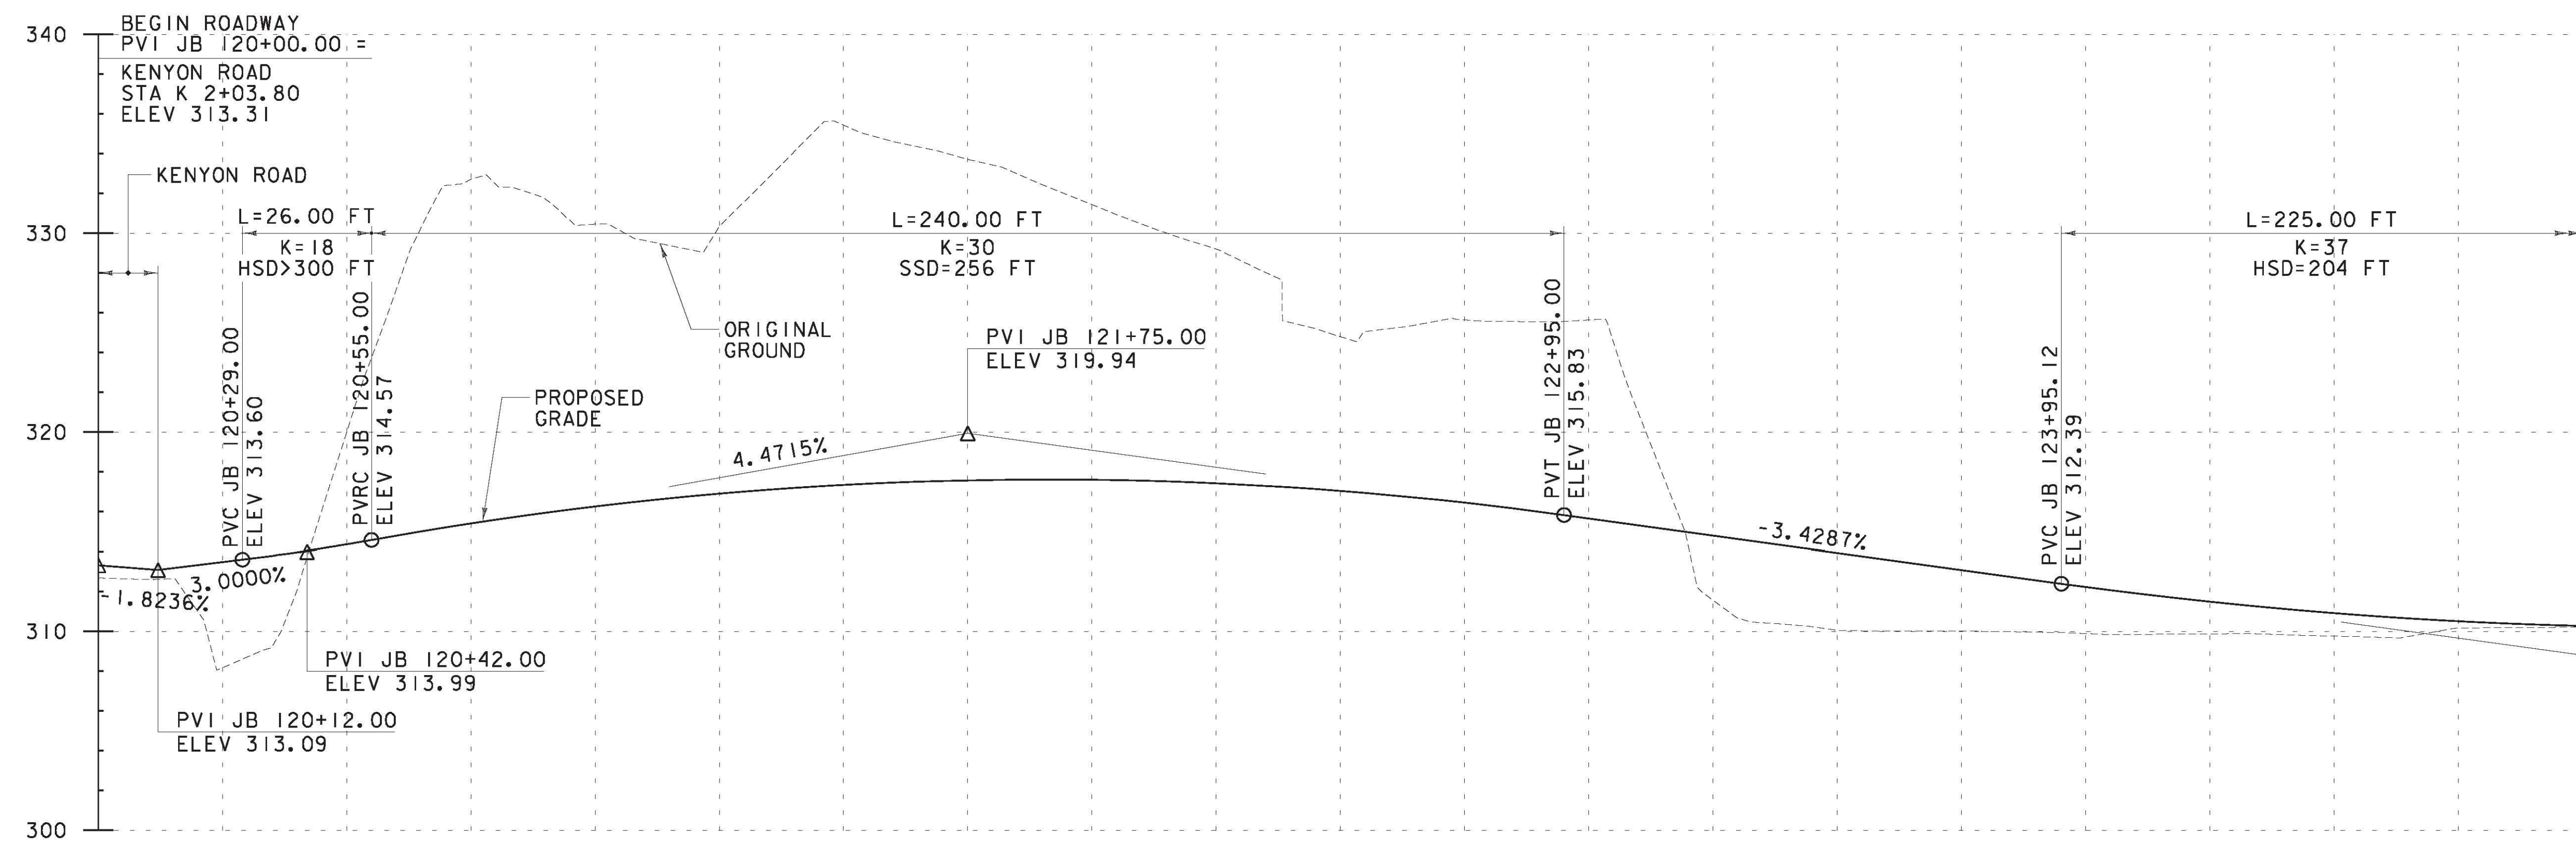

**JOHNNIE BROOK ROAD**

**JOHNNIE BROOK ROAD PROFILE**

PROJECT NAME:	RICHMOND
PROJECT NUMBER:	STP-RS 0284(II)
FILE NAME:	z09c092_pro-01.dgn
PROJECT LEADER:	D.E.G.
DESIGNED BY:	B.T.H.
DWG. NO.:	PR-1
PLOT DATE:	4/13/2011
DRAWN BY:	C.A.K.
CHECKED BY:	D.E.G.
SHEET	4 OF 11