




FILE NAME = v:\projects\enhy\222876\cadd\mstr\ubs (1-19) rock cut\966092_xsl_11.dgn
DATE/TIME = 4/13/2011
USER = 3066

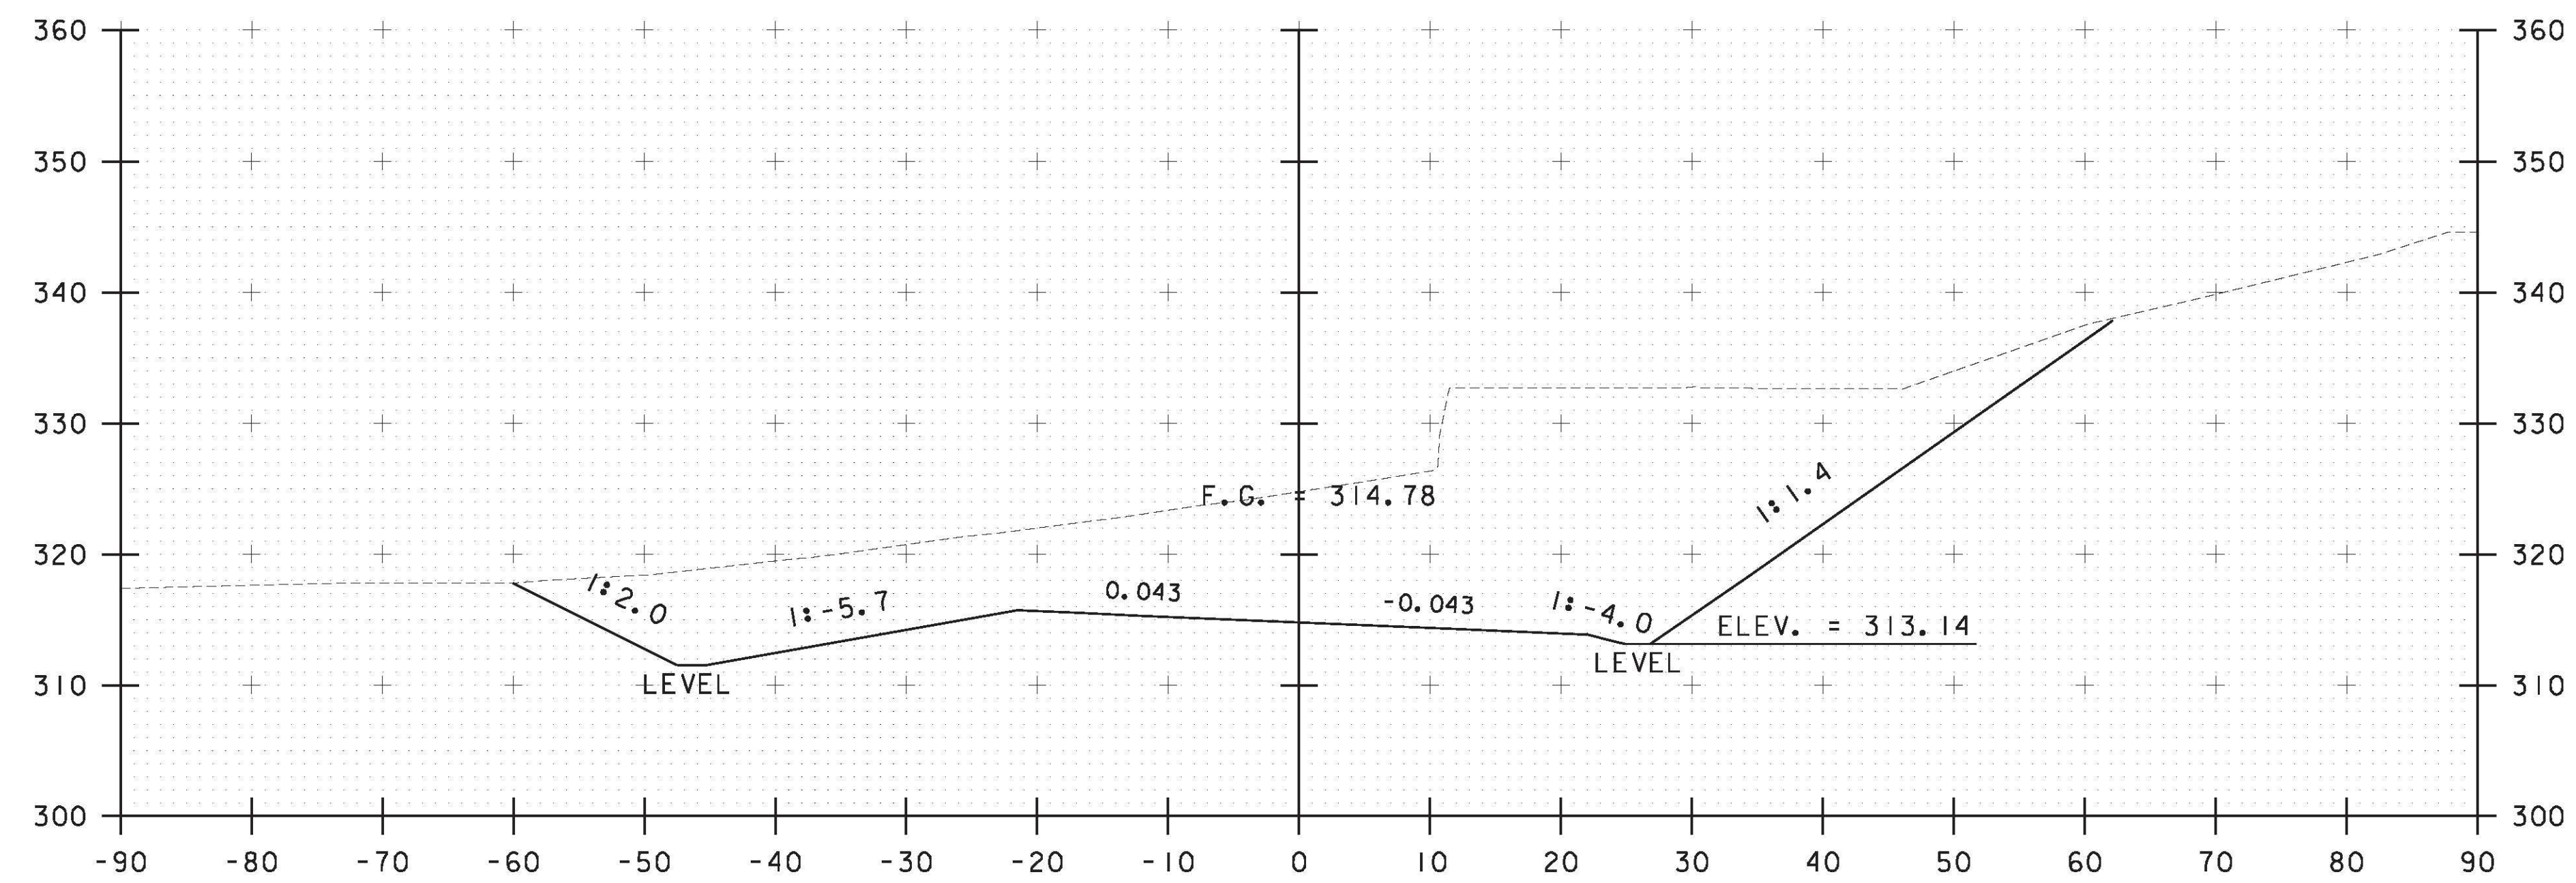

JB 122+50

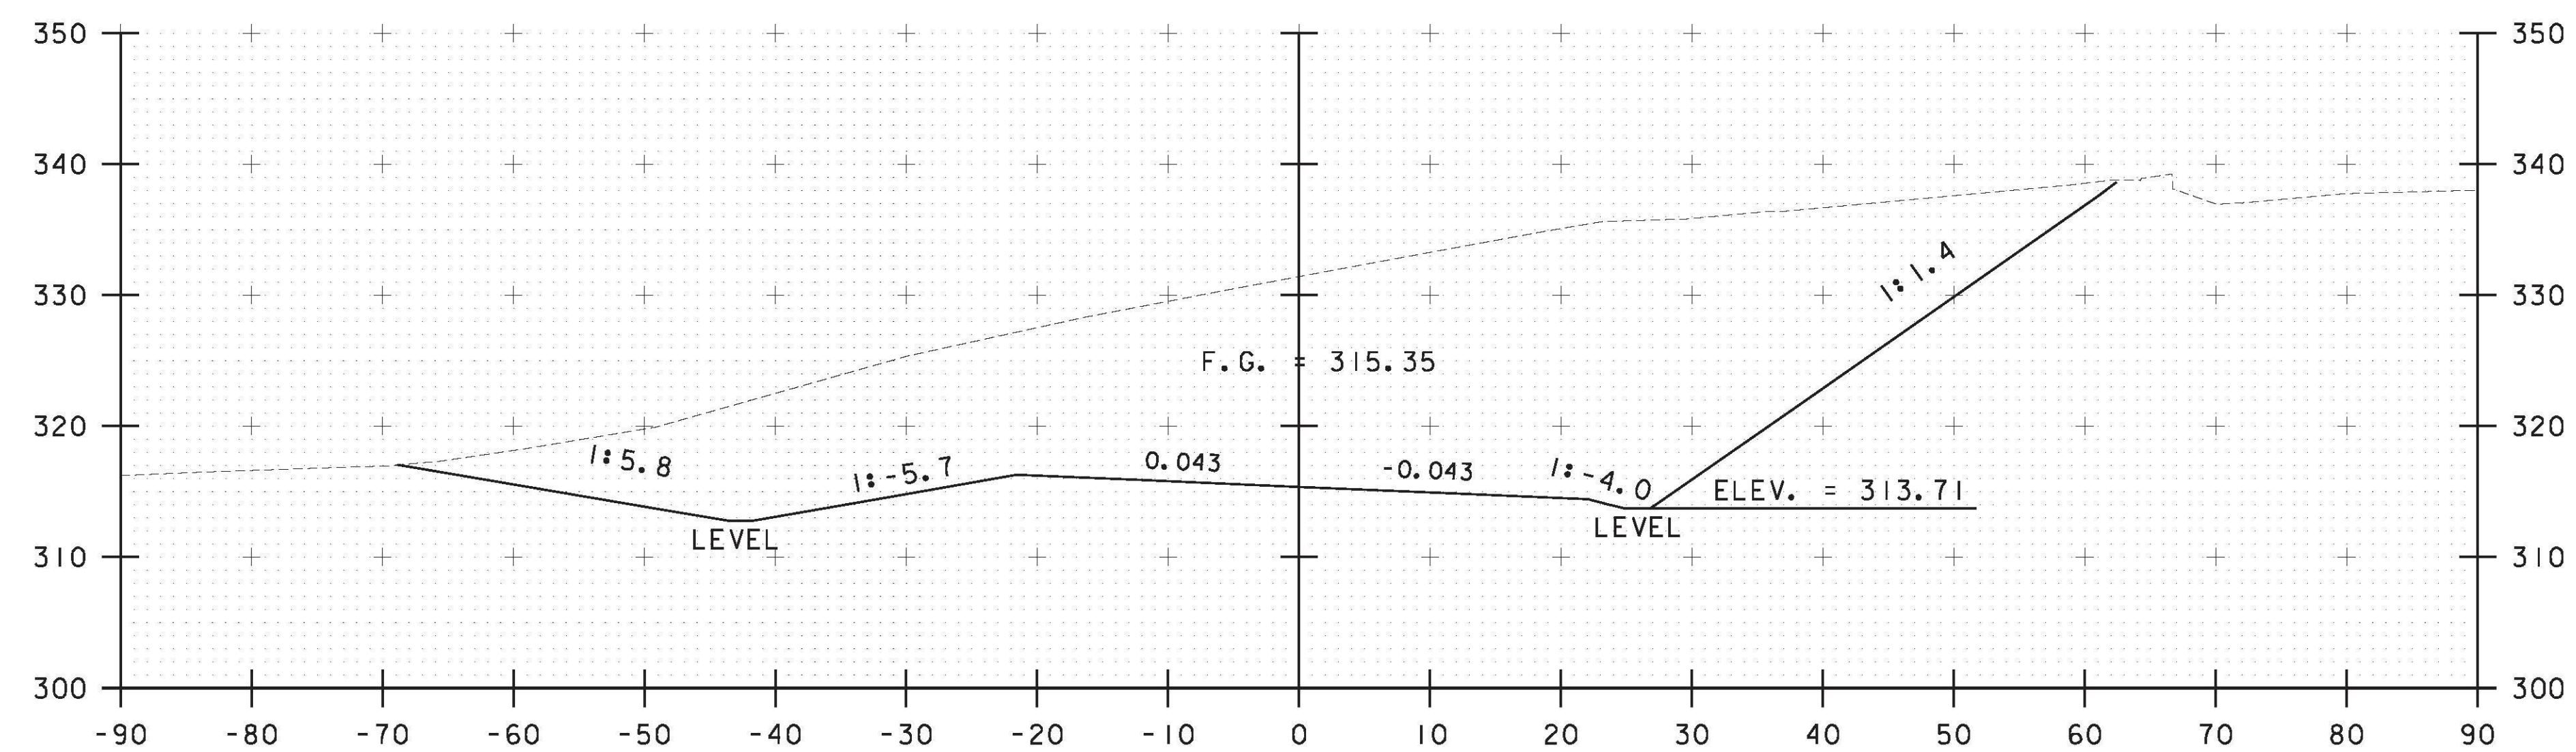

JB 122+00

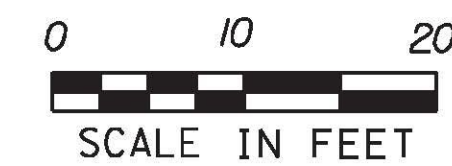

CROSS SECTIONS

PROJECT NAME: RICHMOND	PLOT DATE: 4/13/2011
PROJECT NUMBER: STP-RS 0284(II)	DRAWN BY: C.A.K.
FILE NAME: z90c092_xsl_11.dgn	CHECKED BY: D.E.G.
PROJECT LEADER: D.E.G.	SHEET 8 OF 11
DESIGNED BY: B.T.H.	
DWG. NO.: XS-3	