



PLAN

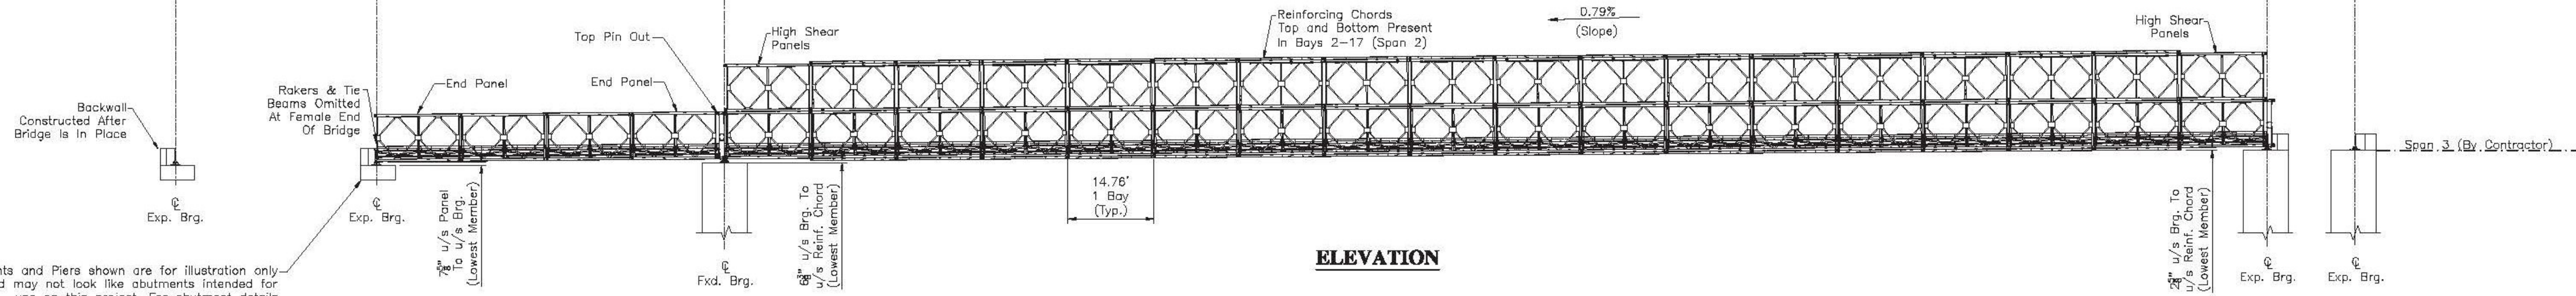


ELEVATION

Abutments and Piers shown are for illustration only and may not look like abutments intended for use on this project. For abutment details see abutment drawing by others.

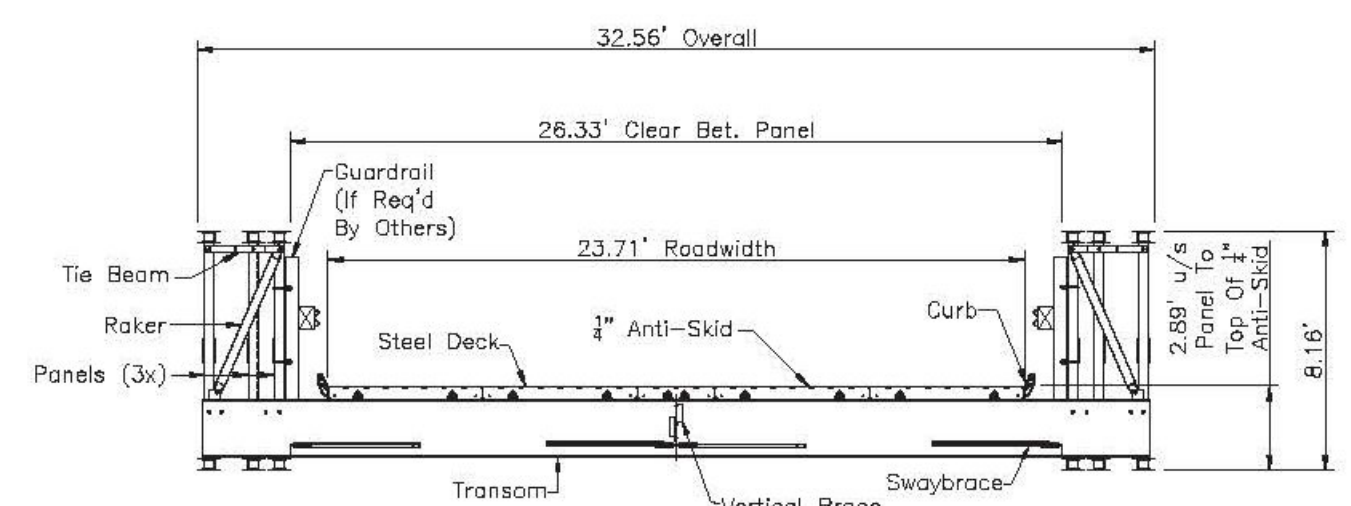

TYPICAL SECTION THRU TS+ TRUSS

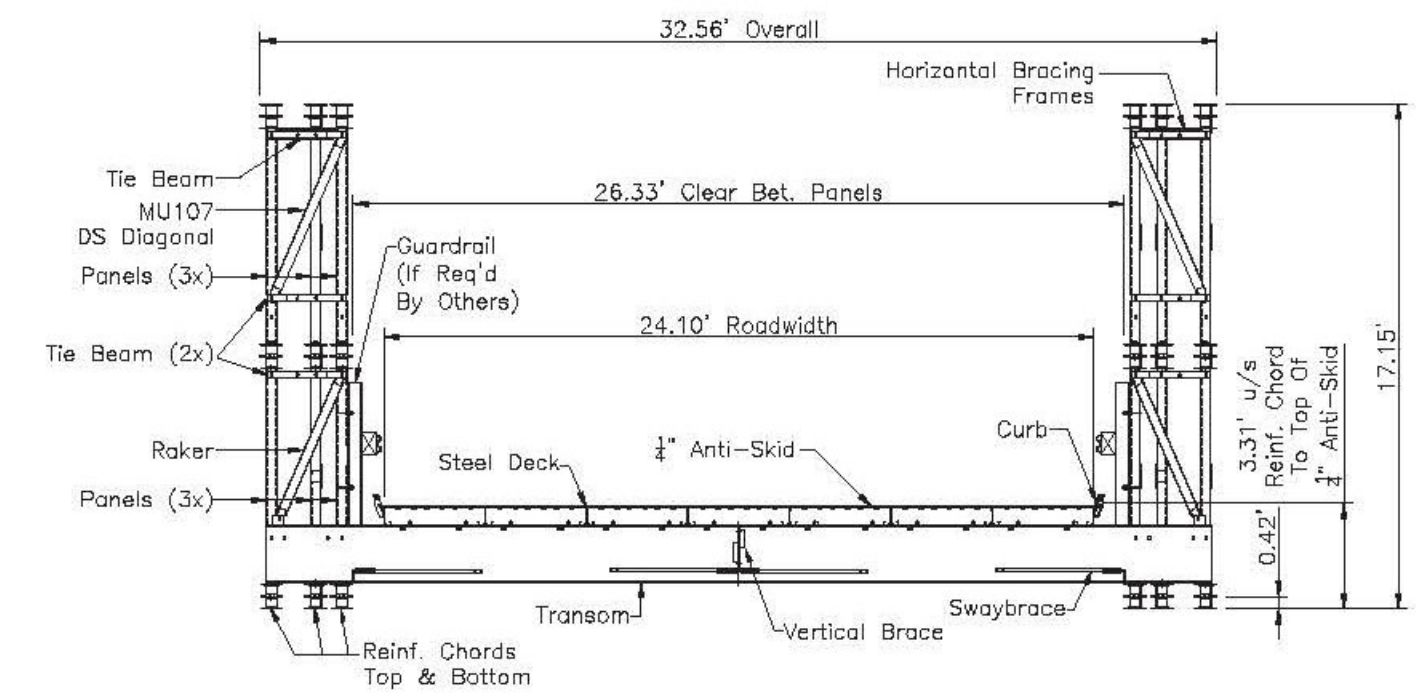

TYPICAL SECTION THRU TDHR3H+ TRUSS

General Arrangement For
 2 Span 22 Bay
 Mabey Universal
 24.10' Roadwidth
 23.71' Roadwidth
 HS-20 Live Loading
 TS+ & TDHR3H+ Trusses

Client Harrison & Burrowes			
Job Name Richmond, Vt Temporary Bridge		Location Richmond, VT	
Drawn By D.P.	Date 05/12/11	Dwg. No. BR0063036SUB02	
Checked By JNR	Date 05/25/11	Order no.	
Revision	Sheet 1 of 2	Scale Do Not Scale	



MABEY BRIDGE AND SHORE INC

6770 DORSEY RD. ELKRIDGE, MD. 21075

TEL : 410 379 2800
 FAX : 410 379 2801

MABEY BRIDGE & SHORE INC TEL 410-379-2800 FAX 410-379-2801