

Abutments and Piers shown are for illustration only and may not look like abutments intended for use on this project. For abutment details see abutment drawing by others.




	Max.	Min.
Dead	30	30
Live	85	75
Total	115	115

	Max.	Min.
Dead	225	225
Live	165	145
Total	390	370

	Max.	Min.
Dead	195	195
Live	135	120
Total	330	315

Reactions in Kips. 1 Kip = 1000lbs.
 Live Reactions (max. and min.) are concurrent. Difference is due to eccentricity of loading.
 Exposed area of bridge (for calculating wind loads):
 Span #1: (Single Storey Construction) = 2.83 sq. ft./ft.
 Span #2: (Double Storey Construction) = 5.15 sq. ft./ft.


- NOTES:**
1. Live load is HS-20.
 2. Abutments and anchor bolts by contractor.
 3. Due to the nature of modular bridging, dimensional tolerances can accumulate. Mabey Bridge recommends the following:
 a.) Construct backwalls after bridge is in place.
 b.) Cast 3" dia. voids at anchor bolt locations.
 c.) Grout in anchor bolts after bridge is in position.
 4. No drilling, welding, or alterations of any kind to Mabey-supplied equipment without written permission of Mabey Bridge and Shore, Inc. Engineering Dept. Equipment must be used in the manner intended, according to the supplied drawing(s) and calculations.
 5. All expansion bearings shall be greased at installation.
 6. All bolts shall be snug tight.

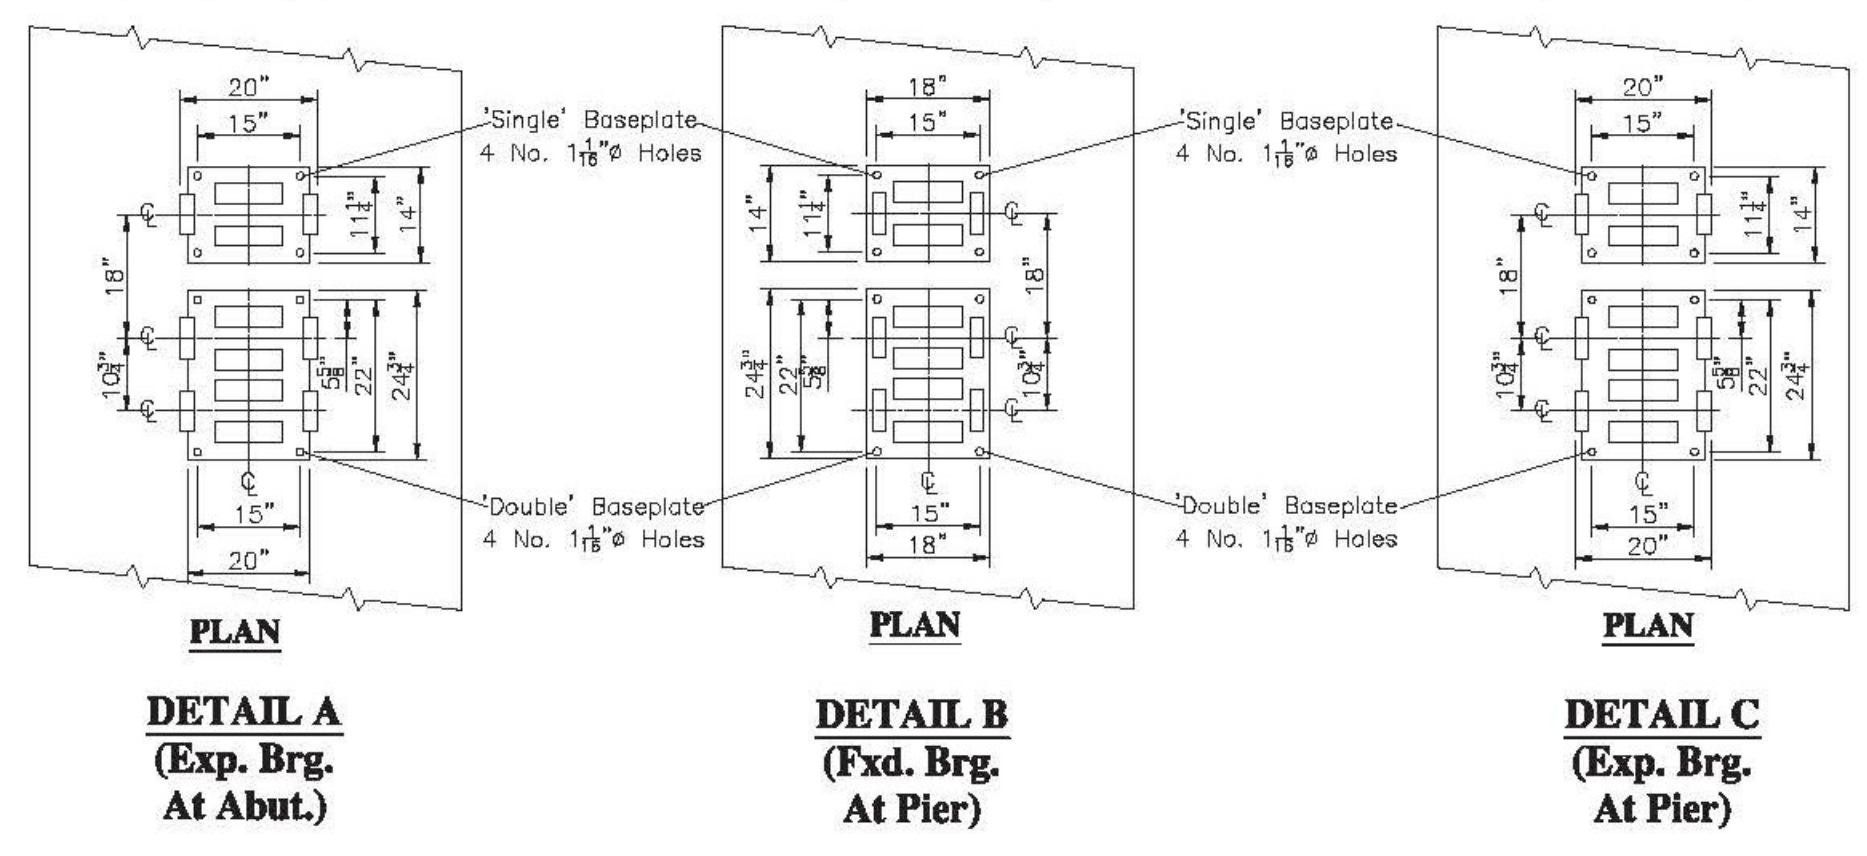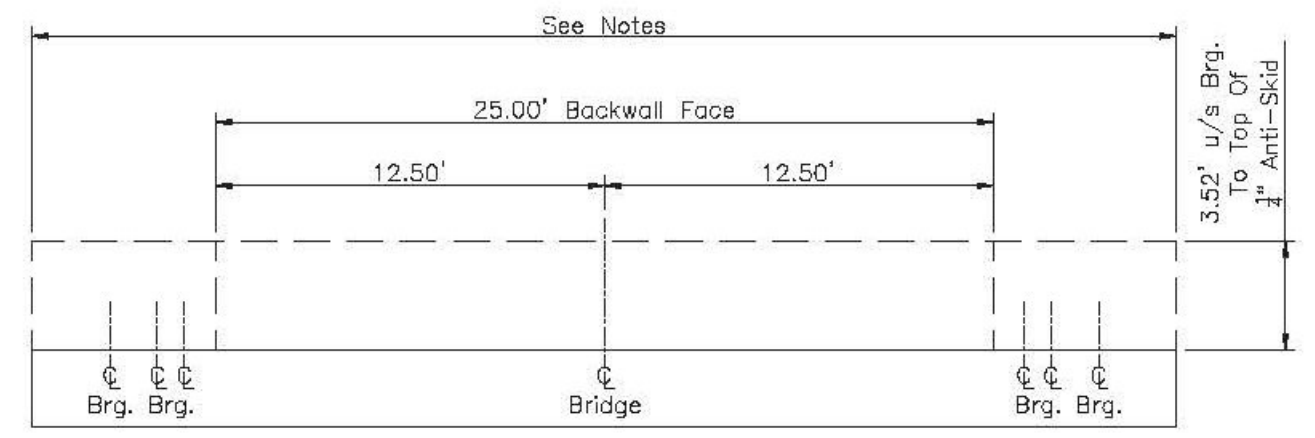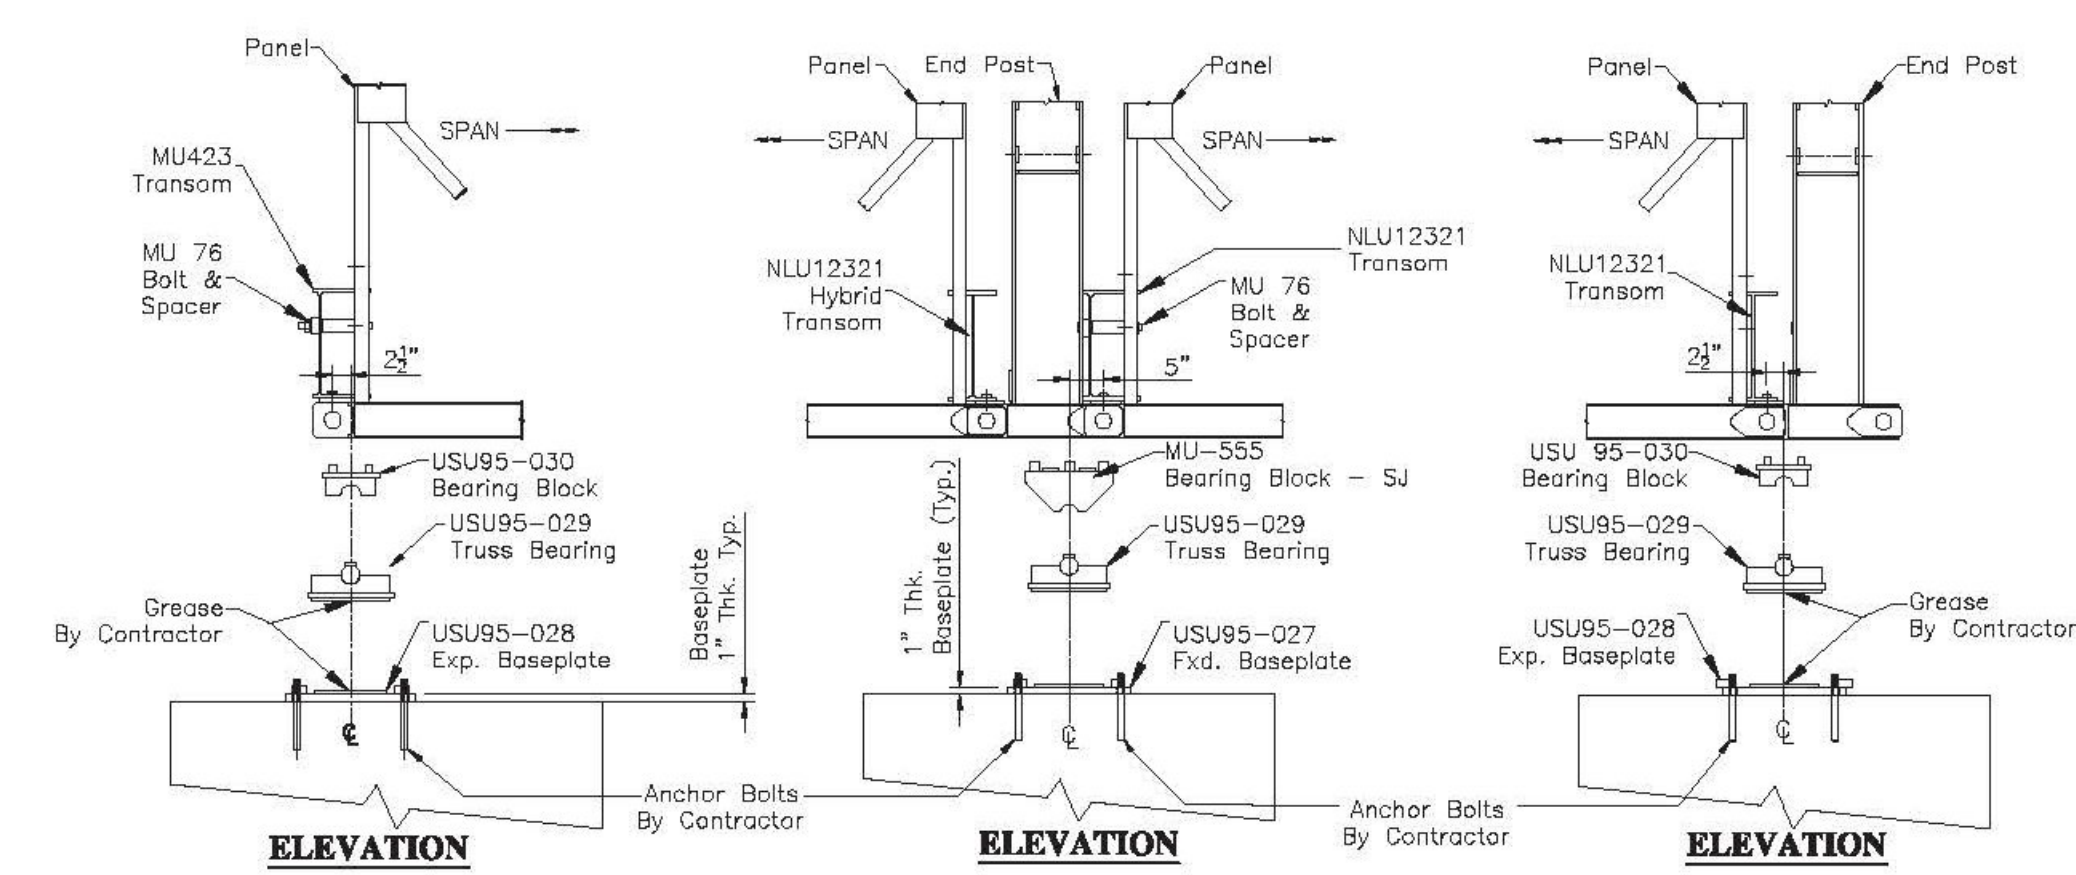

ABUTMENT ELEVATION

Details, Part Section, Abutment
 Layout And Notes For
 2 Span 22 Bay
 Mabey Universal
 24.10' Roadwidth
 23.71' Roadwidth
 HS-20 Live Loading
 TS+ & TDHR3H+ Trusses

Client		Harrison & Burrows	
Job Name	Richmond, Vt Temporary Bridge	Location	Richmond, VT
Drawn By	D.P.	Date	05/12/11
Checked By	JNR	Date	05/25/11
Revision		Sheet	2 of 2
MABEY BRIDGE & SHORE INC		TEL 410-379-2800	FAX 410-379-2801

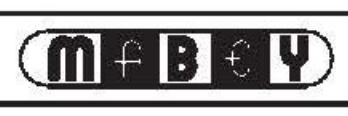

MABEY BRIDGE AND SHORE INC

6770 DORSEY RD. ELKRIDGE, MD. 21075

TEL 410 379 2800
 FAX 410 379 2801