



FILE NAME = v:\projects\enry\22876\cadd\mstr\bridge-work\wbs (1-15) temporary bridge\290c092\_WST TWR DTL .dgn  
 DATE/TIME = 6/1/2011  
 USER = 3293

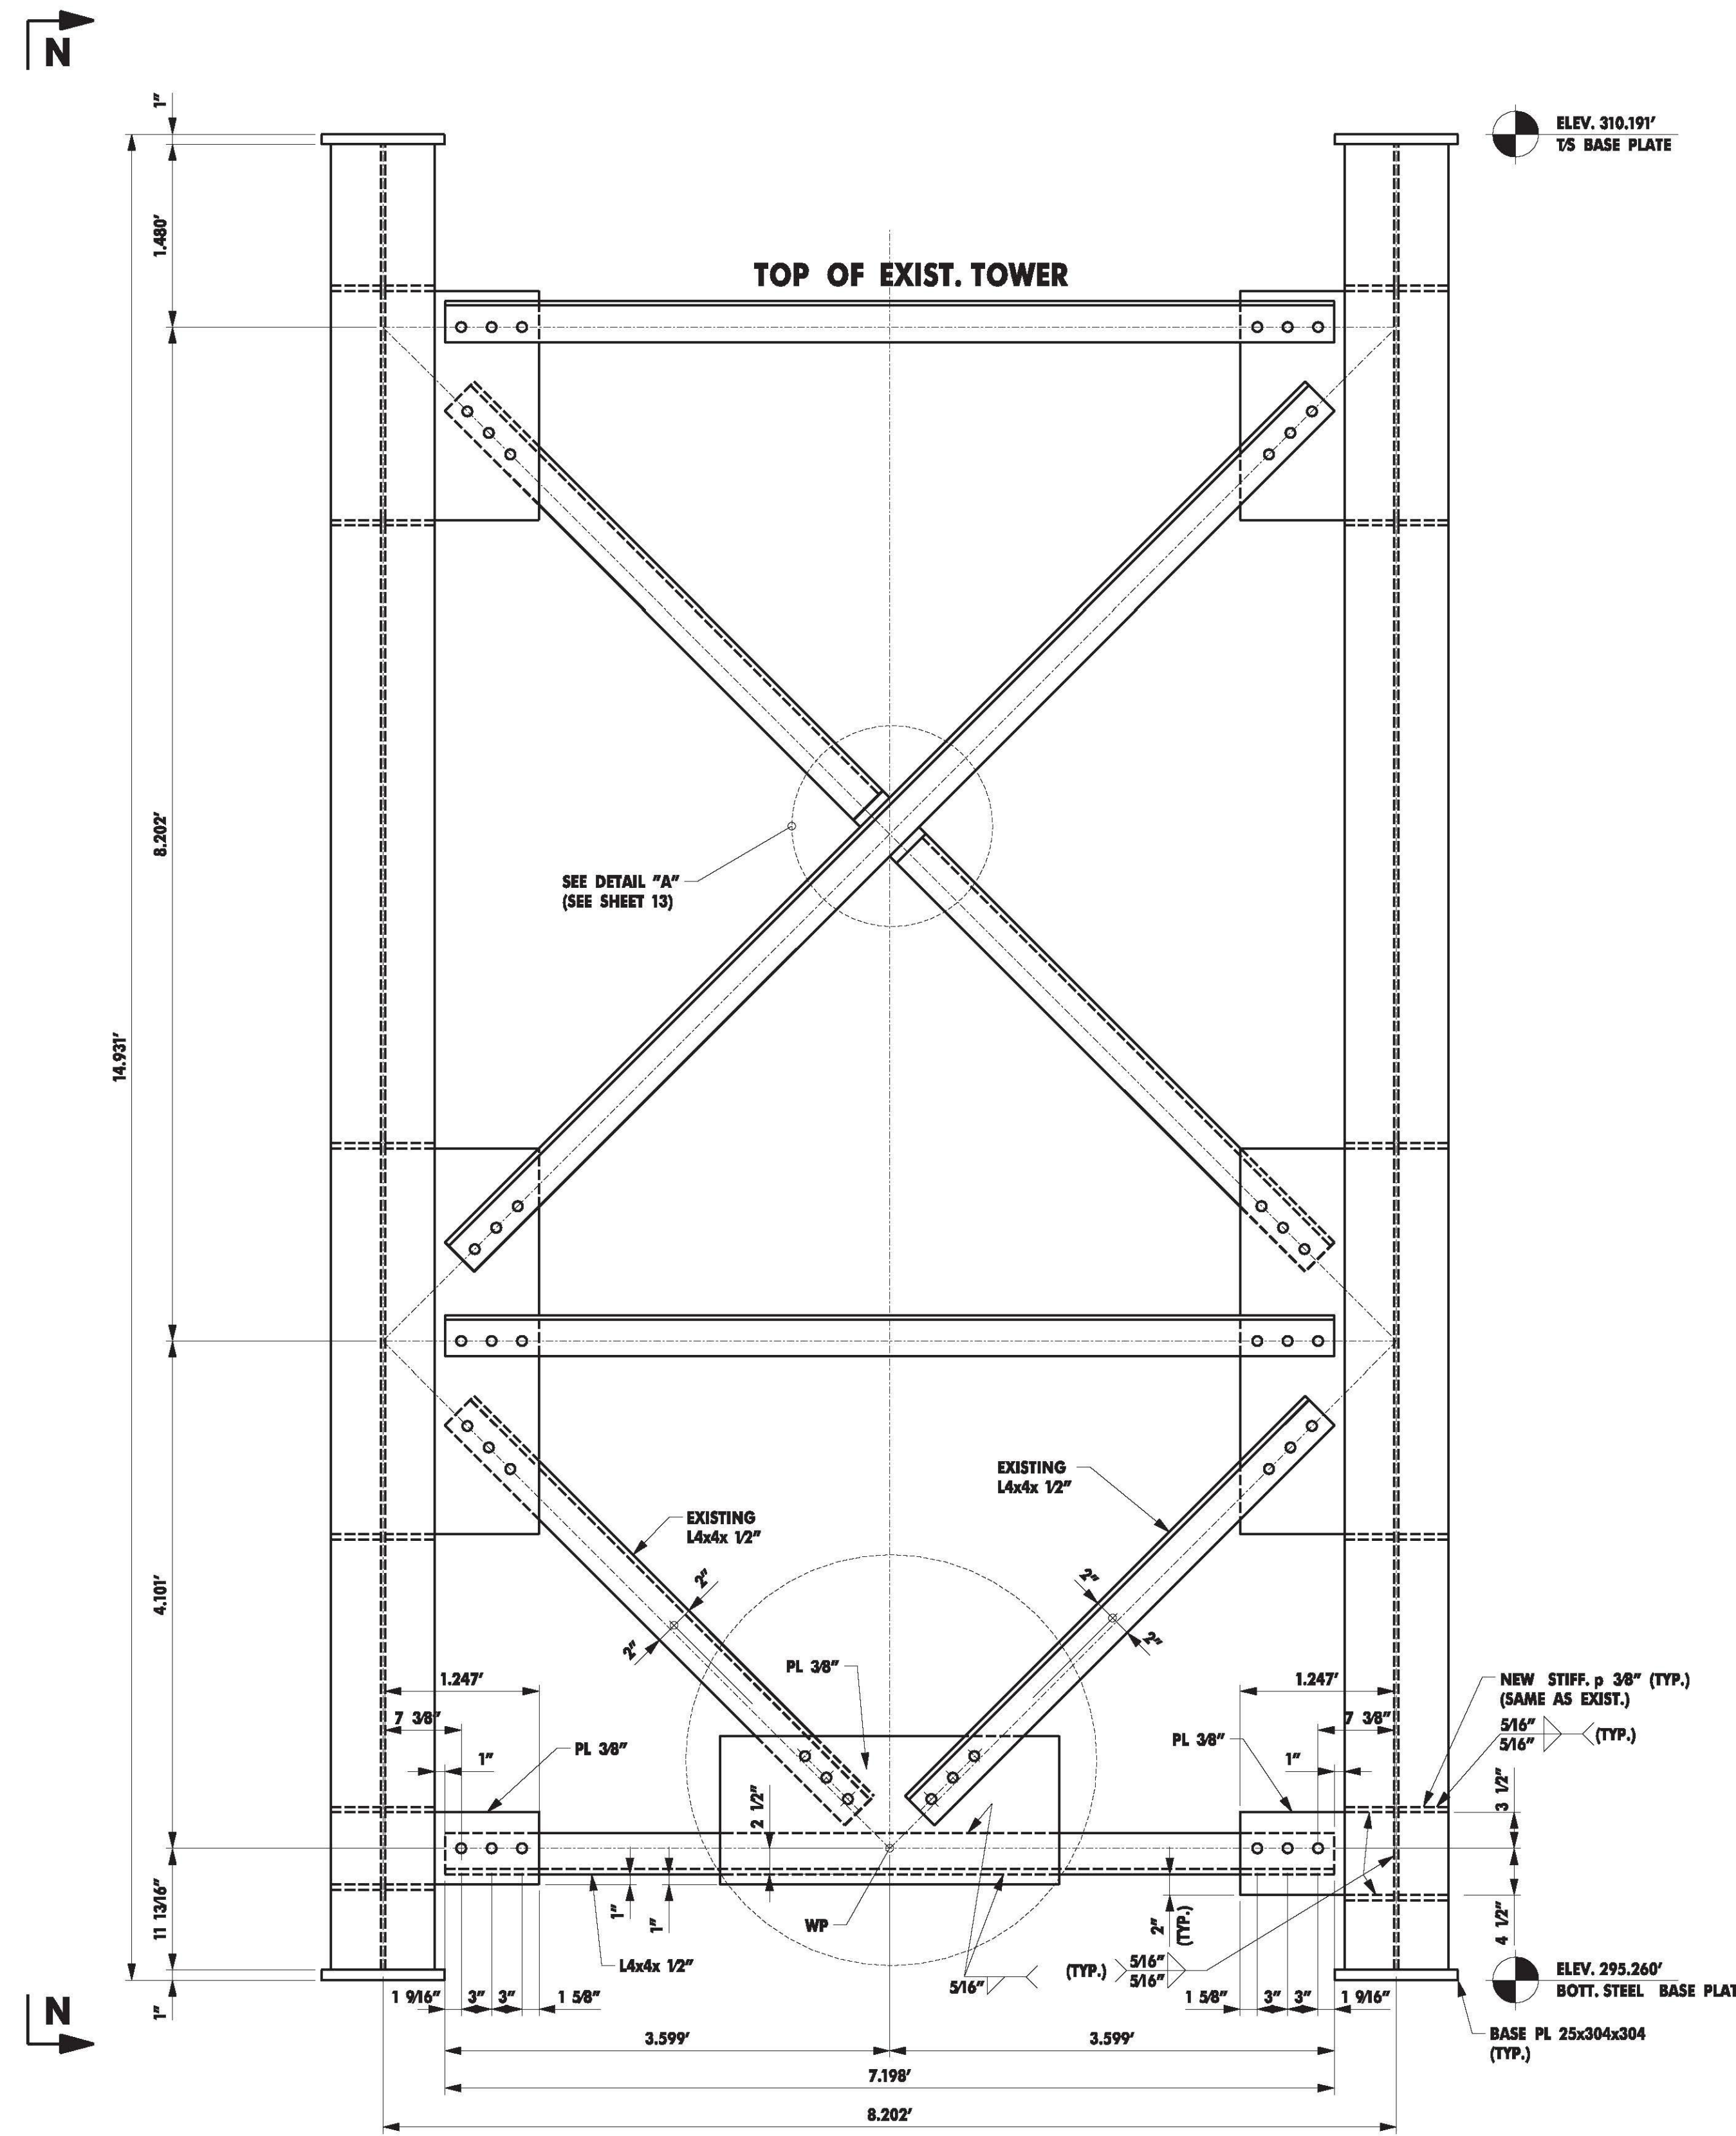

**WEST TOWER**

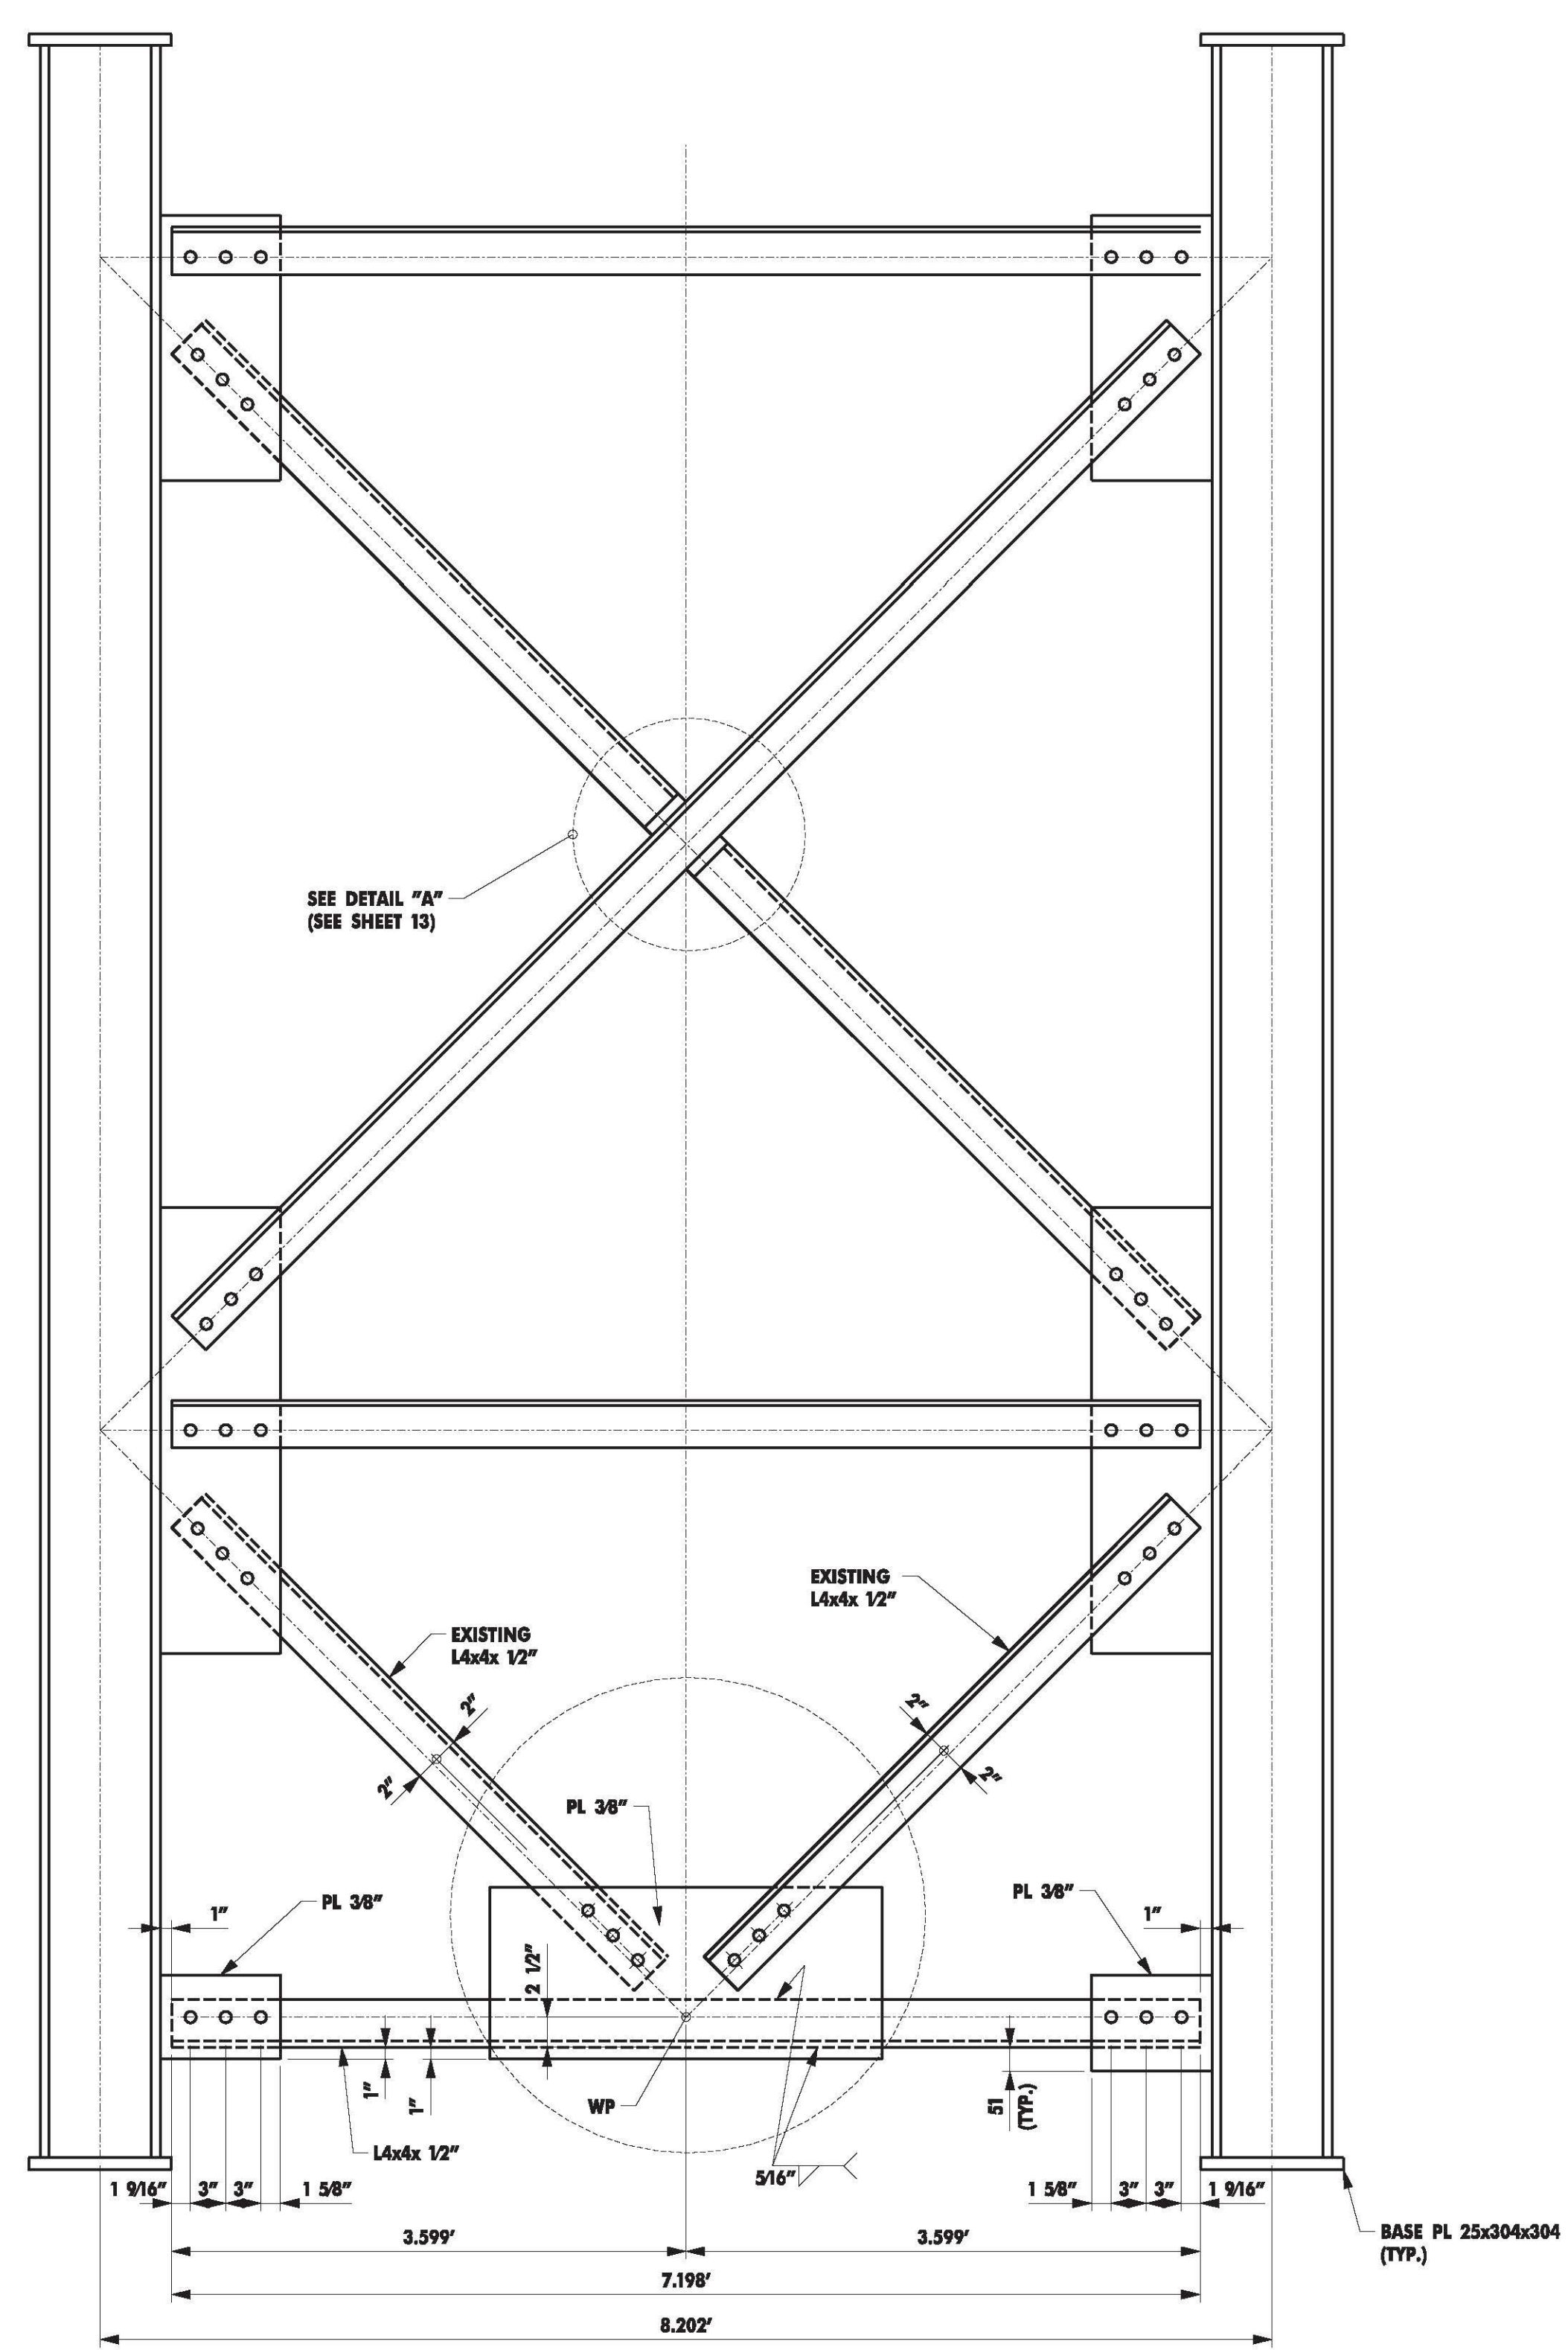

**SECTION N-N**

NOTE  
 SEE SHEET 13 FOR ADDITIONAL TOWER DETAILS.

<b>WEST TOWER DETAILS</b>	PROJECT NAME: RICHMOND
	PROJECT NUMBER: STP-RS 0284(II)
	FILE NAME: z90c092 WST TWR DTL .dgn
	DESIGNED BY: DJV
	PLOT DATE: 6/1/2011
	DRAWN BY: PKR
	CHECKED BY: VC/KM
	SHEET 9 OF XX