
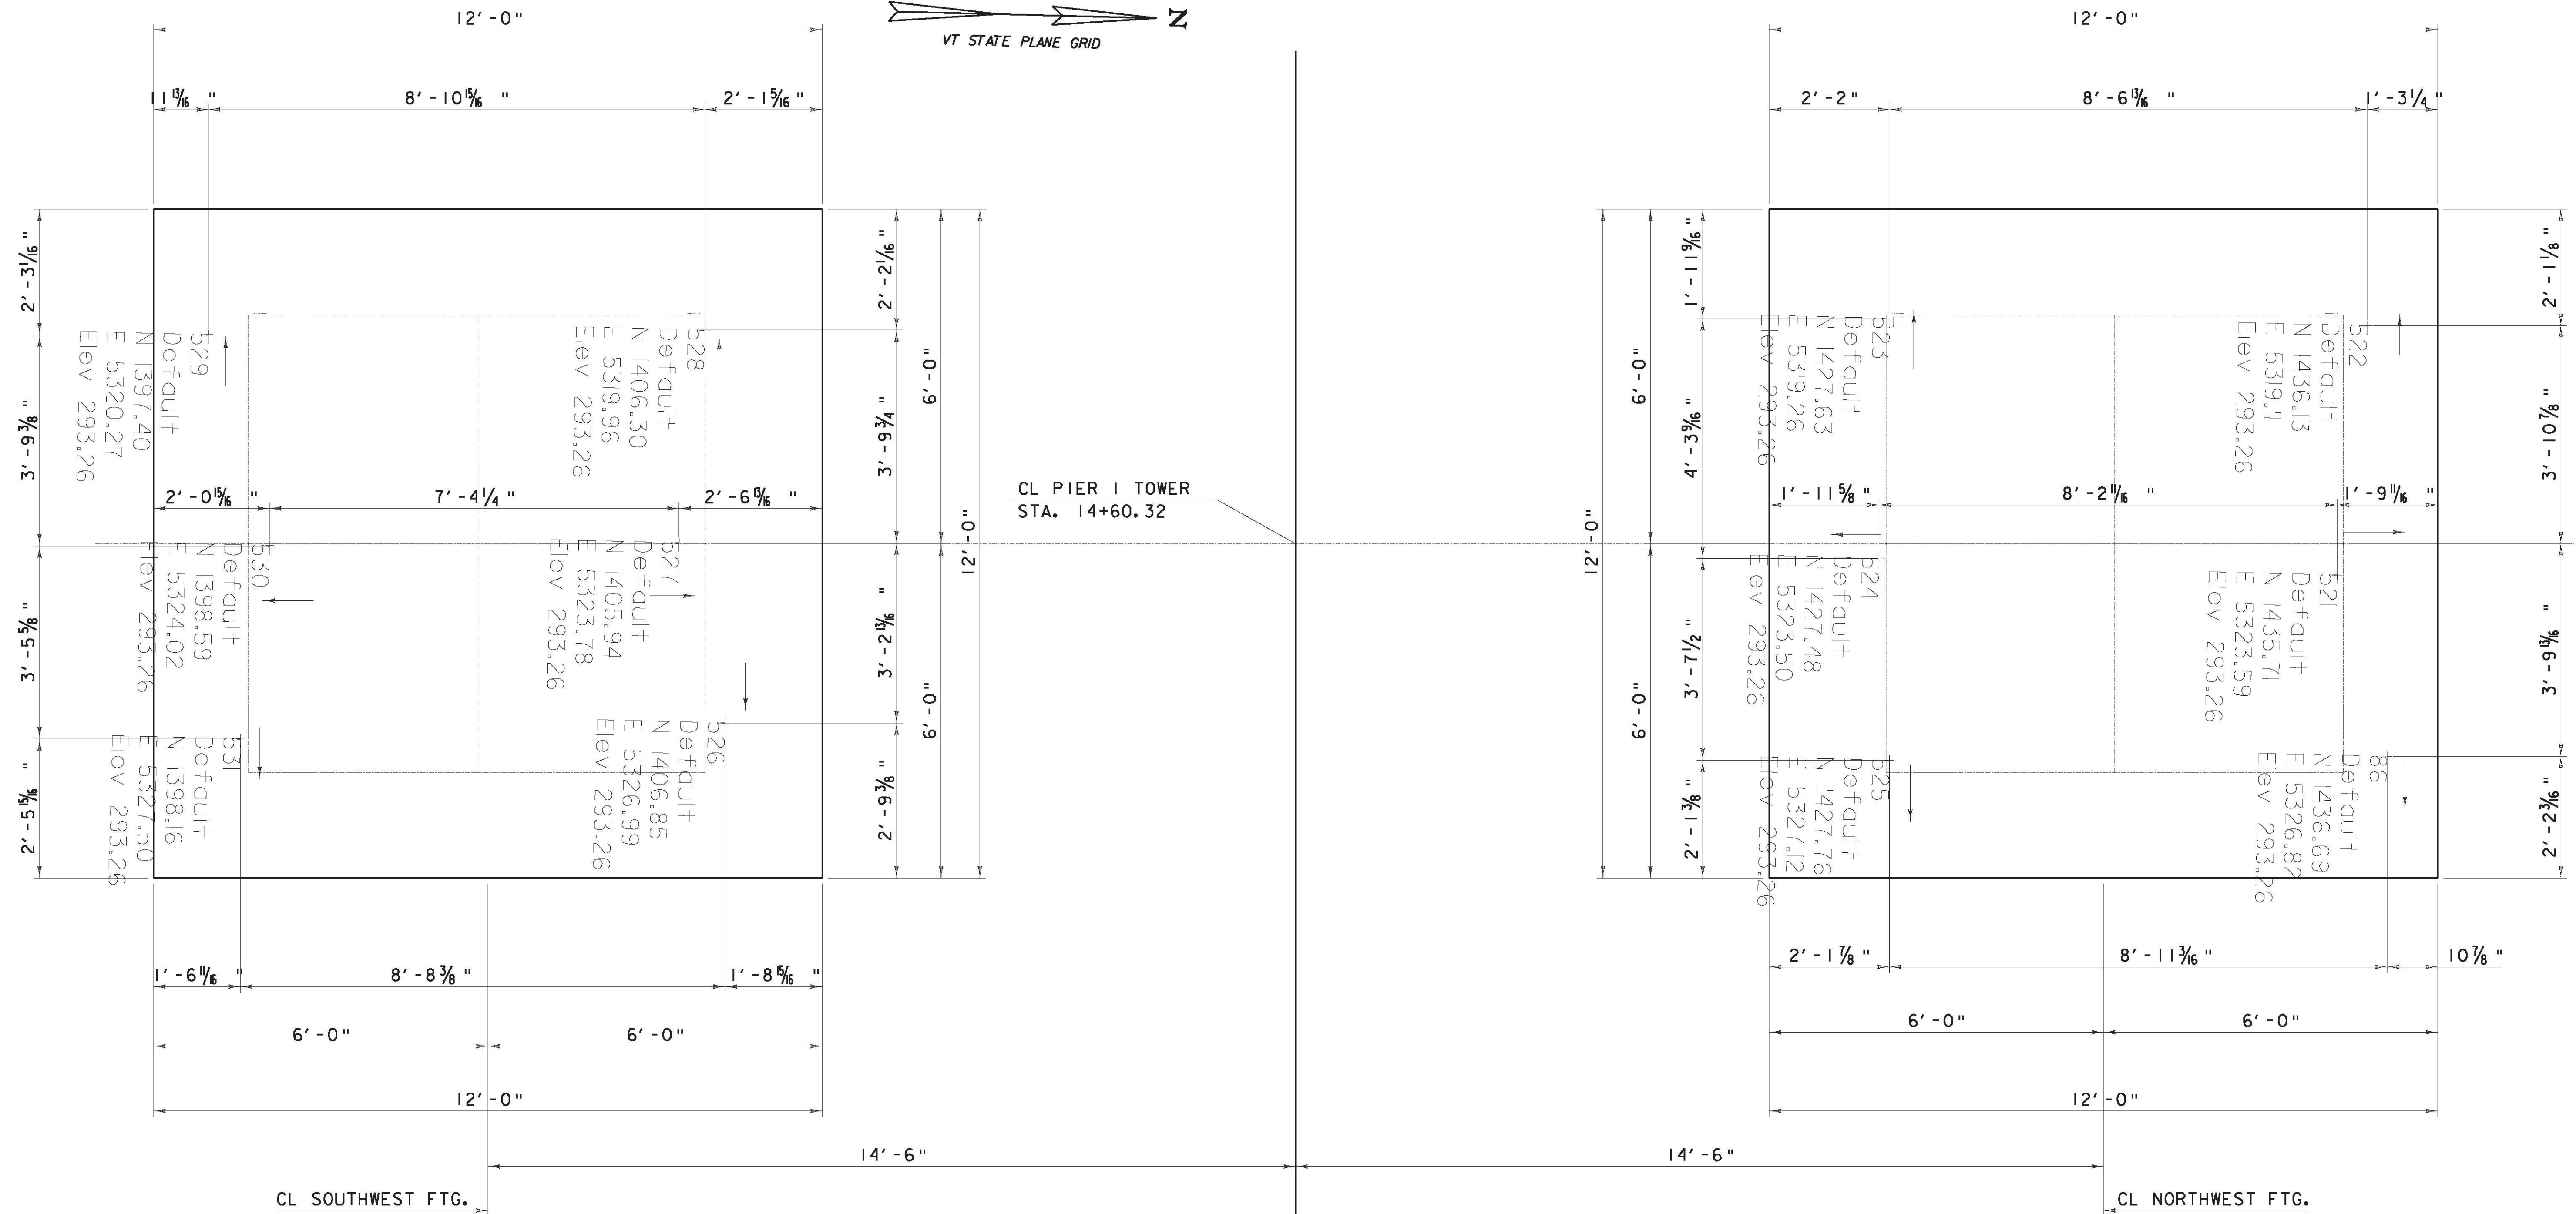


FILE NAME = v:\projects\enr\142\22876\cadd\master\bridge work\wbs (1-15) temporary bridge work\wbs (1-15) TMR FTG.dgn  
 DATE/TIME = 6/1/2011  
 USER = 3293

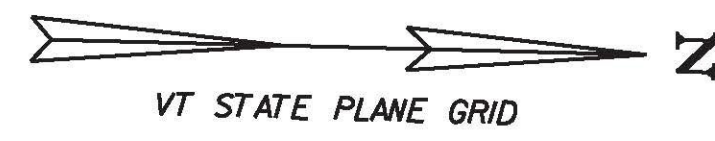

**WEST TOWER FOOTINGS AND PILE LAYOUT**

<b>WEST TOWER FOOTING PLAN AND PILE LAYOUT</b>	PROJECT NAME: RICHMOND	PLOT DATE: 6/1/2011
	PROJECT NUMBER: STP-RS 0284(III)	DRAWN BY: PKR
	FILE NAME: z90c092 WST TWR FTG.dgn	CHECKED BY: VC/KM
	PROJECT LEADER: DJV	SHEET 10 OF XX
DESIGNED BY: DJV		
DWG. NO.: 10		