


ISOMETRIC VIEW

- NOTES:**
1. THE EXISTING TRUSS AND TEMPORARY MEMBERS ARE SHOWN AT THE FINAL POSITION.
 2. THIS SHEET IS PROVIDED FOR INFORMATION ONLY. THIS ISOMETRIC VIEW IS ONLY SHOWN FOR GENERAL TEMPORARY MEMBER PLACEMENT RELATIVE TO THE EXISTING BRIDGE AND IS NOT NECESSARILY TO SCALE.
 3. A PAIR OF CABLES SHOULD BE PROVIDED AT ALL CABLE LOCATIONS. CABLES SHOULD BE INSTALLED SYMMETRICALLY ABOUT THE \bar{C} OF THE MEMBER.

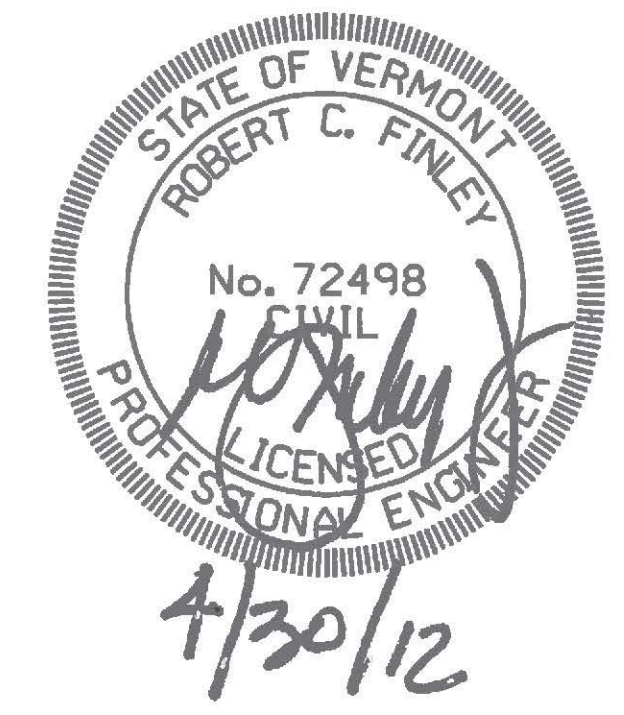

Revision	Drawn By	Date	Description	Revision	Drawn By	Date	Description	Drawn By	Name	Date	Project	Title	Sheet No.
1	JLB	04/24/12	Removed Mabey Truss.					JLB	JLB	01/12	RICHMOND TRUSS WIDENING STATE OF VERMONT AGENCY OF TRANSPORTATION CHITTENDEN COUNTY U.S. ROUTE 2 BRIDGE NO. 24	ISOMETRIC MEMBER LAYOUT	02
			Added Temporary Bent.					NMC	NMC	01/12			
								JMP	JMP	01/12			