



PLAN

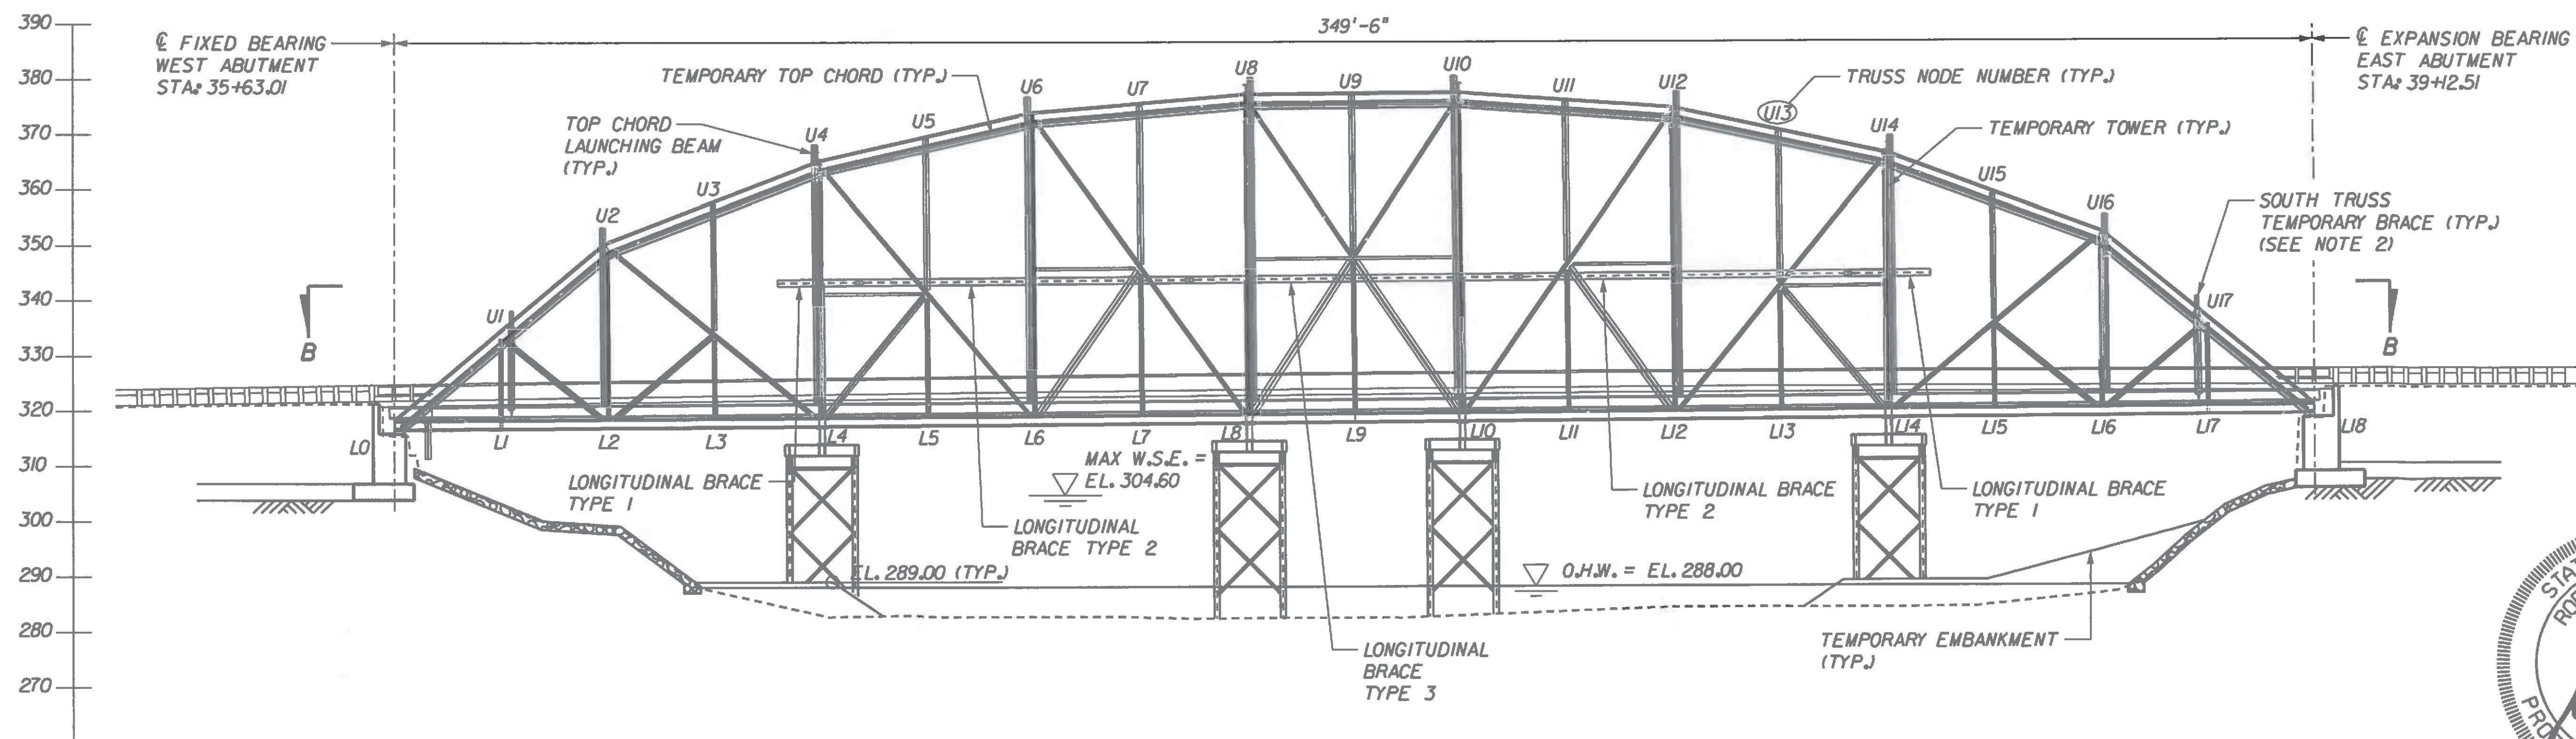

SECTION A-A

NOTES:

1. FOR SECTION B-B, SEE "TEMPORARY LONGITUDINAL STRINGER LAYOUT" SHEET.
2. FOR SOUTH TRUSS TEMPORARY BRACE DETAILS, SEE "SOUTH TRUSS TEMPORARY BRACE DETAILS" SHEET.

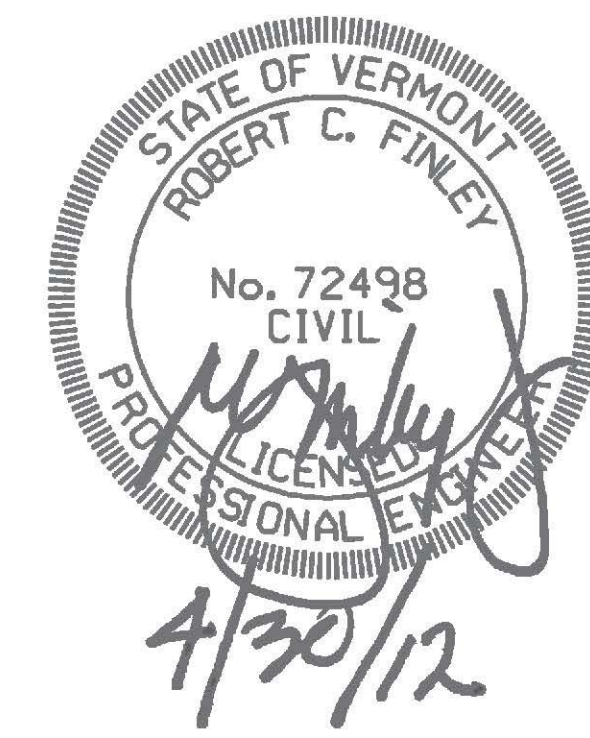

Revision	Drawn By	Date	Description	Revision	Drawn By	Date	Description	Name	Date	Project	Title	Sheet No.
1	JLB	04/24/12	Removed Mabey Truss.					Drawn By: JLB	01/12	1589 Metropolitan Blvd. Tallahassee, FL 32308 850-894-1600 Fax: 850-894-1614 FINLEY Engineering Group, Inc.	RICHMOND TRUSS WIDENING STATE OF VERMONT AGENCY OF TRANSPORTATION CHITTENDEN COUNTY U.S. ROUTE 2 BRIDGE NO. 24	PLAN AND ELEVATION 03
							Designed By: NMC	01/12				
							Approved By: JMP	01/12				