


TOP CHORD LAUNCHING BEAM TYPICAL SECTION

NOTES:

1. FOR CONNECTIONS "A", "B", AND "C", SEE "CONNECTION DETAILS (1 OF 3)" SHEET.
2. FOR CONNECTIONS "D", SEE "CONNECTION DETAILS (2 OF 3)" SHEET.
3. FOR "DETAIL I", SEE "TOP CHORD JACKING DETAILS" SHEET.

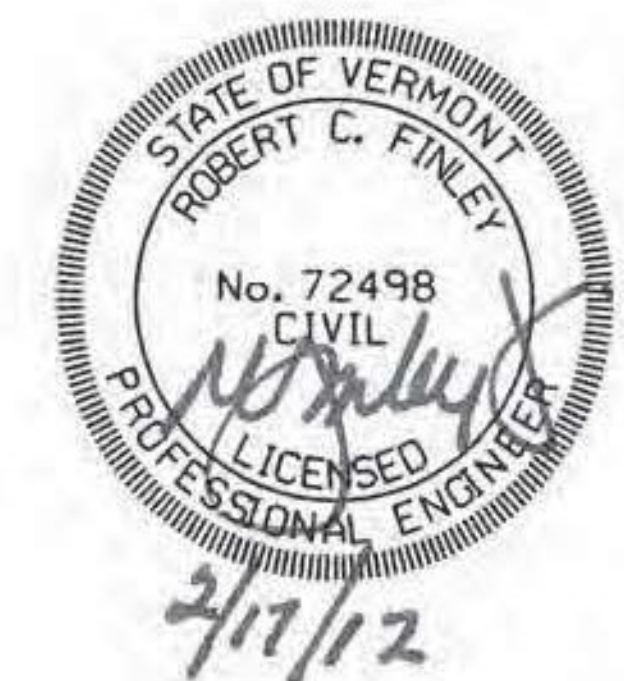

Revision	Drawn By	Date	Description	Revision	Drawn By	Date	Description	Name	Date	Project	Title	Sheet No.	
								Drawn By:	JLB	01/12	RICHMOND TRUSS WIDENING STATE OF VERMONT AGENCY OF TRANSPORTATION CHITTENDEN COUNTY U.S. ROUTE 2 BRIDGE NO. 24	TOP CHORD LAUNCHING BEAM TYPICAL SECTION	
							Designed By:	NMC	01/12				
							Approved By:	JMP	01/12				
													06