


TRANSVERSE SUPPORT BEAM TYPICAL SECTION

**NOTES:**

1. FOR CONNECTIONS "E" AND "F", SEE "CONNECTION DETAILS (2 OF 3)" SHEET.
2. FOR CONNECTIONS "G" AND "H", SEE "CONNECTION DETAILS (3 OF 3)" SHEET.
3. FOR DETAIL "2" AND DETAIL "3", SEE "BOTTOM CHORD JACKING DETAILS" SHEET.

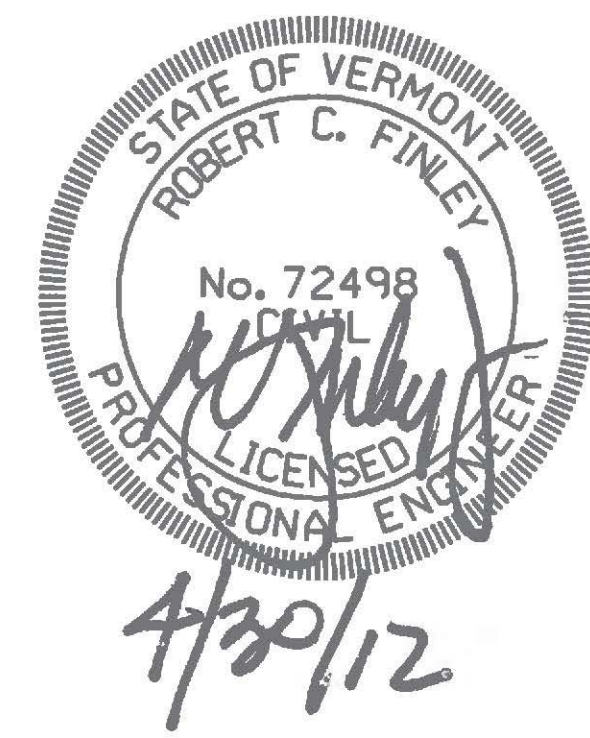

Revision	Drawn By	Date	Description	Revision	Drawn By	Date	Description	Name	Date	Project	Title	Sheet No.	
1	JLB	04/24/12	Removed Mabey Truss and Added Temporary Bents.					Drawn By: JLB	01/12	1589 Metropolitan Blvd. Tallahassee, FL 32308 850-894-1600 Fax: 850-894-1614 <b>FINLEY</b> Engineering Group, Inc.	<b>RICHMOND TRUSS WIDENING</b> STATE OF VERMONT AGENCY OF TRANSPORTATION CHITTENDEN COUNTY U.S. ROUTE 2 BRIDGE NO. 24	<b>TRANSVERSE SUPPORT BEAM TYPICAL SECTION</b>	07
							Designed By: NMC	01/12					
							Approved By: JMP	01/12					