


**DIAGONAL BRACE P DETAIL**

- NOTES:**
- FOR LOCATION OF TEMPORARY LONGITUDINAL STRINGER AND LONGITUDINAL BRACE, SEE "PLAN AND ELEVATION" AND "TYPICAL SECTION" SHEET.
  - FOR STIFFENER "G" DETAILS, SEE "MEMBER DETAILS II OF 4" SHEET.
- \* W33x118 IS ALSO ACCEPTABLE. TEMPORARY TOWER HEIGHTS SHALL BE ADJUSTED ACCORDINGLY.

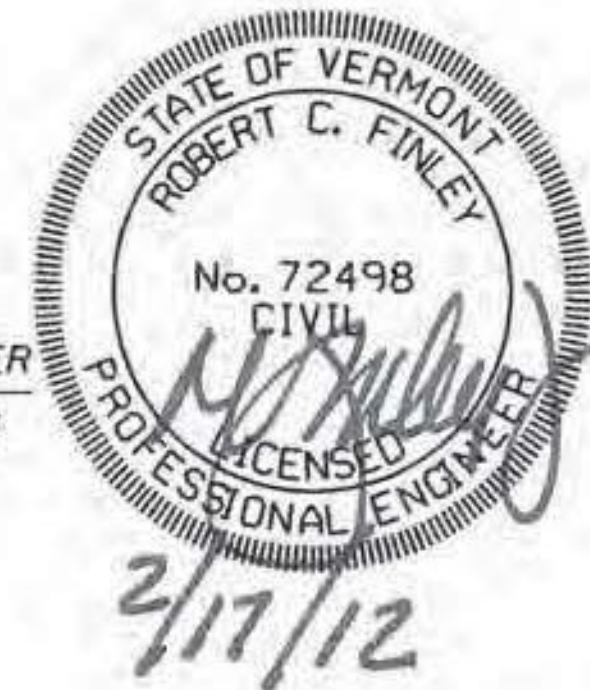

Revision	Drawn By	Date	Description	Revision	Drawn By	Date	Description	Name	Date	Project	Title	Sheet No.
								Drawn By:	BAB	01/12	RICHMOND TRUSS WIDENING STATE OF VERMONT AGENCY OF TRANSPORTATION CHITTENDEN COUNTY U.S. ROUTE 2 BRIDGE NO. 24	MEMBER DETAILS (3 OF 4)
							Designed By:	NMC	01/12			
							Approved By:	JMP	01/12			