


TEMPORARY TOP CHORD DIMENSION			
TOP CHORD TYPE	STEEL SHAPE	LOCATION	"A"
TYPE 1	HSS12x12x5/8	U0-U2 & U16-U18	51'-2"
TYPE 2	HSS12x12x5/8	U2-U4 & U14-U16	36'-10"
TYPE 3	HSS10x10x1/2	U4-U6 & U12-U14	35'-4"
TYPE 4	HSS10x10x1/2	U6-U8 & U10-U12	34'-6"
TYPE 5	HSS10x10x1/2	U8-U10	34'-8"

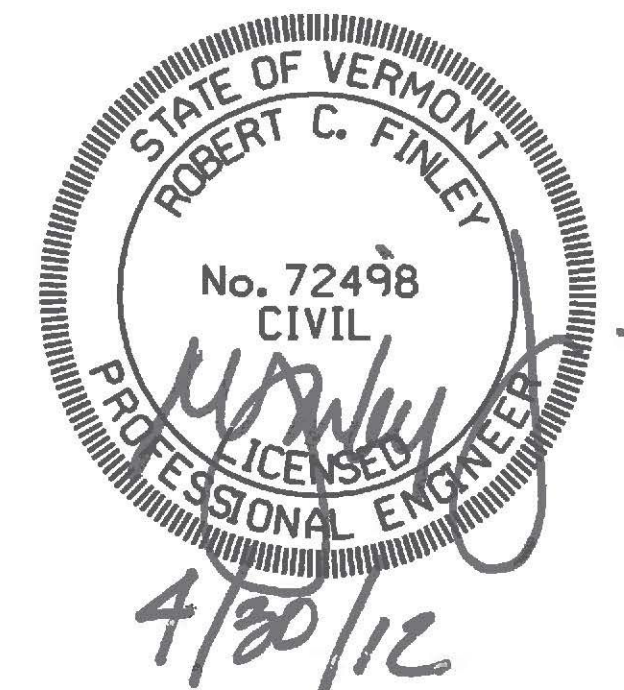

NOTES:
 1. FOR TEMPORARY TOP CHORD LOCATIONS, SEE "TEMPORARY TOP CHORD" TABLE AND THE ELEVATION VIEW ON THE "PLAN AND ELEVATION" SHEET.
 * OTHER ACCEPTABLE MEMBERS ARE HPI4x89 AND HPI4x117.

Revision	Drawn By	Date	Description	Revision	Drawn By	Date	Description	Name	Date	Project	Title	Sheet No.
1	JLB	04/24/12	Changed Plate Thickness					Drawn By: JLB	01/12	1589 Metropolitan Blvd. Tallahassee, FL 32308 850-894-1600 Fax: 850-894-1614 FINLEY Engineering Group, Inc.	RICHMOND TRUSS WIDENING STATE OF VERMONT AGENCY OF TRANSPORTATION CHITTENDEN COUNTY U.S. ROUTE 2 BRIDGE NO. 24	MEMBER DETAILS (4 OF 4) 19
							Designed By: NMC	01/12				
							Approved By: JMP	01/12				