


- NOTES:**
1. FOR LOCATIONS OF CONNECTION "A", "B", AND "C" DETAILS, SEE "TOP CHORD LAUNCHING BEAM TYPICAL SECTION" SHEET.
  2. FOR TYPICAL CHANNEL DETAILS, SEE "CHANNEL DETAILS" SHEET.
  3. FOR TYPE 1 SUPPORT DETAILS, SEE "TEMPORARY TOWER DETAILS" SHEET.

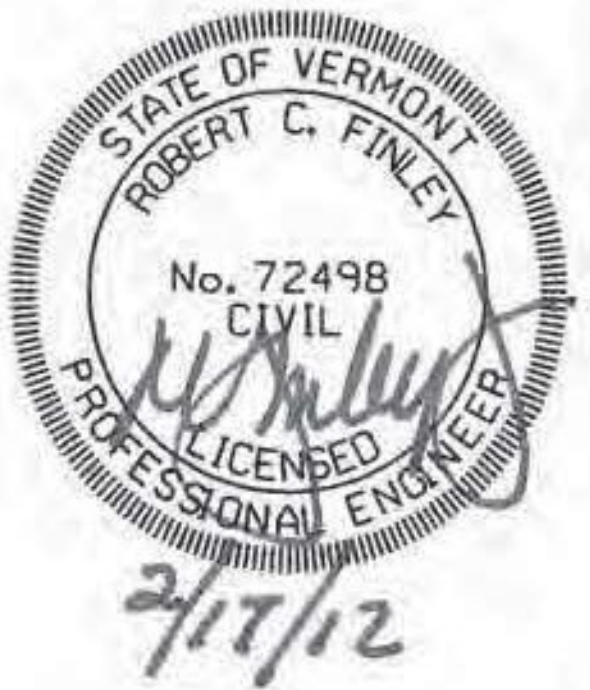

Revision	Drawn By	Date	Description	Revision	Drawn By	Date	Description	Name	Date	Project	Title	Sheet No.
								Drawn By:	BAB	01/12	RICHMOND TRUSS WIDENING STATE OF VERMONT AGENCY OF TRANSPORTATION CHITTENDEN COUNTY U.S. ROUTE 2 BRIDGE NO. 24	CONNECTION DETAILS (1 OF 3)
							Designed By:	NMC	01/12	20		
							Approved By:	JMP	01/12			