


CONNECTION AT CHANNEL TYPE 7

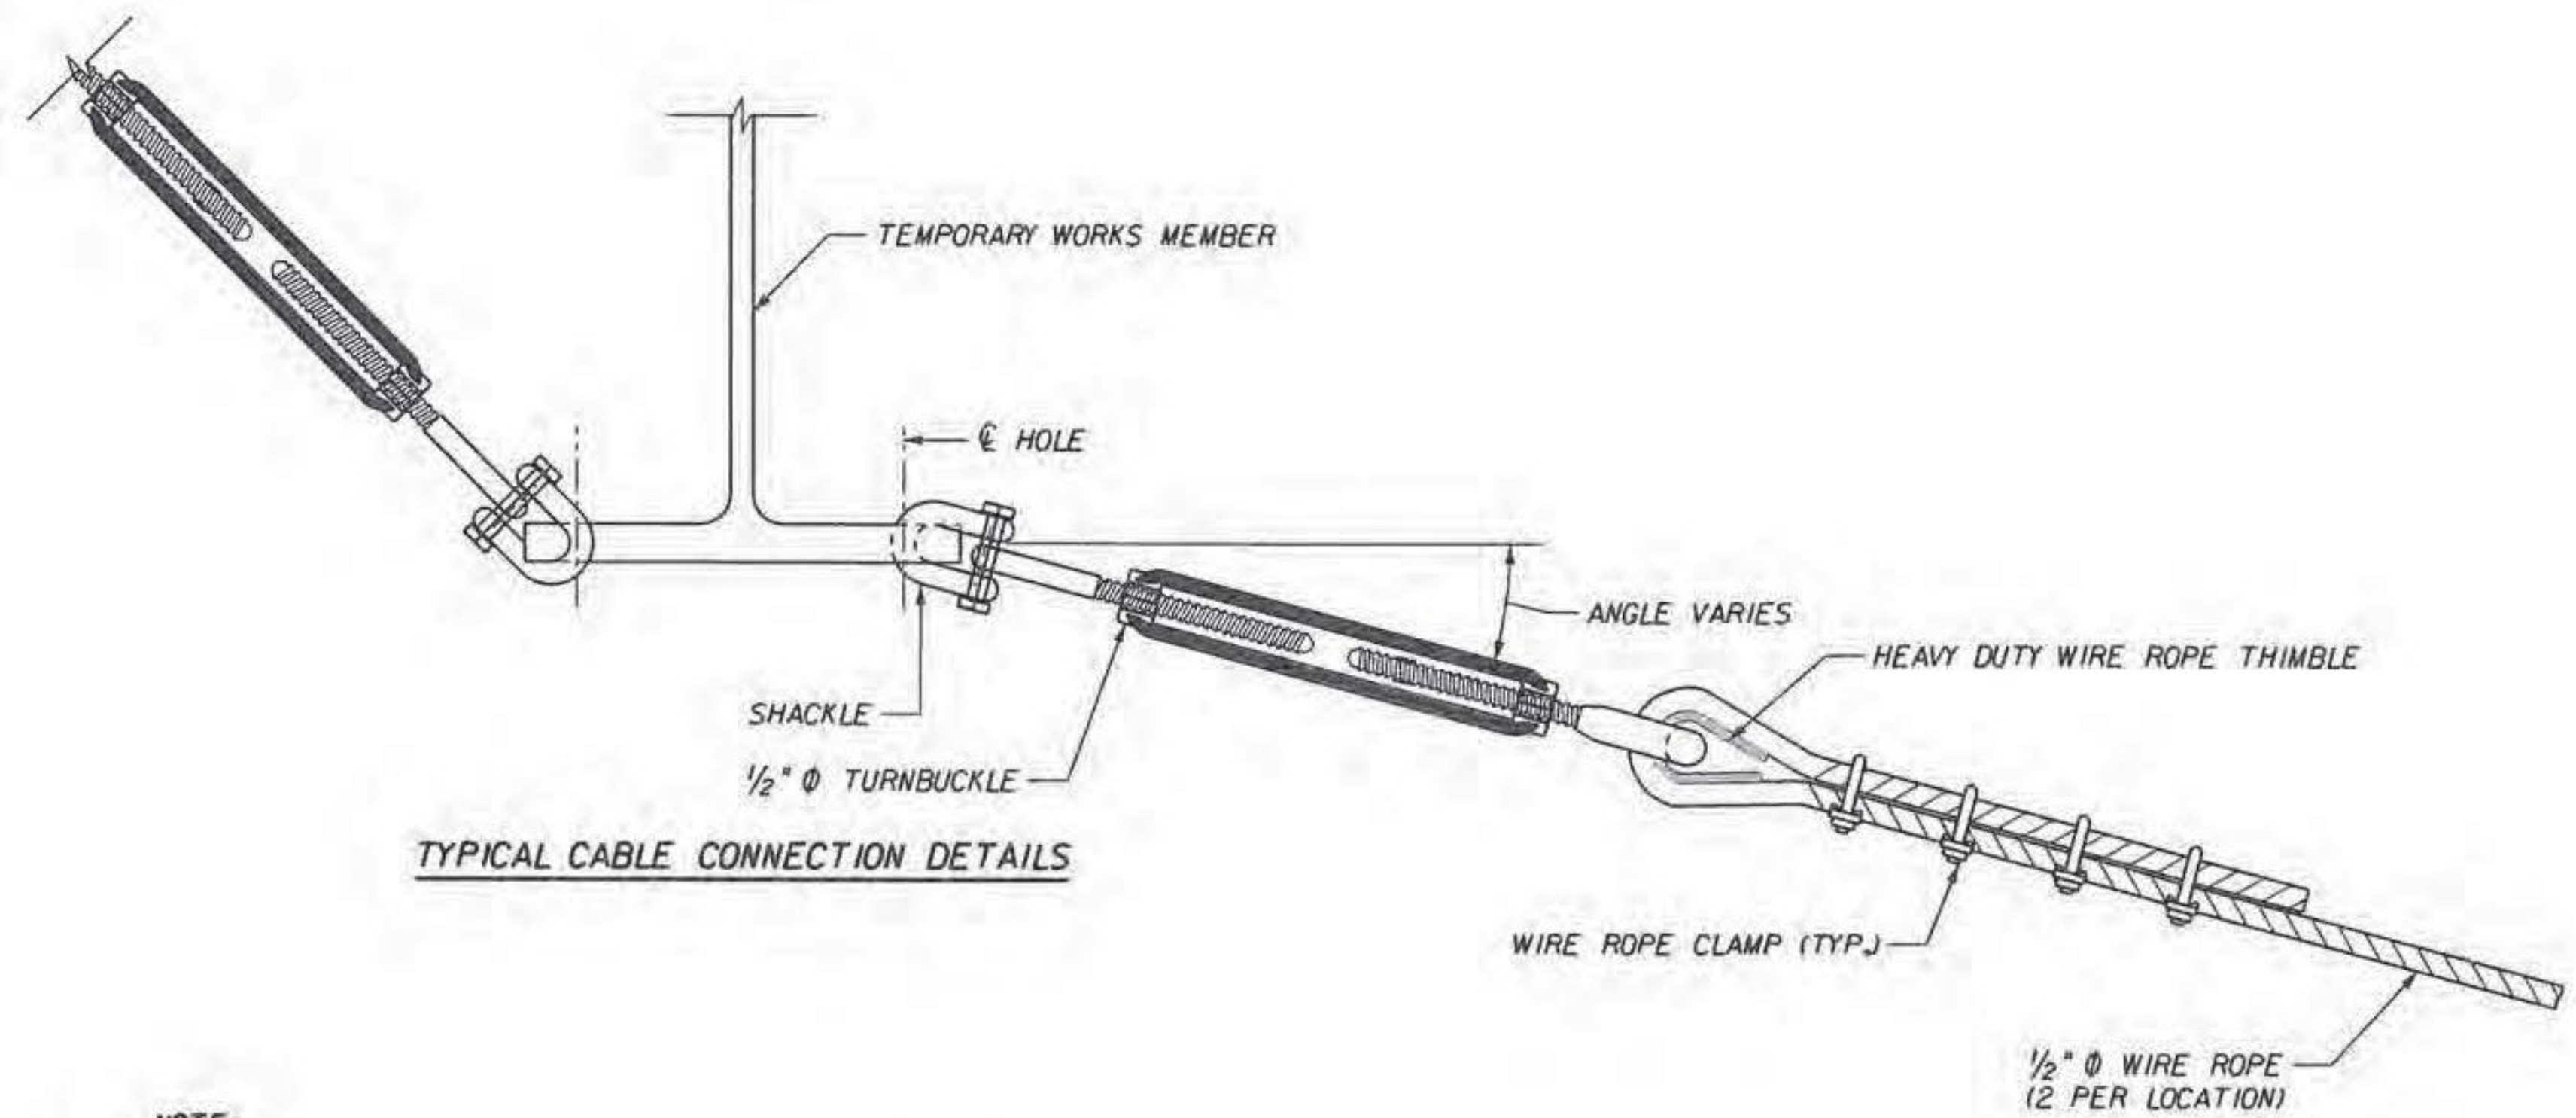

TYPICAL CABLE CONNECTION DETAILS

NOTE:
 ALL PARTS SHALL BE PER MANUFACTURER'S RECOMMENDATIONS.
 ALL CABLES, CONNECTIONS, AND PARTS SHALL HAVE A MINIMUM WORKING CAPACITY OF 30 KIPS



Revision	Drawn By	Date	Description	Revision	Drawn By	Date	Description	Name	Date	Project	Title	Sheet No.
								Drawn By:	JLB	01/12	RICHMOND TRUSS WIDENING STATE OF VERMONT AGENCY OF TRANSPORTATION CHITTENDEN COUNTY U.S. ROUTE 2 BRIDGE NO. 24	CABLE DETAILS 28
							Designed By:	NMC	01/12			
							Approved By:	JMP	01/12			