

CONSTRUCTION MANUAL
RICHMOND TRUSS WIDENING
RICHMOND, VERMONT

INDEX OF DRAWINGS


SHEET TITLE

- CM-01 INDEX AND GENERAL NOTES
- CM-02 STANDARD PROCEDURES (1 OF 2)
- CM-03 STANDARD PROCEDURES (2 OF 2)
- CM-04 CONSTRUCTION SEQUENCE (1 OF 22)
- CM-05 CONSTRUCTION SEQUENCE (2 OF 22)
- △ CM-06 CONSTRUCTION SEQUENCE (3 OF 22)
- CM-07 CONSTRUCTION SEQUENCE (4 OF 22)
- CM-08 CONSTRUCTION SEQUENCE (5 OF 22)
- CM-09 CONSTRUCTION SEQUENCE (6 OF 22)
- CM-10 CONSTRUCTION SEQUENCE (7 OF 22)
- CM-11 CONSTRUCTION SEQUENCE (8 OF 22)
- CM-12 CONSTRUCTION SEQUENCE (9 OF 22)
- CM-13 CONSTRUCTION SEQUENCE (10 OF 22)
- CM-14 CONSTRUCTION SEQUENCE (11 OF 22)
- CM-15 CONSTRUCTION SEQUENCE (12 OF 22)
- CM-16 CONSTRUCTION SEQUENCE (13 OF 22)
- CM-17 CONSTRUCTION SEQUENCE (14 OF 22)
- CM-18 CONSTRUCTION SEQUENCE (15 OF 22)
- CM-19 CONSTRUCTION SEQUENCE (16 OF 22)
- CM-20 CONSTRUCTION SEQUENCE (17 OF 22)
- CM-21 CONSTRUCTION SEQUENCE (18 OF 22)
- CM-22 CONSTRUCTION SEQUENCE (19 OF 22)
- CM-23 CONSTRUCTION SEQUENCE (20 OF 22)
- CM-24 CONSTRUCTION SEQUENCE (21 OF 22)
- CM-25 CONSTRUCTION SEQUENCE (22 OF 22)

REFERENCES:


THE FOLLOWING DOCUMENTS ARE INCLUDED IN THIS MANUAL BY REFERENCE ONLY, AND ARE TO BE USED TO COMPLETE THE CONSTRUCTION STEPS OUTLINED HEREIN:

1. FINLEY TEMPORARY WORKS DRAWINGS
2. FINLEY HYDRAULICS EQUIPMENT REQUIREMENTS
3. WBS 2.7 BRIDGE WIDENING (BY CHA)
4. WBS 1.6 BRIDGE DESIGN (BY CHA)
5. TEMPORARY BENT DRAWINGS (BY CHA) △

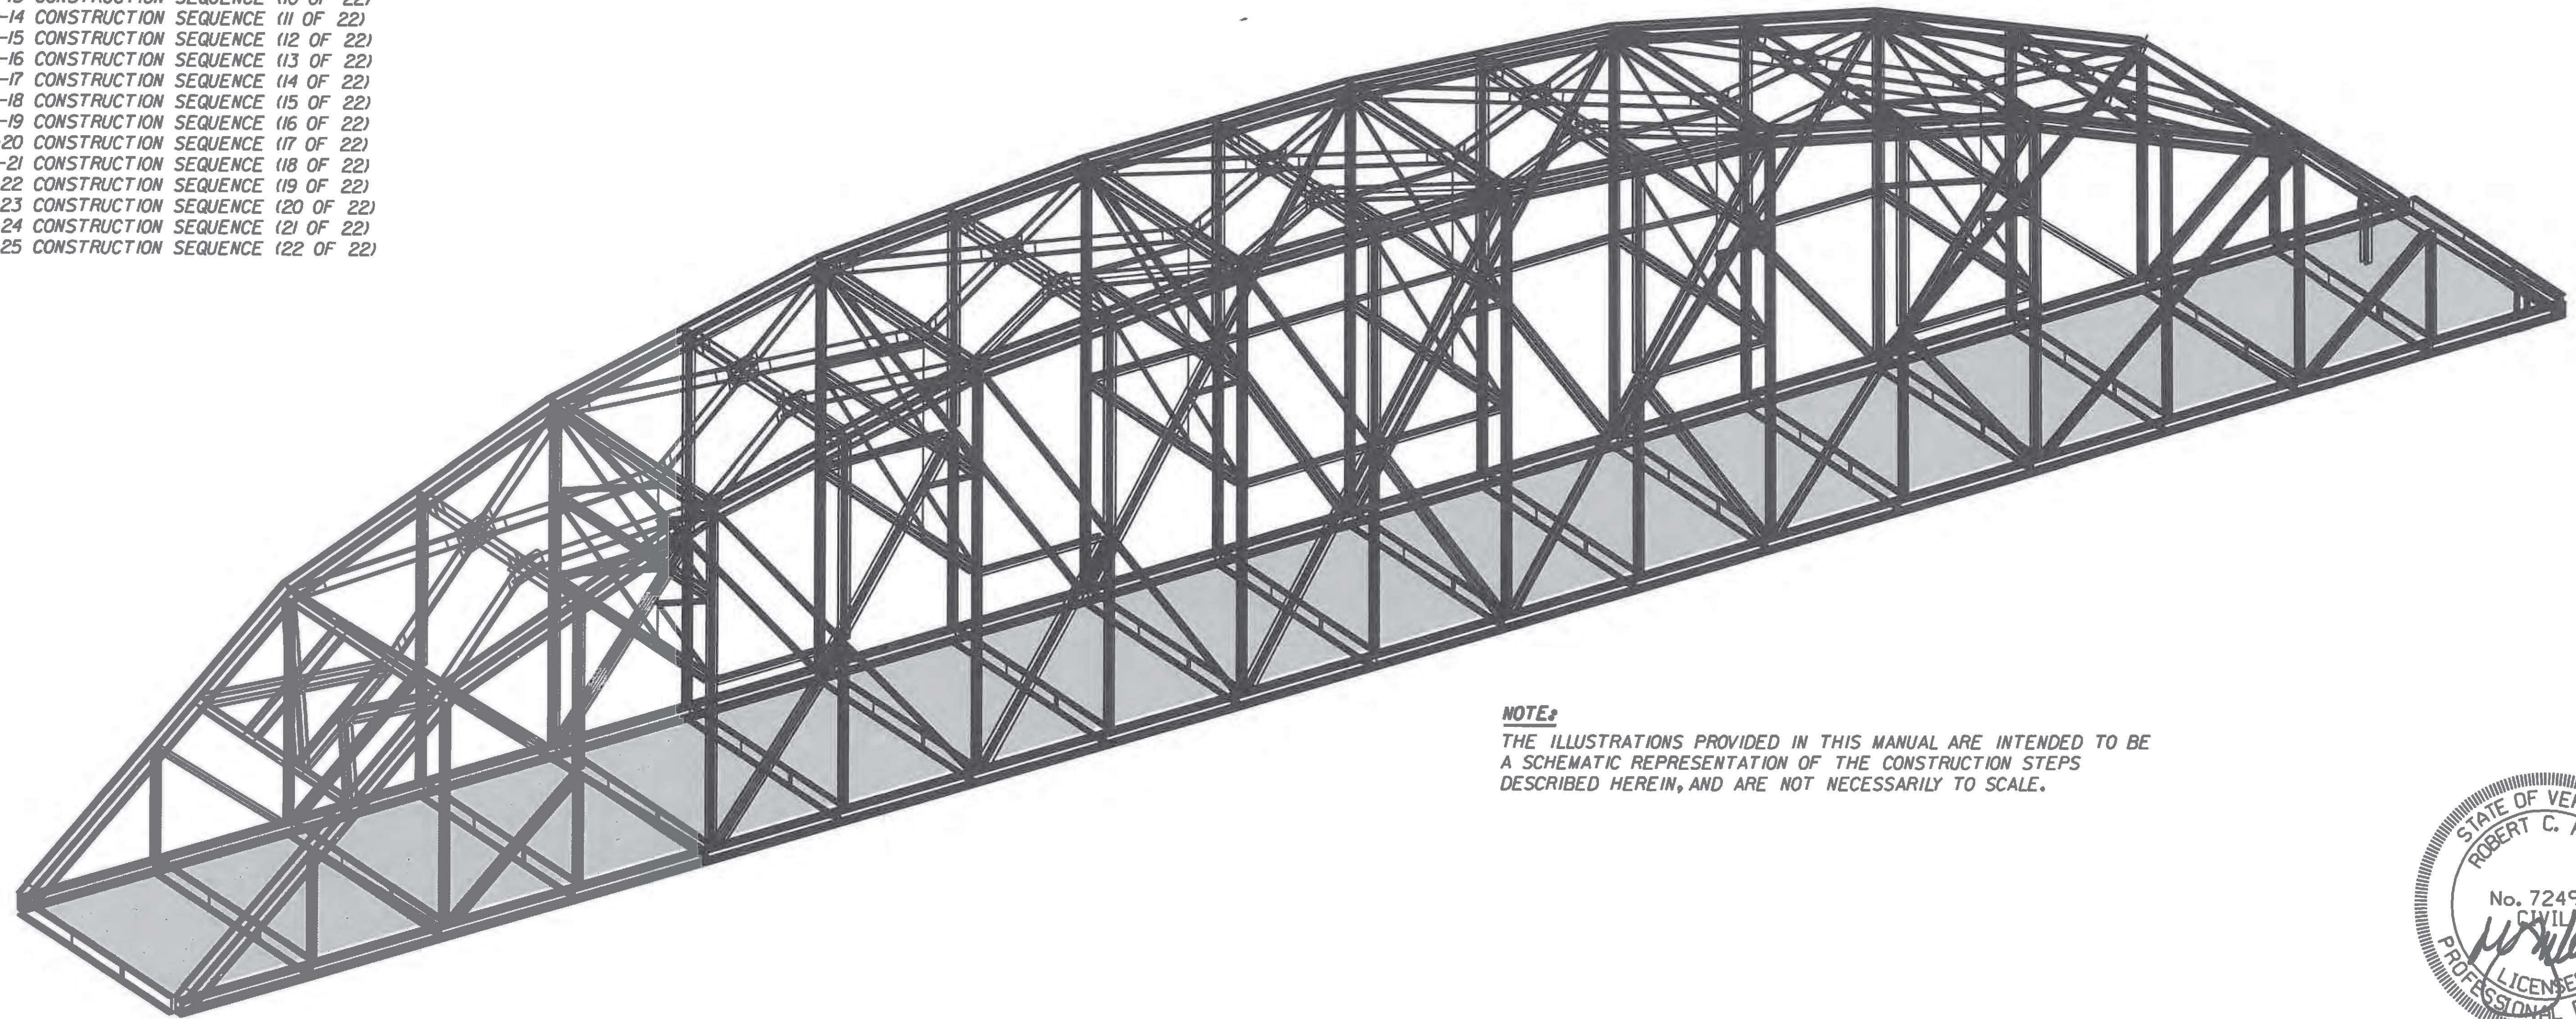

NOTE:

THE ILLUSTRATIONS PROVIDED IN THIS MANUAL ARE INTENDED TO BE A SCHEMATIC REPRESENTATION OF THE CONSTRUCTION STEPS DESCRIBED HEREIN, AND ARE NOT NECESSARILY TO SCALE.

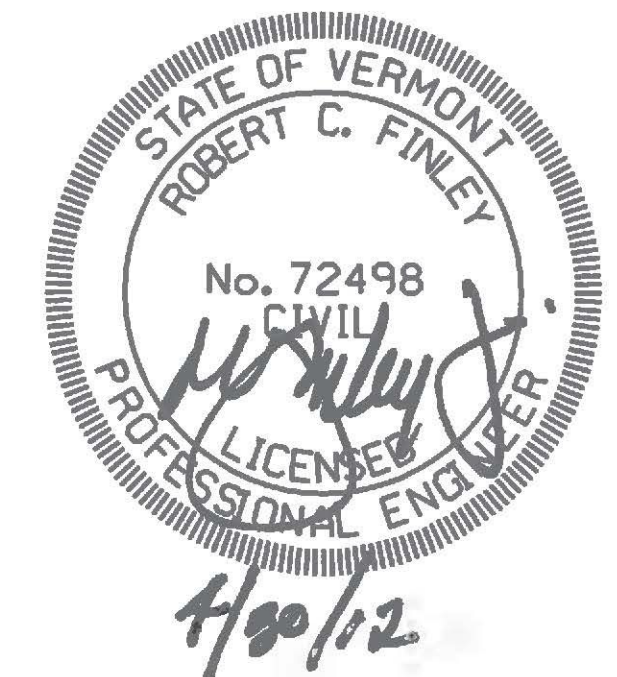

Revision	Drawn By	Date	Description	Revision	Drawn By	Date	Description	Name	Date	Project	Title	Sheet No.	
1	JLB	04/24/12	Added Reference 5. Removed Sheet CM-06					Drawn By: RAA	01/12	FINLEY Engineering Group, Inc. 1589 Metropolitan Blvd. Tallahassee, FL 32308 850-894-1600 Fax: 850-894-1614	RICHMOND TRUSS WIDENING STATE OF VERMONT AGENCY OF TRANSPORTATION CHITTENDEN COUNTY U.S. ROUTE 2 BRIDGE NO. 24	CONSTRUCTION MANUAL INDEX AND GENERAL NOTES	CM-01
							Designed By: JMP	01/12					
							Approved By: RCF	01/12					