



ISOMETRIC VIEW

STAGE 10:
 A. INSTALL TEMPORARY LONGITUDINAL STRINGERS.
 B. INSTALL BEAM CLAMPS FROM TEMPORARY LONGITUDINAL STRINGERS TO EACH FLOOR BEAM NOT SUPPORTED BY A TRANSVERSE SUPPORT BEAM.

STAGE 11:
 A. INSTALL PHASE 2 OF QUICK DECK SYSTEM.

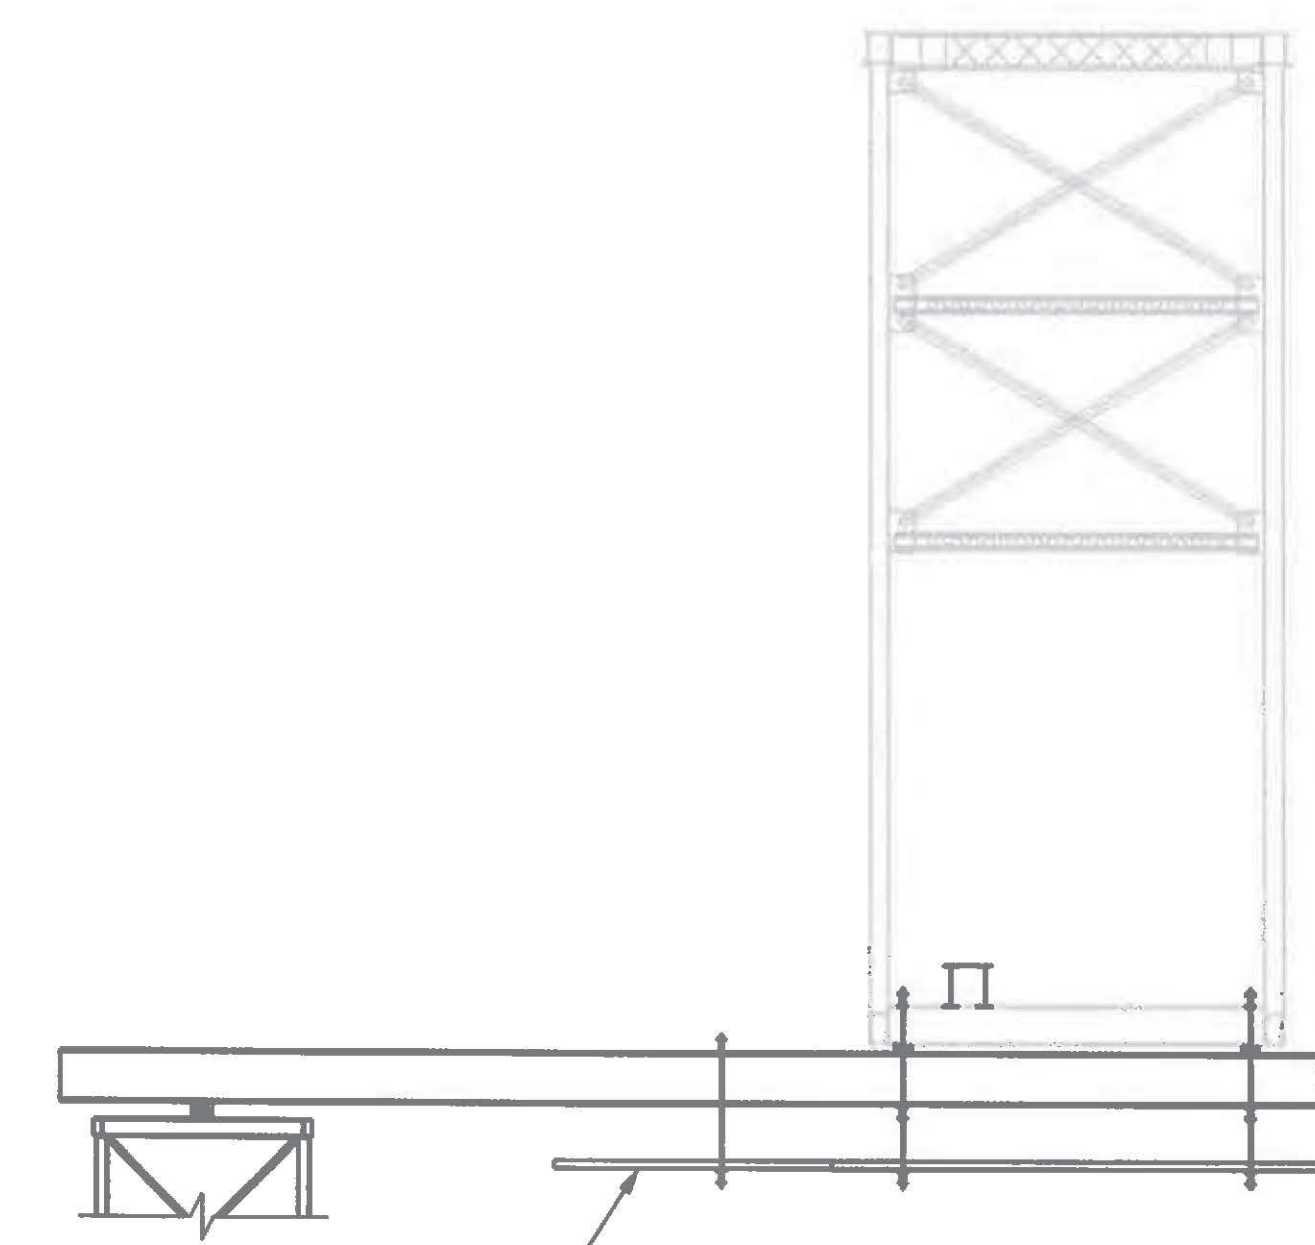

END VIEW

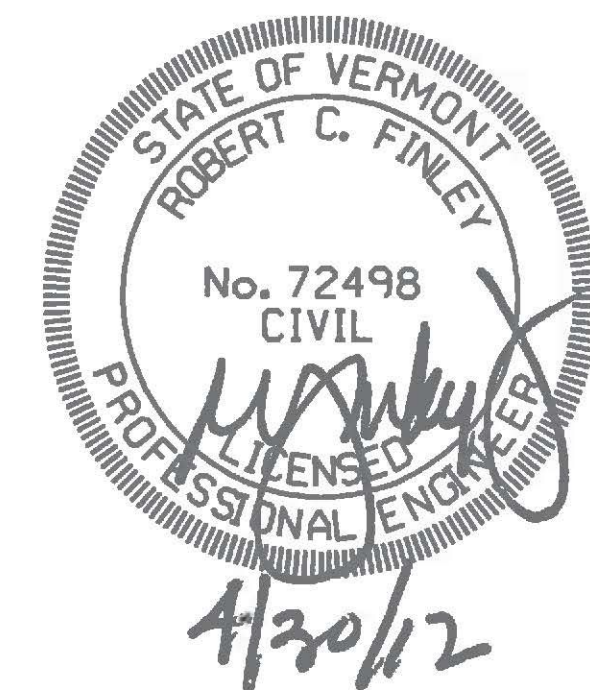

Revision	Drawn By	Date	Description	Revision	Drawn By	Date	Description
1	JLB	04/25/12	Removed Mabey Truss.				

Name	Date
Drawn By: DAL	01/12
Designed By: RAA	12/11
Approved By: JMP	12/11

FINLEY
 Engineering Group, Inc.
 1589 Metropolitan Blvd.
 Tallahassee, FL 32308
 850-894-1600
 Fax: 850-894-1614

Project:
 RICHMOND TRUSS WIDENING
 STATE OF VERMONT AGENCY OF TRANSPORTATION
 CHITTENDEN COUNTY
 U.S. ROUTE 2 BRIDGE NO. 24

Title:
 CONSTRUCTION MANUAL
 CONSTRUCTION SEQUENCE (5 OF 22)

Sheet No.
 CM-08