


ISOMETRIC VIEW

STAGE 14s

- A. INSTALL TEMPORARY TOP CHORD ABUTMENT CONNECTION AT BOTH ABUTMENTS.
- B. POSITION TEMPORARY UPPER CHORD TUBING MEMBERS BETWEEN SUPPORT BRACKETS ALONG LENGTH OF TRUSS. ADJUST BRACKETS/TUBING AS REQUIRED FOR FIT UP. INSTALL BOLTS AT ABUTMENT CONNECTIONS.
- C. TIGHTEN 1" DIAMETER RODS FOR NORTH BRACKETS TO SPECIFIED TENSION.
- D. FIELD WELD TEMPORARY TOP CHORD MEMBERS TO BRACKETS.

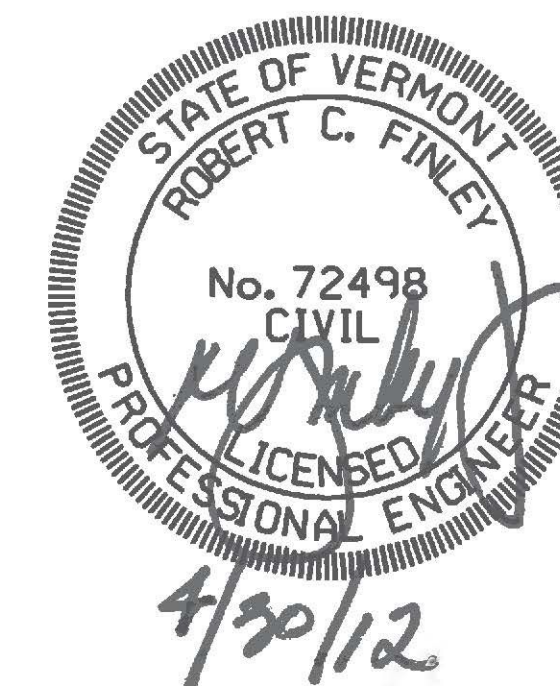

Revision	Drawn By	Date	Description	Revision	Drawn By	Date	Description	Drawn By	Name	Date	Project	Title	Sheet No.		
1	JLB	04/25/12	Removed Mabey Truss.					Drawn By	DAL	01/12	FINLEY Engineering Group, Inc. 1589 Metropolitan Blvd. Tallahassee, FL 32308 850-894-1600 Fax: 850-894-1614	RICHMOND TRUSS WIDENING STATE OF VERMONT AGENCY OF TRANSPORTATION CHITTENDEN COUNTY U.S. ROUTE 2 BRIDGE NO. 24	CONSTRUCTION MANUAL CONSTRUCTION SEQUENCE (7 OF 22)	CM-10	
							Designed By	RAA	12/11						
								Approved By	JMP	12/11					