


ISOMETRIC VIEW

STAGE 16:

- A. INSTALL LONGITUDINAL BRACE ONTO NORTH TRUSS. TIGHTEN ALL 1" DIAMETER RODS TO SPECIFIED TENSION.
- B. INSTALL BOTTOM CHORD JACKING FRAME TO NORTH TRUSS AT TRUSS NODES L4, LB, LJO & LJ4.
- C. INSTALL DIAGONAL BRACE BETWEEN LONGITUDINAL BRACE AND HILMAN ROLLER ON TOP OF WT SUPPORT MEMBER.
- D. INSTALL HORIZONTAL BRACE BETWEEN JACKING FRAME AND DIAGONAL BRACE.
- E. INSTALL SOUTH TRUSS TEMPORARY BRACE.

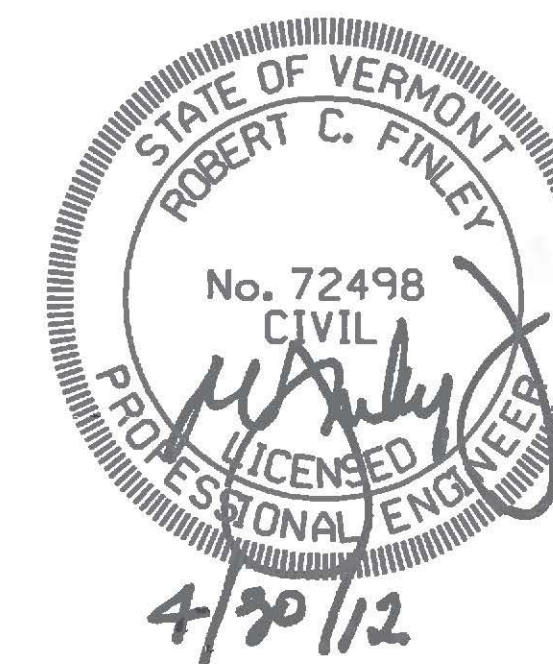

Revision	Drawn By	Date	Description	Revision	Drawn By	Date	Description	Name	Date	Project	Title	Sheet No.
1	JLB	04/25/12	Removed Mabey Truss.					Drawn By: DAL	01/12	RICHMOND TRUSS WIDENING STATE OF VERMONT AGENCY OF TRANSPORTATION CHITTENDEN COUNTY U.S. ROUTE 2 BRIDGE NO. 24	CONSTRUCTION MANUAL CONSTRUCTION SEQUENCE (9 OF 22)	CM-12
							Designed By: RAA	12/11				
							Approved By: JMP	12/11				