


ISOMETRIC VIEW

STAGE 24:

- A. UPON COMPLETION OF SIDE LAUNCH, INSTALL NEW TRANSVERSE DIAPHRAGMS AT NODES L0 AND L1B.
- B. TENSION SECONDARY CABLES TO A MINIMUM OF 5 KIPS EACH.

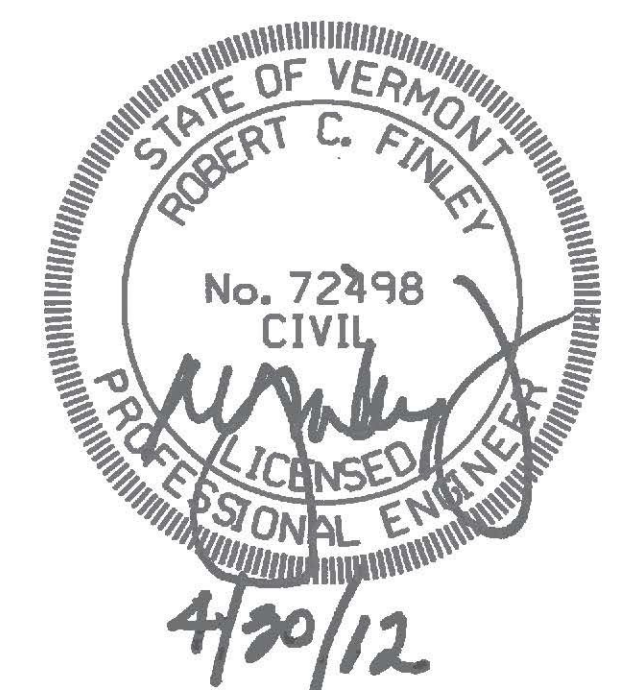

Revision	Drawn By	Date	Description	Revision	Drawn By	Date	Description	Drawn By:	Name	Date	Project:	Title:	Sheet No.	
1	JLB	04/25/12	Removed Mabey Truss.					Drawn By:	DAL	01/12	RICHMOND TRUSS WIDENING STATE OF VERMONT AGENCY OF TRANSPORTATION CHITTENDEN COUNTY U.S. ROUTE 2 BRIDGE NO. 24	CONSTRUCTION MANUAL CONSTRUCTION SEQUENCE (13 OF 22)	CM-16	
							Designed By:	RAA	12/11					
							Approved By:	JMP	12/11					