


ISOMETRIC VIEW

**STAGE 27:**

- A. INSTALL NEW PORTAL FRAME BRACING.
- B. REPLACE EXISTING FLOORBEAMS AND DIAGONALS AT NODES U<sub>1</sub>, L<sub>2</sub>, L<sub>3</sub>, U<sub>5</sub>, U<sub>6</sub>, U<sub>7</sub>.  
REINSTALL BEAM CLAMPS TO TEMPORARY LONGITUDINAL STRINGERS AFTER INSTALLATION OF EACH FLOOR BEAM.
- C. INSTALL NEW BRACING AT UPPER TRUSS NODES U<sub>3</sub>, U<sub>4</sub>, U<sub>14</sub>, U<sub>15</sub>.
- D. INSTALL NEW TRANSVERSE BRACING FOR VERTICALS L<sub>4</sub>-U<sub>4</sub>, U<sub>14</sub>-U<sub>14</sub>.

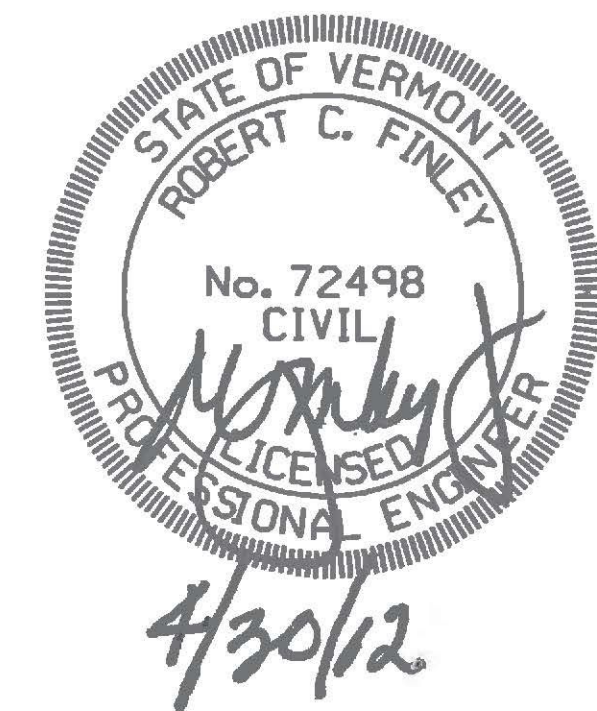

Revision	Drawn By	Date	Description	Revision	Drawn By	Date	Description	Name	Date	Projects	Title	Sheet No.		
1	JLB	04/25/12	Removed Mabey Truss.					DAL	01/12	1589 Metropolitan Blvd. Tallahassee, FL 32308 850-894-1600 Fax: 850-894-1614 <b>FINLEY</b> Engineering Group, Inc.	RICHMOND TRUSS WIDENING STATE OF VERMONT AGENCY OF TRANSPORTATION CHITTENDEN COUNTY U.S. ROUTE 2 BRIDGE NO. 24	CONSTRUCTION MANUAL CONSTRUCTION SEQUENCE (15 OF 22)	CM-1B	
							RAA	12/11						
							JMP	12/11						