


ISOMETRIC VIEW

STAGE 28:

- A. INSTALL NEW BRACING AT UPPER TRUSS NODES U5, U6, U12, U13.
- B. INSTALL NEW TRANSVERSE BRACING FOR VERTICALS L6-U6, U2-U12.

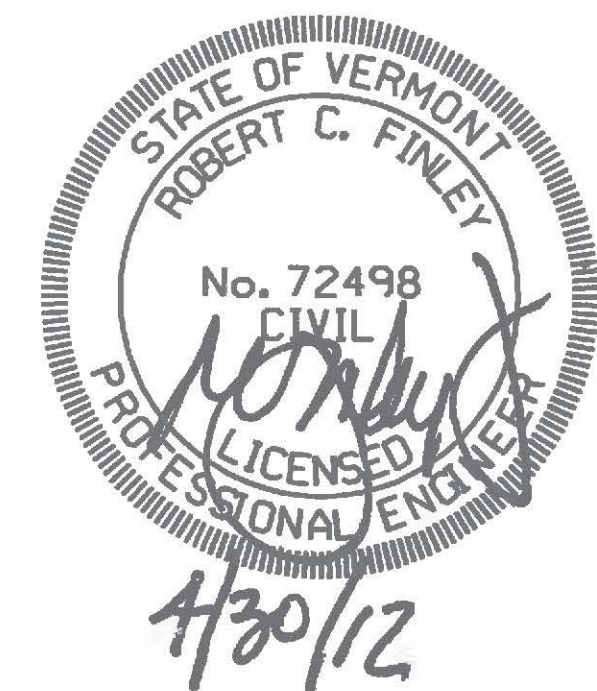

Revision	Drawn By	Date	Description	Revision	Drawn By	Date	Description	Name	Date	Project	Title	Sheet No.	
1	JLB	04/25/12	Removed Mabey Truss.					Drawn By: DAL	01/12	FINLEY Engineering Group, Inc. 1589 Metropolitan Blvd. Tallahassee, FL 32308 850-894-1600 Fax: 850-894-1614	RICHMOND TRUSS WIDENING STATE OF VERMONT AGENCY OF TRANSPORTATION CHITTENDEN COUNTY U.S. ROUTE 2 BRIDGE NO. 24	CONSTRUCTION MANUAL CONSTRUCTION SEQUENCE (16 OF 22)	CM-19
							Designed By: RAA	12/11					
							Approved By: JMP	12/11					