


STAGE 30e

- A. DESTRESS AND REMOVE TEMPORARY CABLE BRACING.
- B. REMOVE TEMPORARY TOWERS AT TRUSS NODES L2-U2, L4-U4, L8-U8, L10-U10, L12-U12, L14-U14.
- C. REMOVE TEMPORARY TOP CHORD MEMBERS BEGINNING FROM ABUTMENTS AND PROCEEDING SYMMETRICALLY TOWARDS THE CENTER OF THE BRIDGE.
- D. REMOVE TOP CHORD LAUNCHING BEAMS IN THE FOLLOWING ORDER: U4, U14, U8, U10.
- E. REMOVE SOUTH TRUSS BRACE.

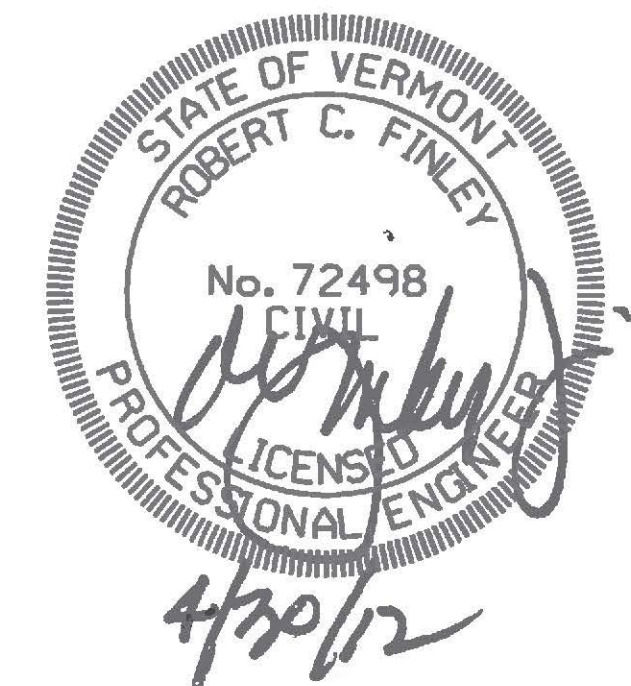

Revision	Drawn By	Date	Description	Revision	Drawn By	Date	Description	Name	Date	Project	Title	Sheet No.
1	JLB	04/25/12	Removed Mabey Truss.					Drawn By: DAL	01/12	RICHMOND TRUSS WIDENING STATE OF VERMONT AGENCY OF TRANSPORTATION CHITTENDEN COUNTY U.S. ROUTE 2 BRIDGE NO. 24	CONSTRUCTION MANUAL CONSTRUCTION SEQUENCE (18 OF 22)	CM-21
							Designed By: RAA	12/11				
							Approved By: JMP	12/11				