


ISOMETRIC VIEW

STAGE 31a

- A. REMOVE HORIZONTAL BRACING.
- B. REMOVE DIAGONAL BRACING.
- C. REMOVE LONGITUDINAL BRACE.

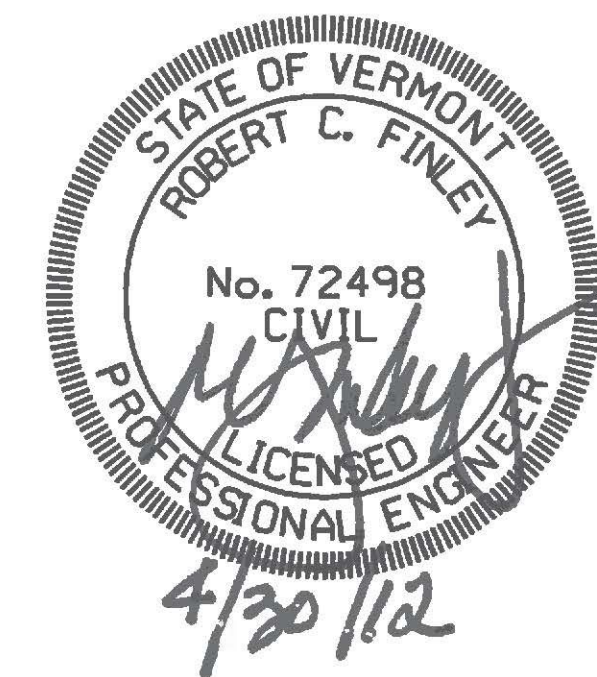

Revision	Drawn By	Date	Description	Revision	Drawn By	Date	Description	Name	Date	Project	Title	Sheet No.
1	JLB	04/25/12	Removed Mabey Truss.					Drawn By: DAL	01/12	RICHMOND TRUSS WIDENING STATE OF VERMONT AGENCY OF TRANSPORTATION CHITTENDEN COUNTY U.S. ROUTE 2 BRIDGE NO. 24	CONSTRUCTION MANUAL CONSTRUCTION SEQUENCE (19 OF 22)	CM-22
							Designed By: RAA	12/11				
							Approved By: JMP	12/11				