


STAGE 32:

- A. INSTALL NEW FLOORBEAMS AND DIAGONALS AT NODES L5, U3, L6, U2, L7, U1, L9.
- B. REMOVE LONGITUDINAL STRINGERS.

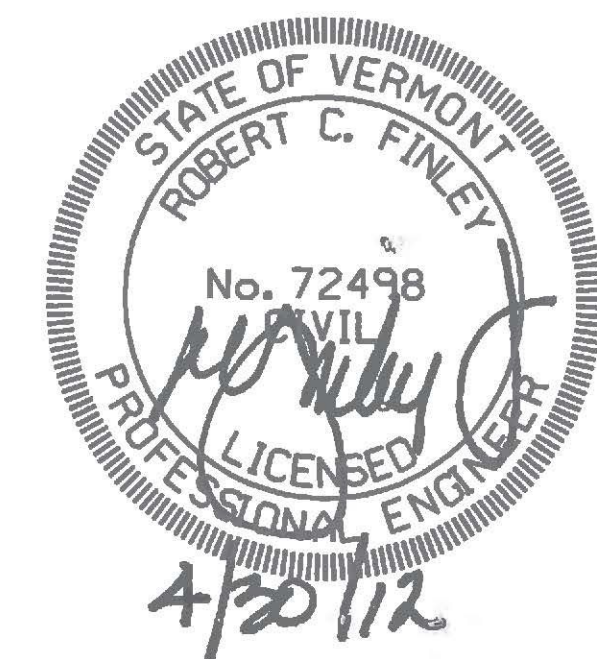

Revision	Drawn By	Date	Description	Revision	Drawn By	Date	Description	Name	Date	Project	Title	Sheet No.	
1	JLB	04/25/12	Removed Mabey Truss.					Drawn By: DAL	01/12	FINNEY Engineering Group, Inc. 1589 Metropolitan Blvd. Tallahassee, FL 32308 850-894-1600 Fax: 850-894-1614	RICHMOND TRUSS WIDENING STATE OF VERMONT AGENCY OF TRANSPORTATION CHITTENDEN COUNTY U.S. ROUTE 2 BRIDGE NO. 24	CONSTRUCTION MANUAL CONSTRUCTION SEQUENCE (20 OF 22)	CM-23
							Designed By: RAA	12/11					
							Approved By: JMP	12/11					