
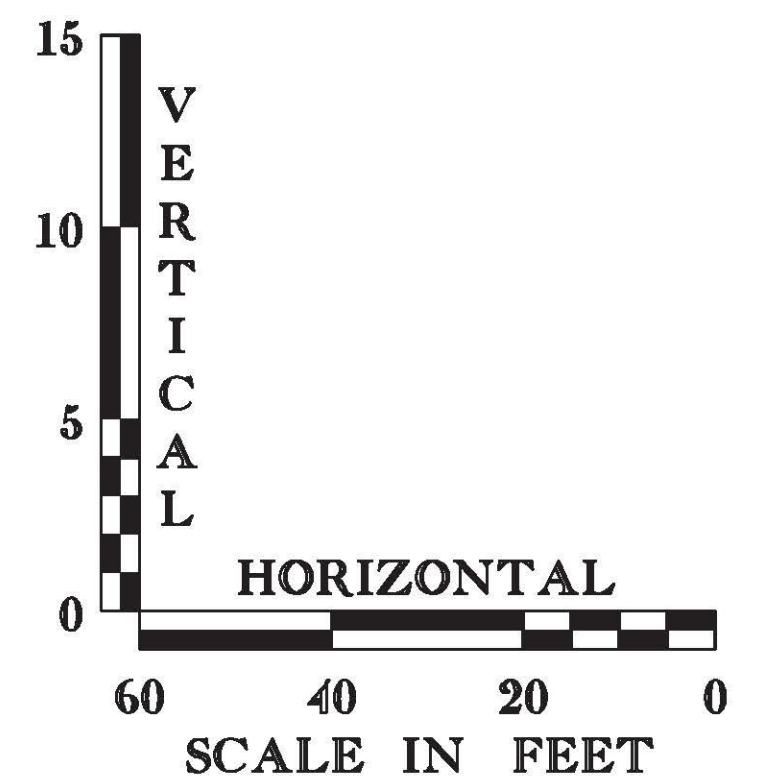


FILE NAME = V:\Projects\A\NY\K2\2076\CADD\MSTN\BRIDGE WORK\WBS (1-16) BRIDGE DESIGN\96c092_brdg-pro.dgn
 DATE/TIME = 3/14/2013
 USER = 3293

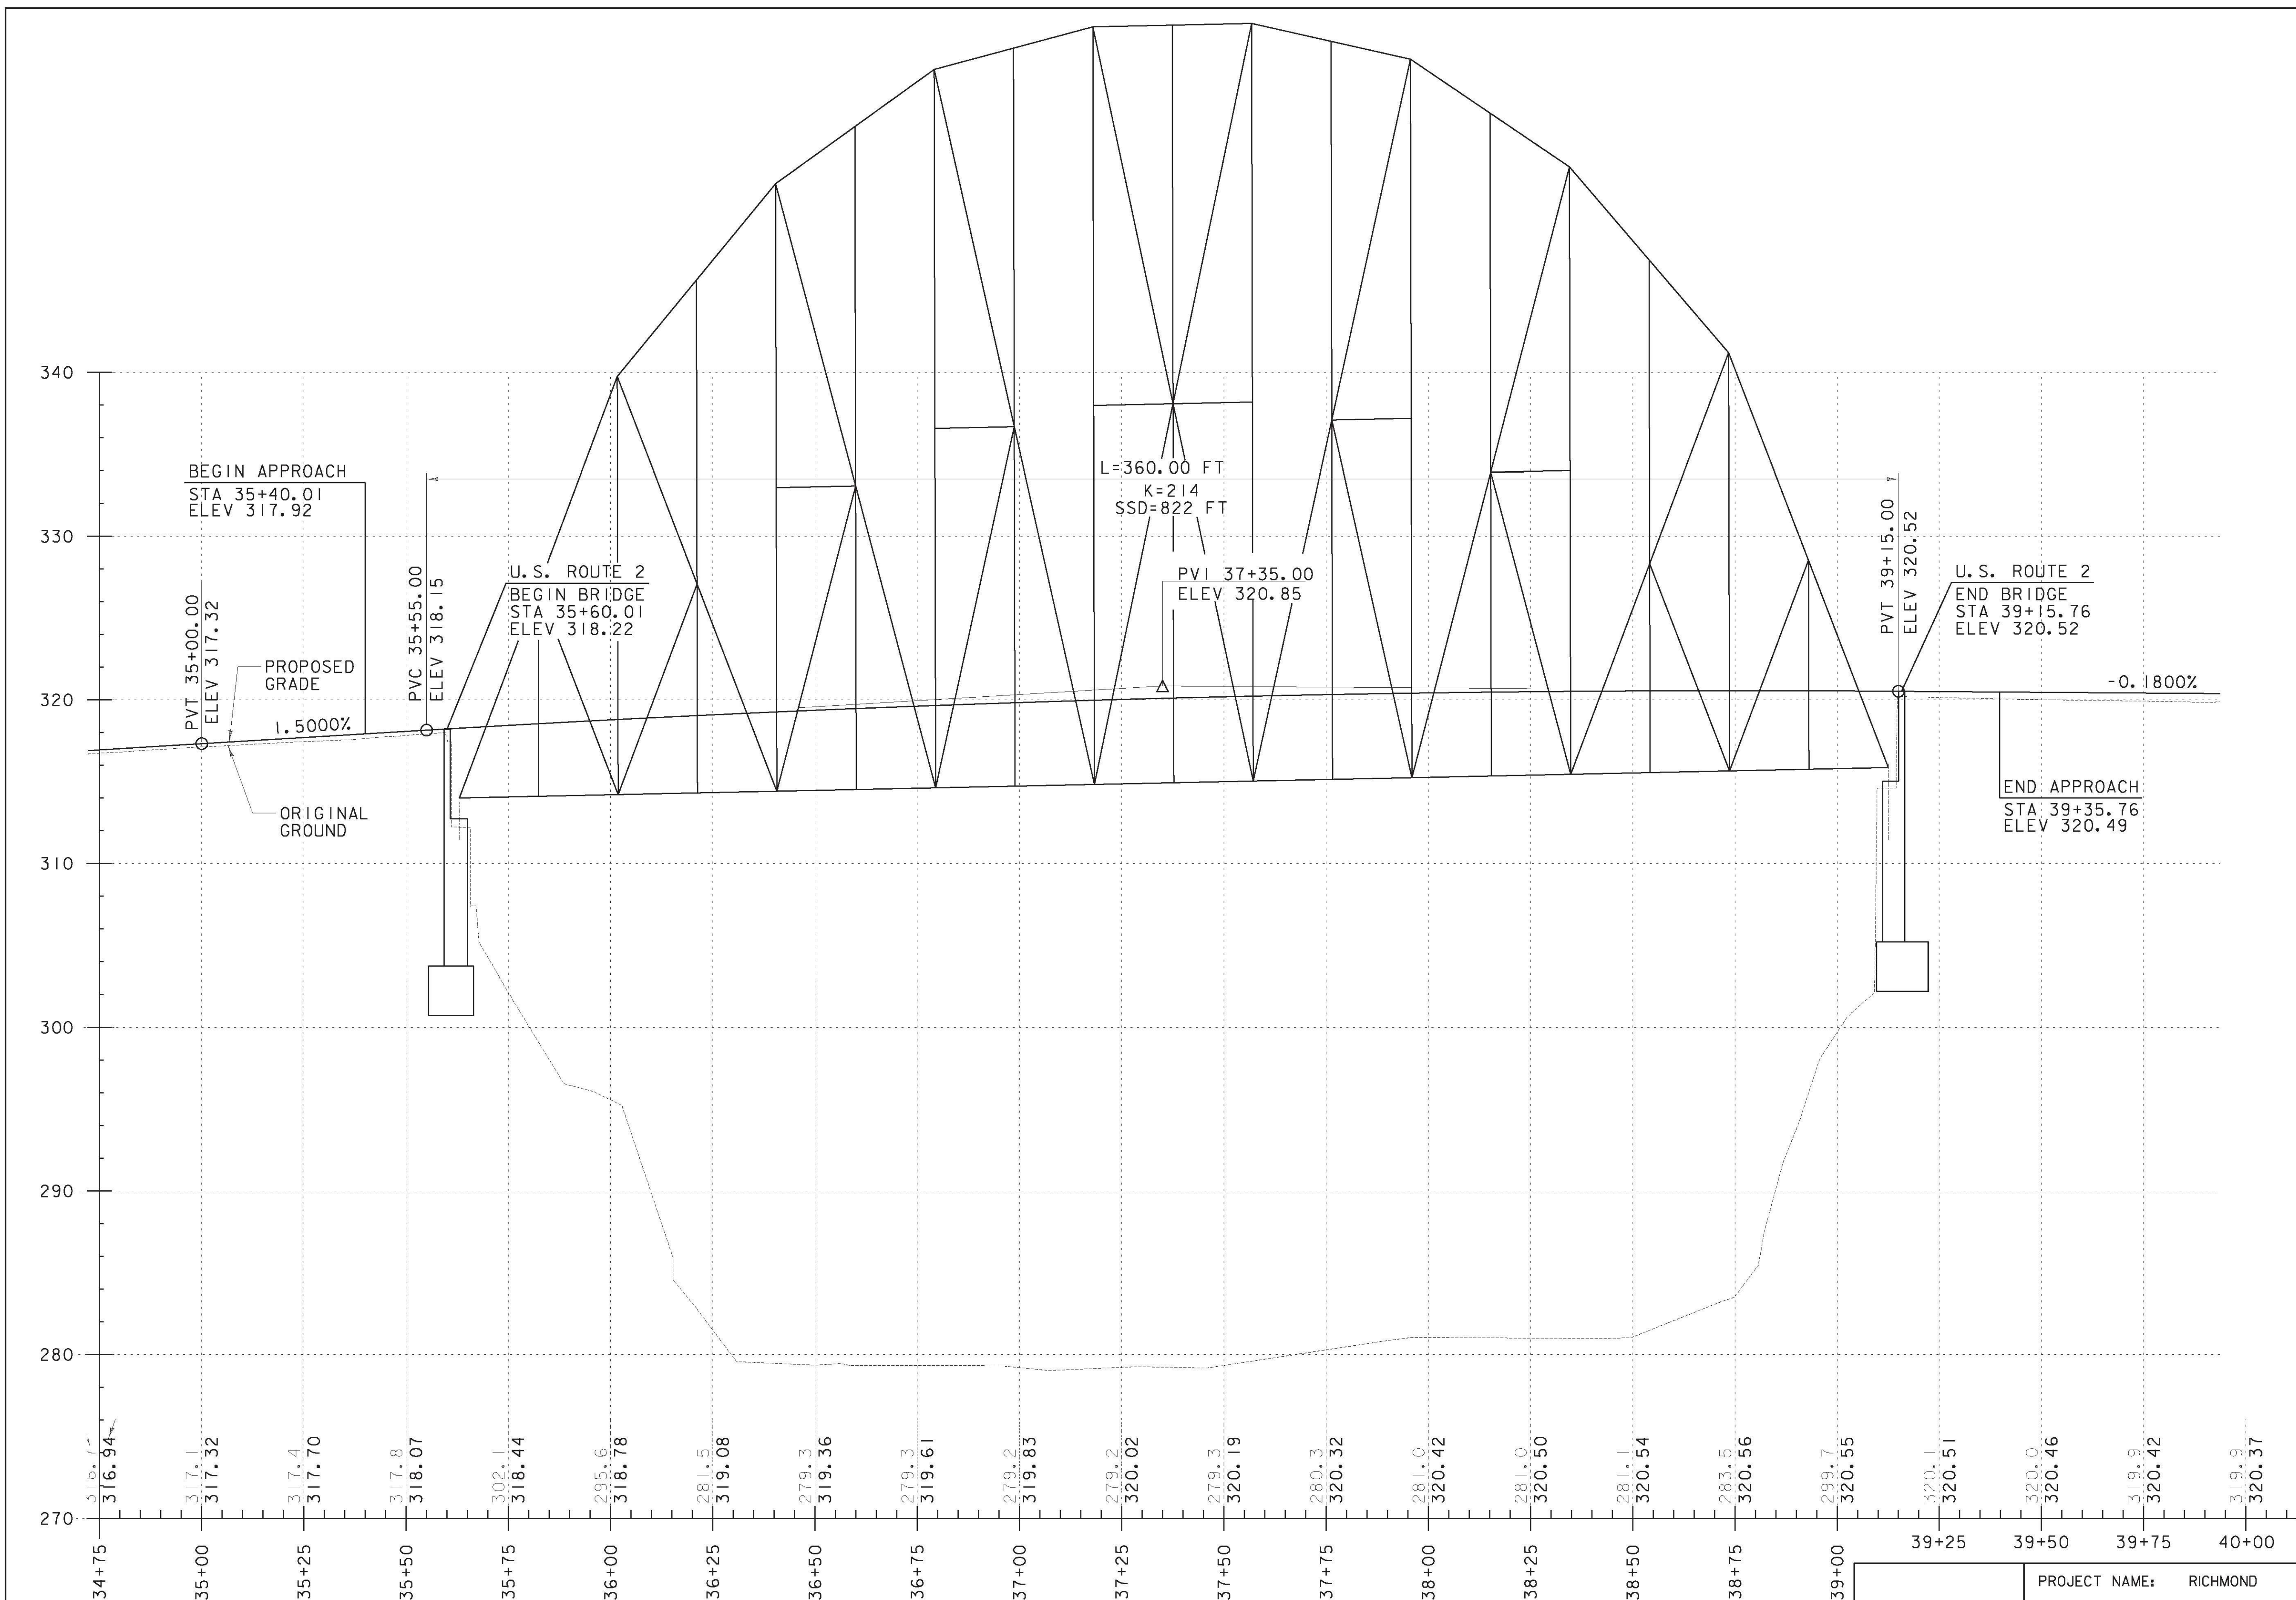

US ROUTE 2 PROFILE

PROFILE	PROJECT NAME: RICHMOND	PLOT DATE: 3/14/2013
	PROJECT NUMBER: STP-RS 0284(III)	DRAWN BY: PKR
	FILE NAME: z90c092_brdg-pro.dgn	CHECKED BY: DJV
	DESIGNED BY: DJV	SHEET X OF X
	DWG. NO.: S3	