

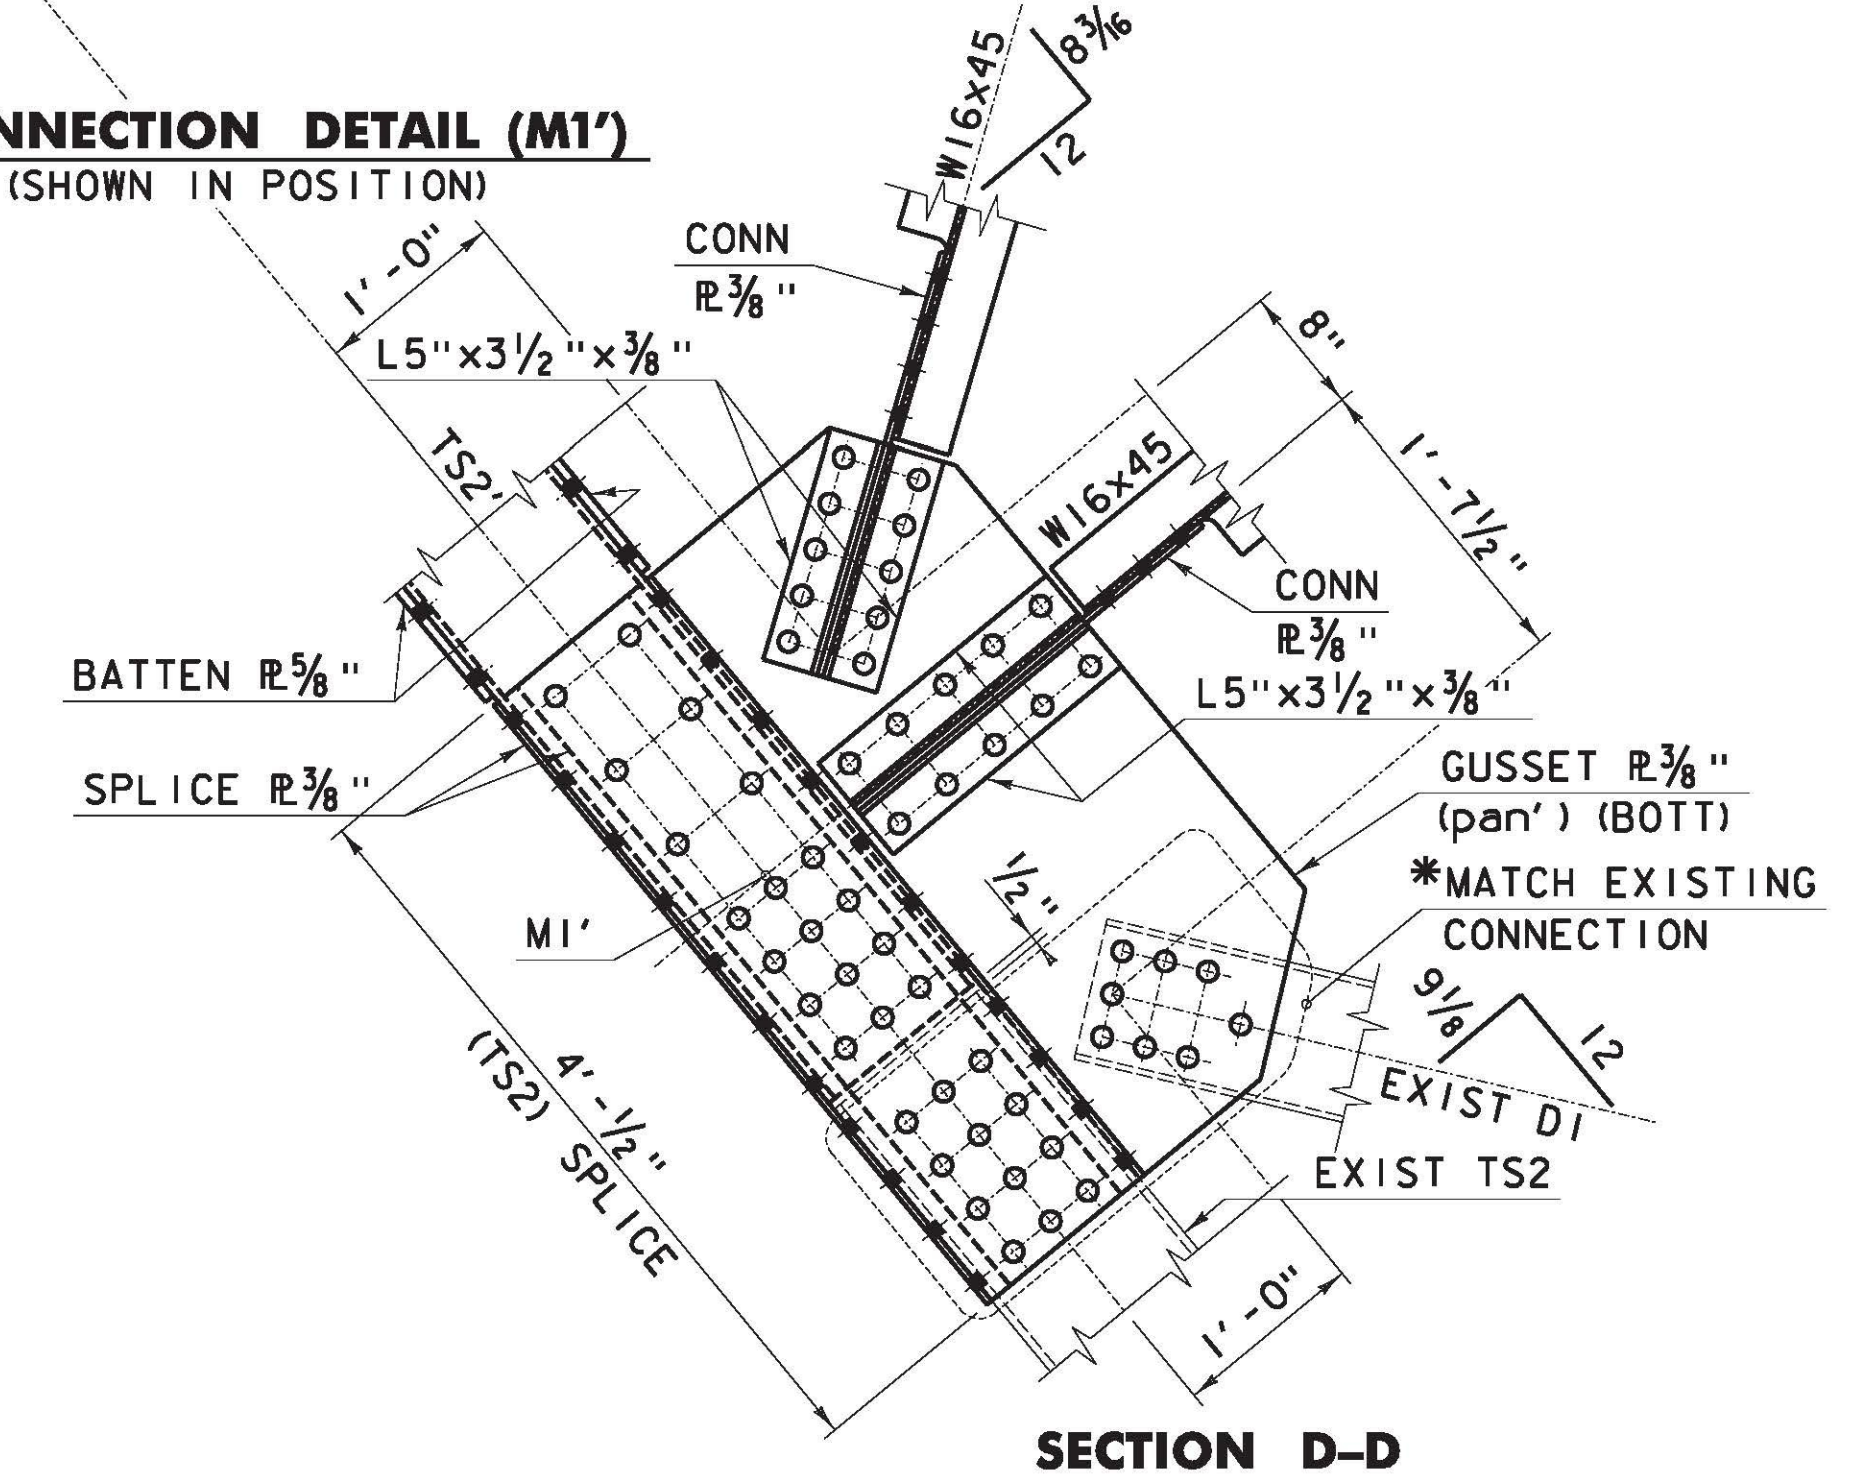
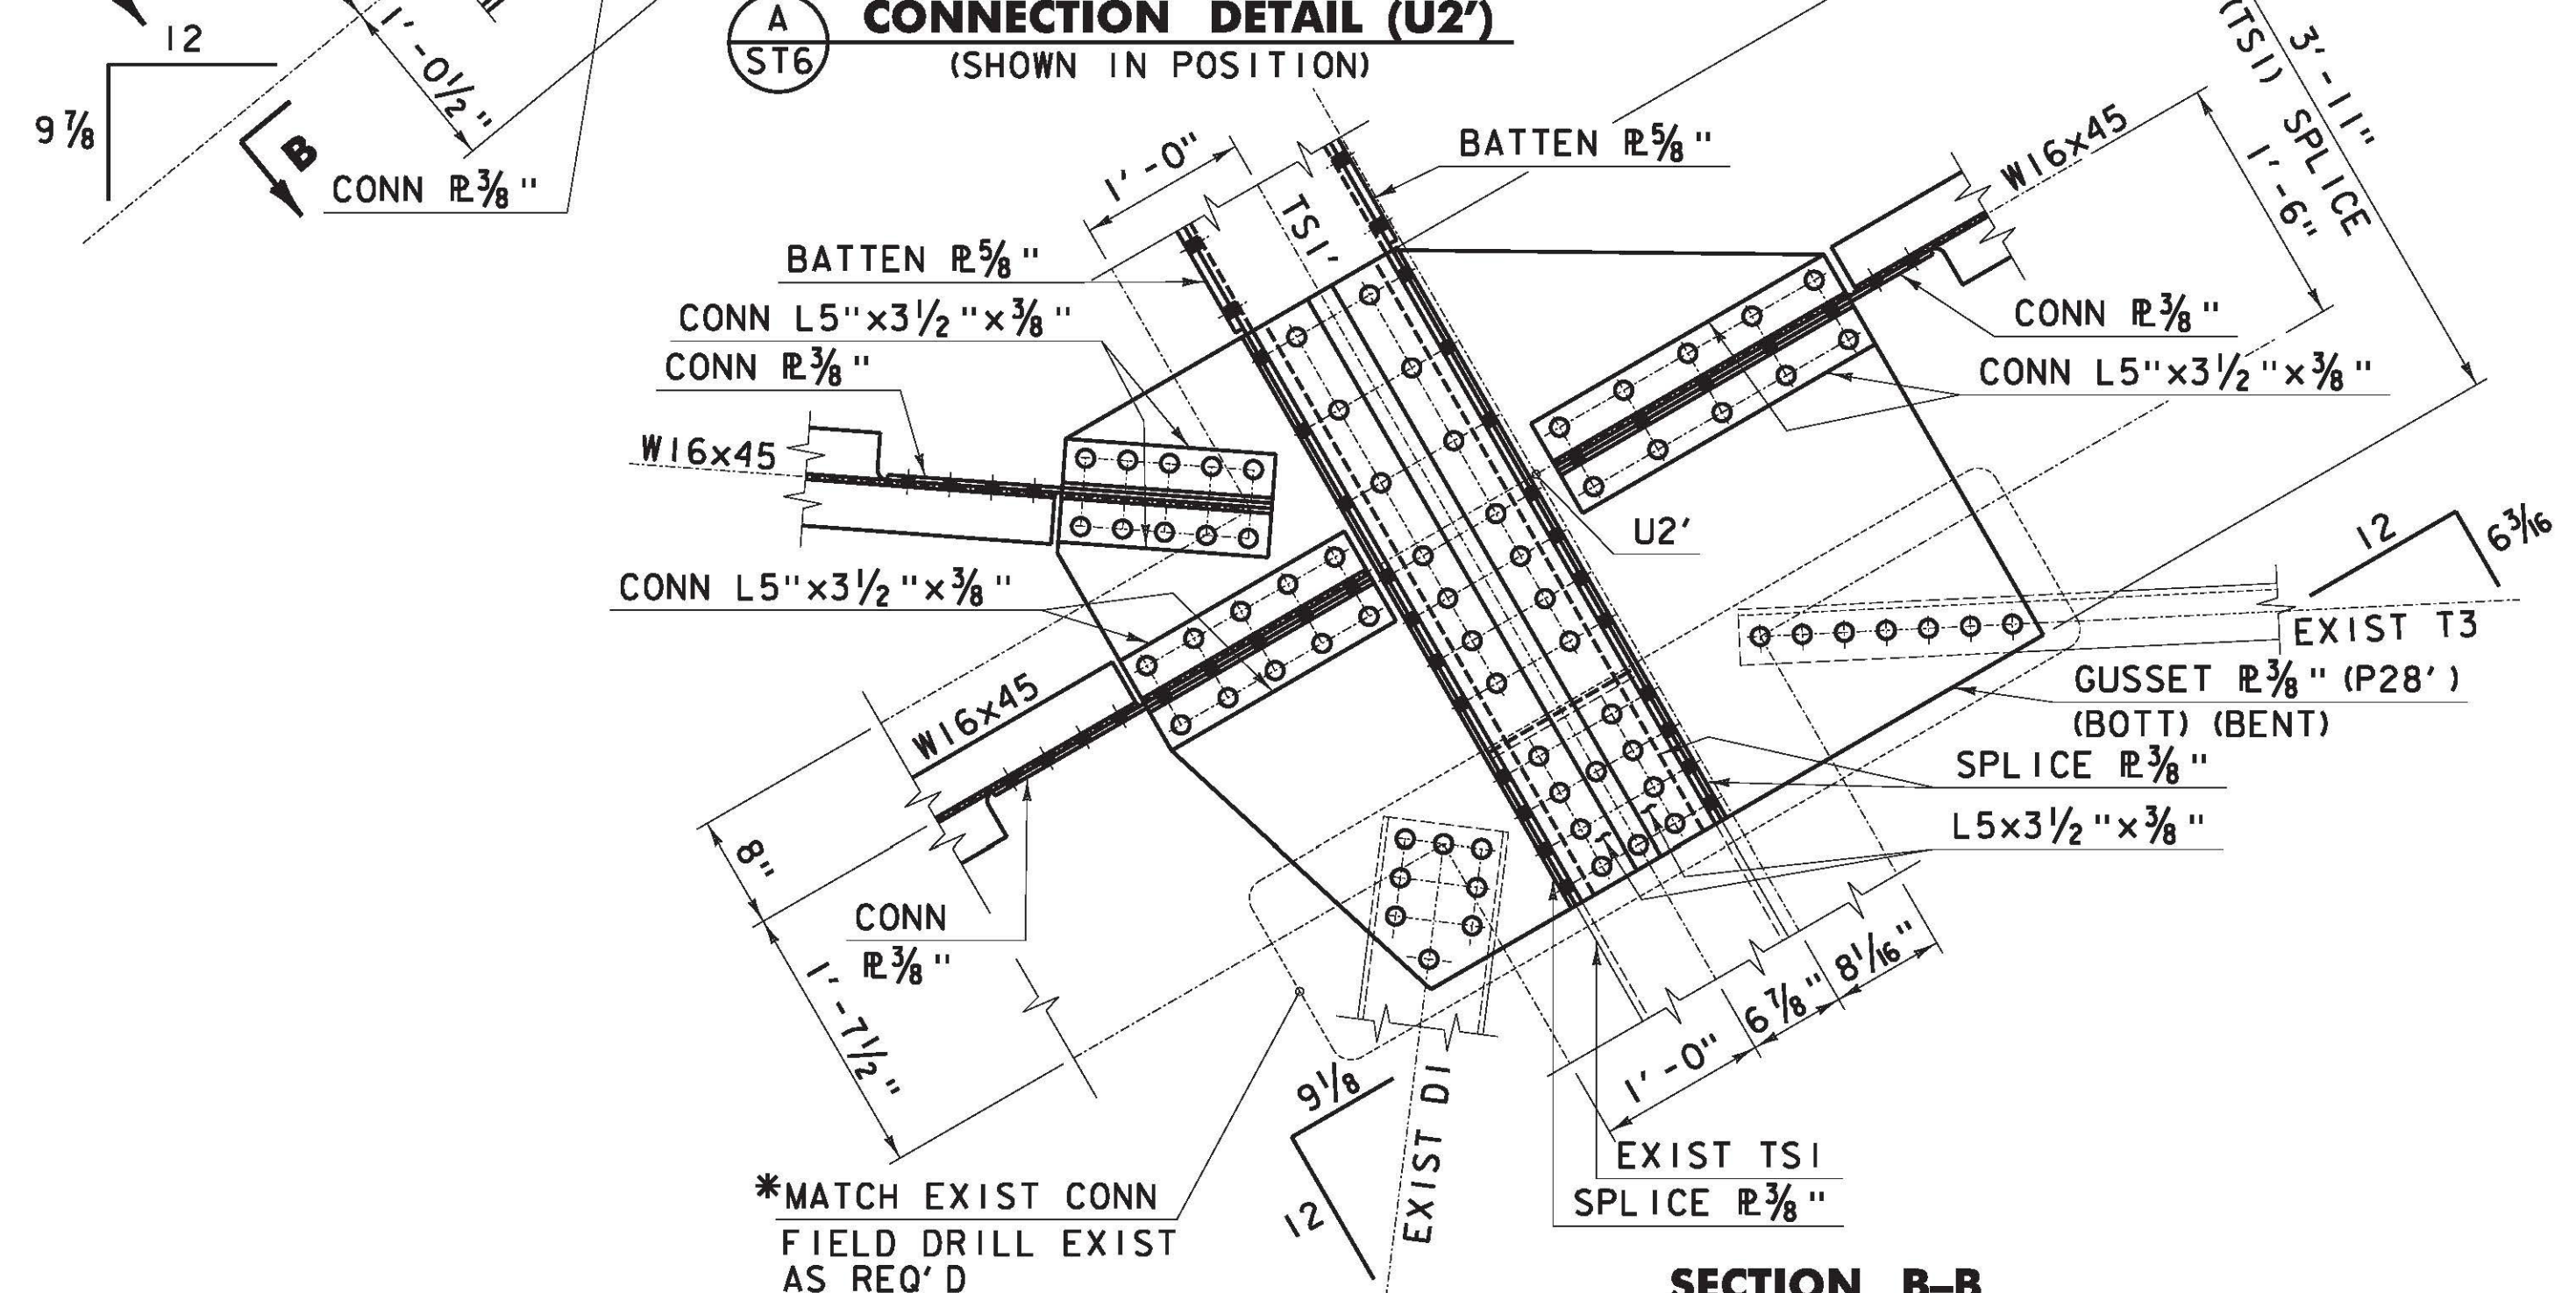
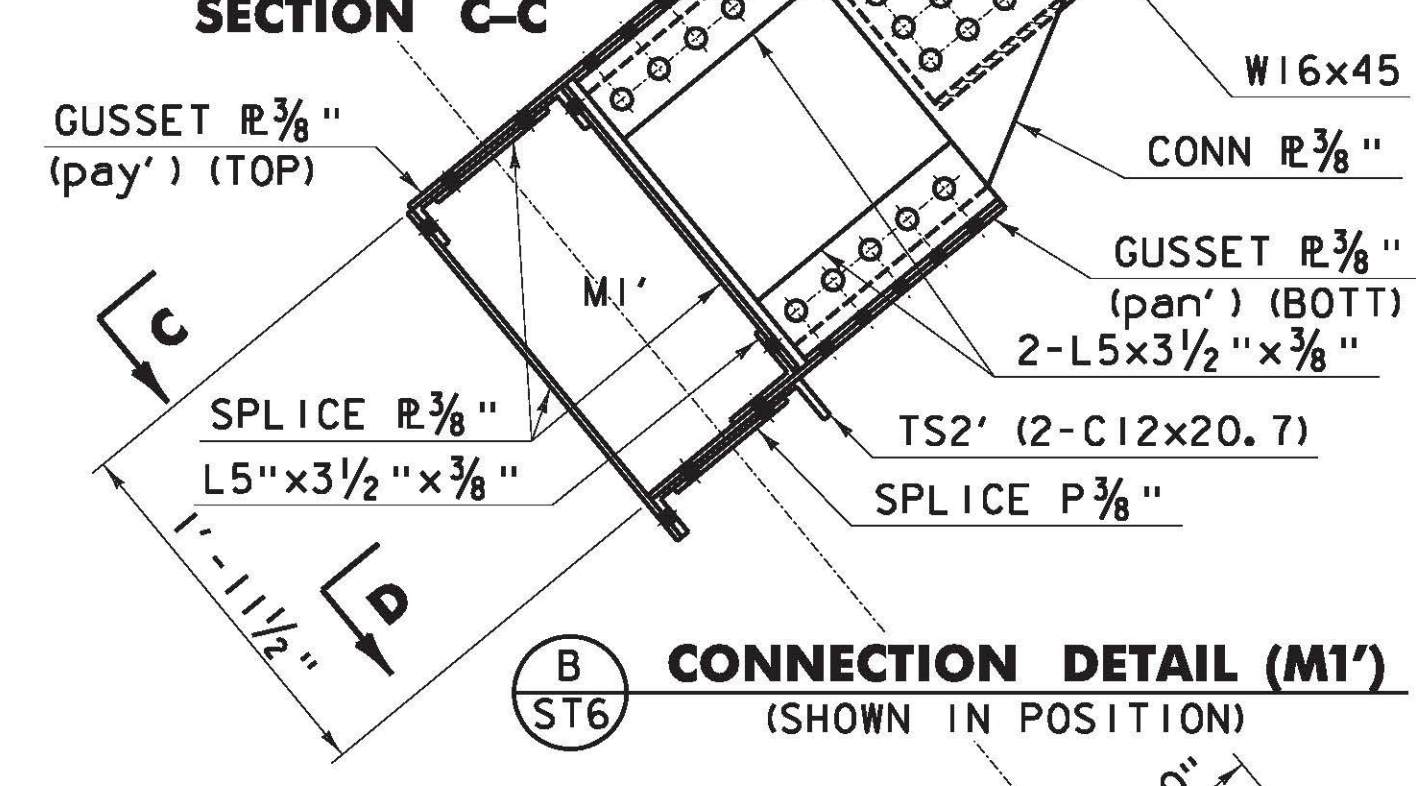
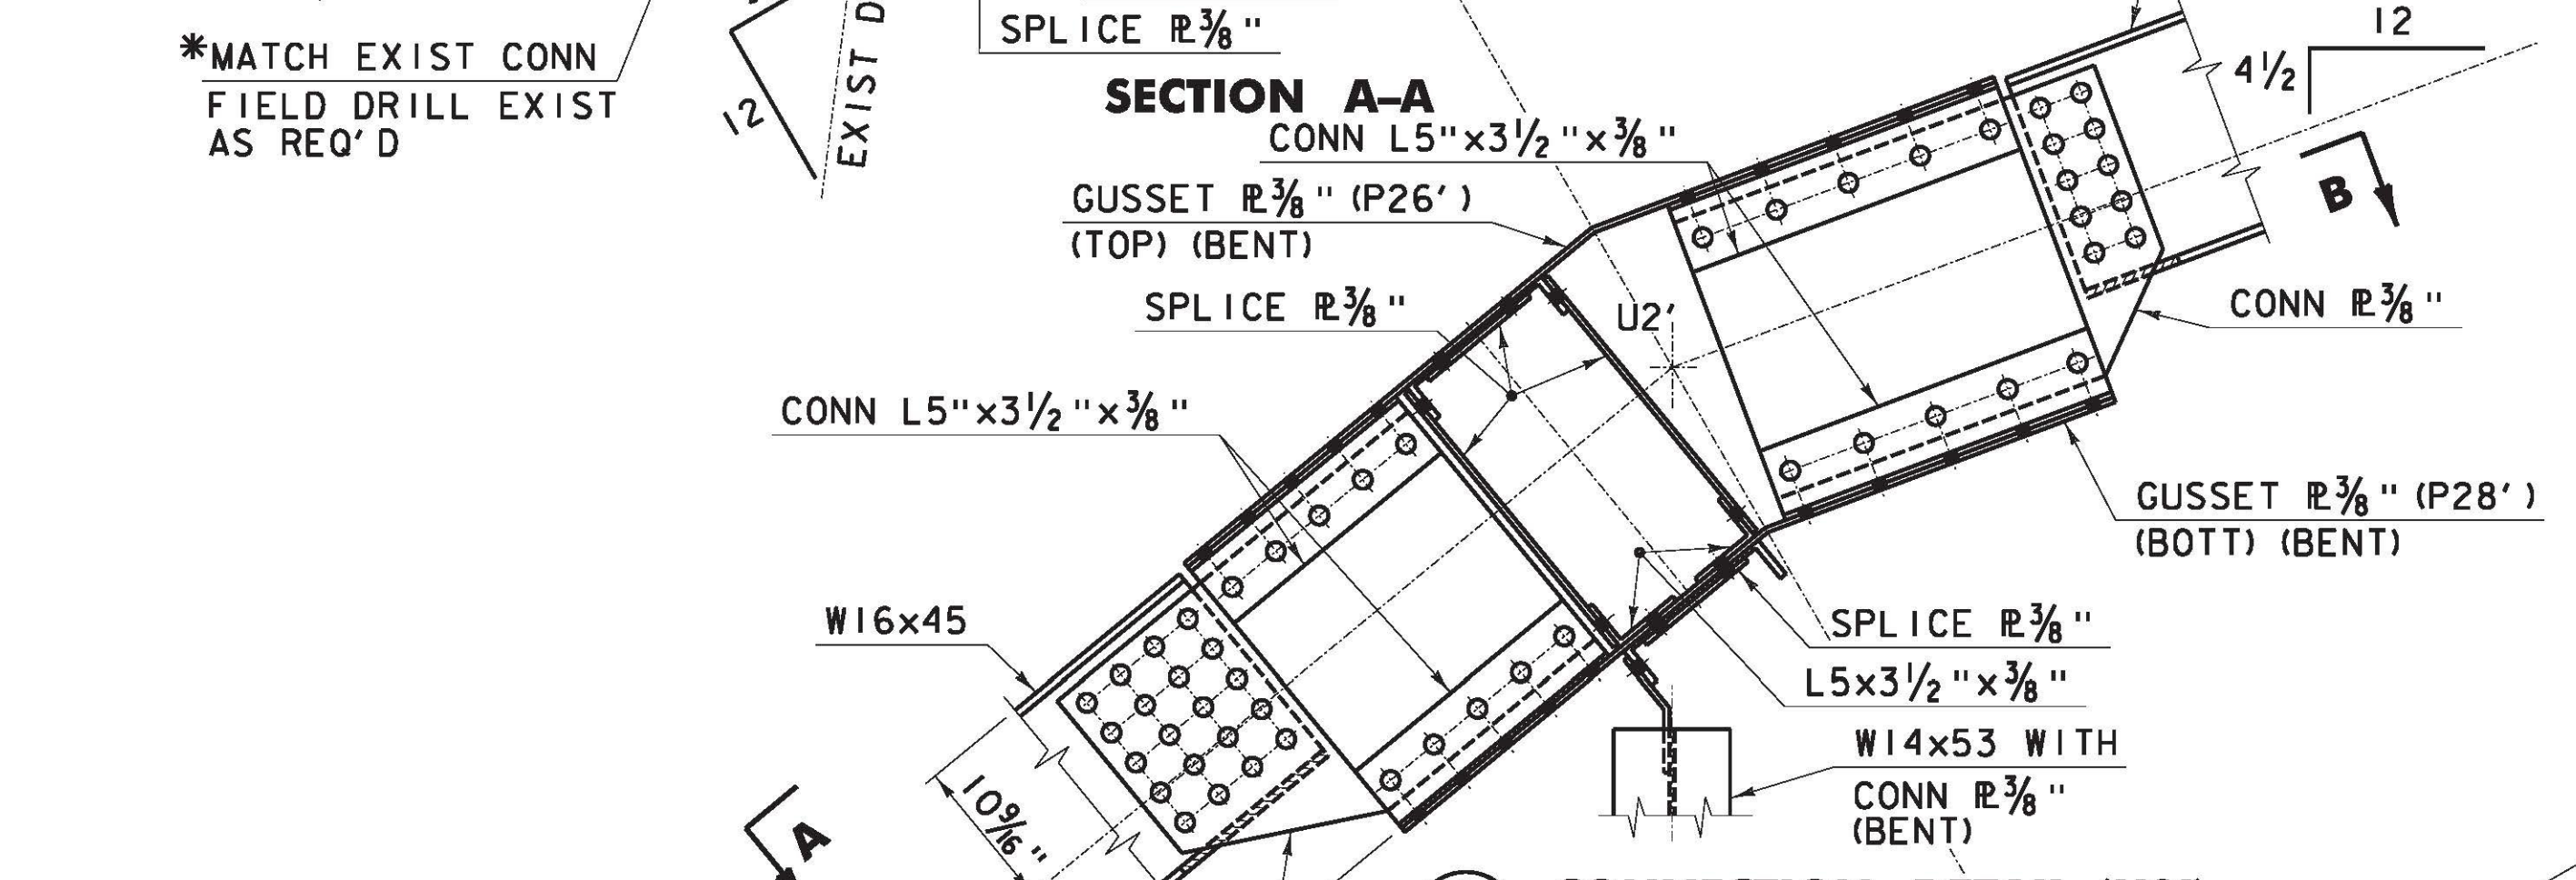


FILE NAME = V:\AP\Projects\161\BRIDGE\WORK\161\BRIDGE DESIGN\161\BRIDGE.dwg
 DATE/TIME = 3/14/2013
 USER = JCF

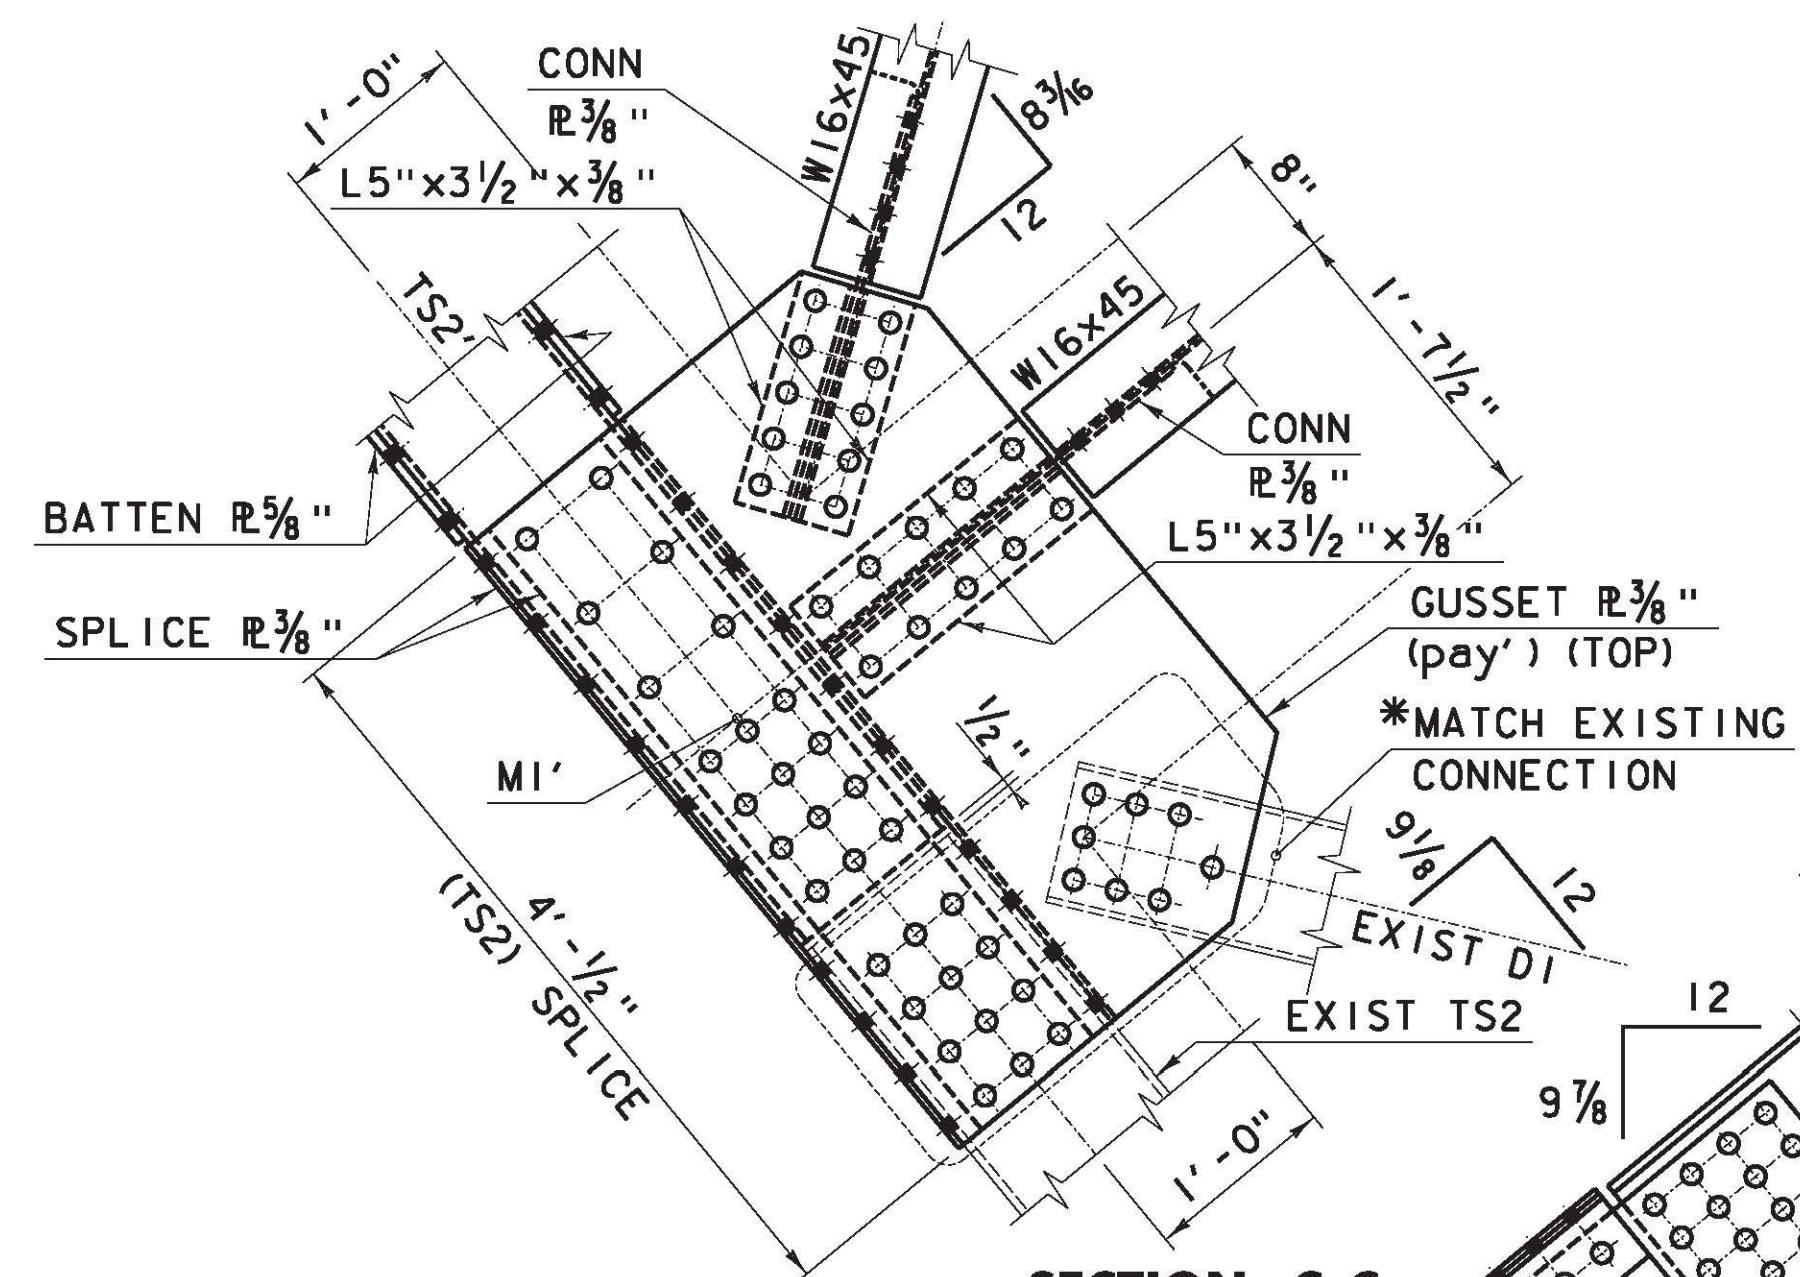

- NOTES:**
1. FOR FRAMING PLAN AND SECTIONS, SEE DWG NO ST1 & ST6.
 2. FOR ADDITIONAL INFORMATION, SEE SHEET E1,2,17a,17b,19 & 20. FROM THE 1929 FABRICATION DRAWINGS.
 3. MEMBER DESIGNATIONS TAKEN FROM 1929 FABRICATION DRAWINGS.
- * -SEE CONNECTION INSTALLATION METHODS, DWG S2.

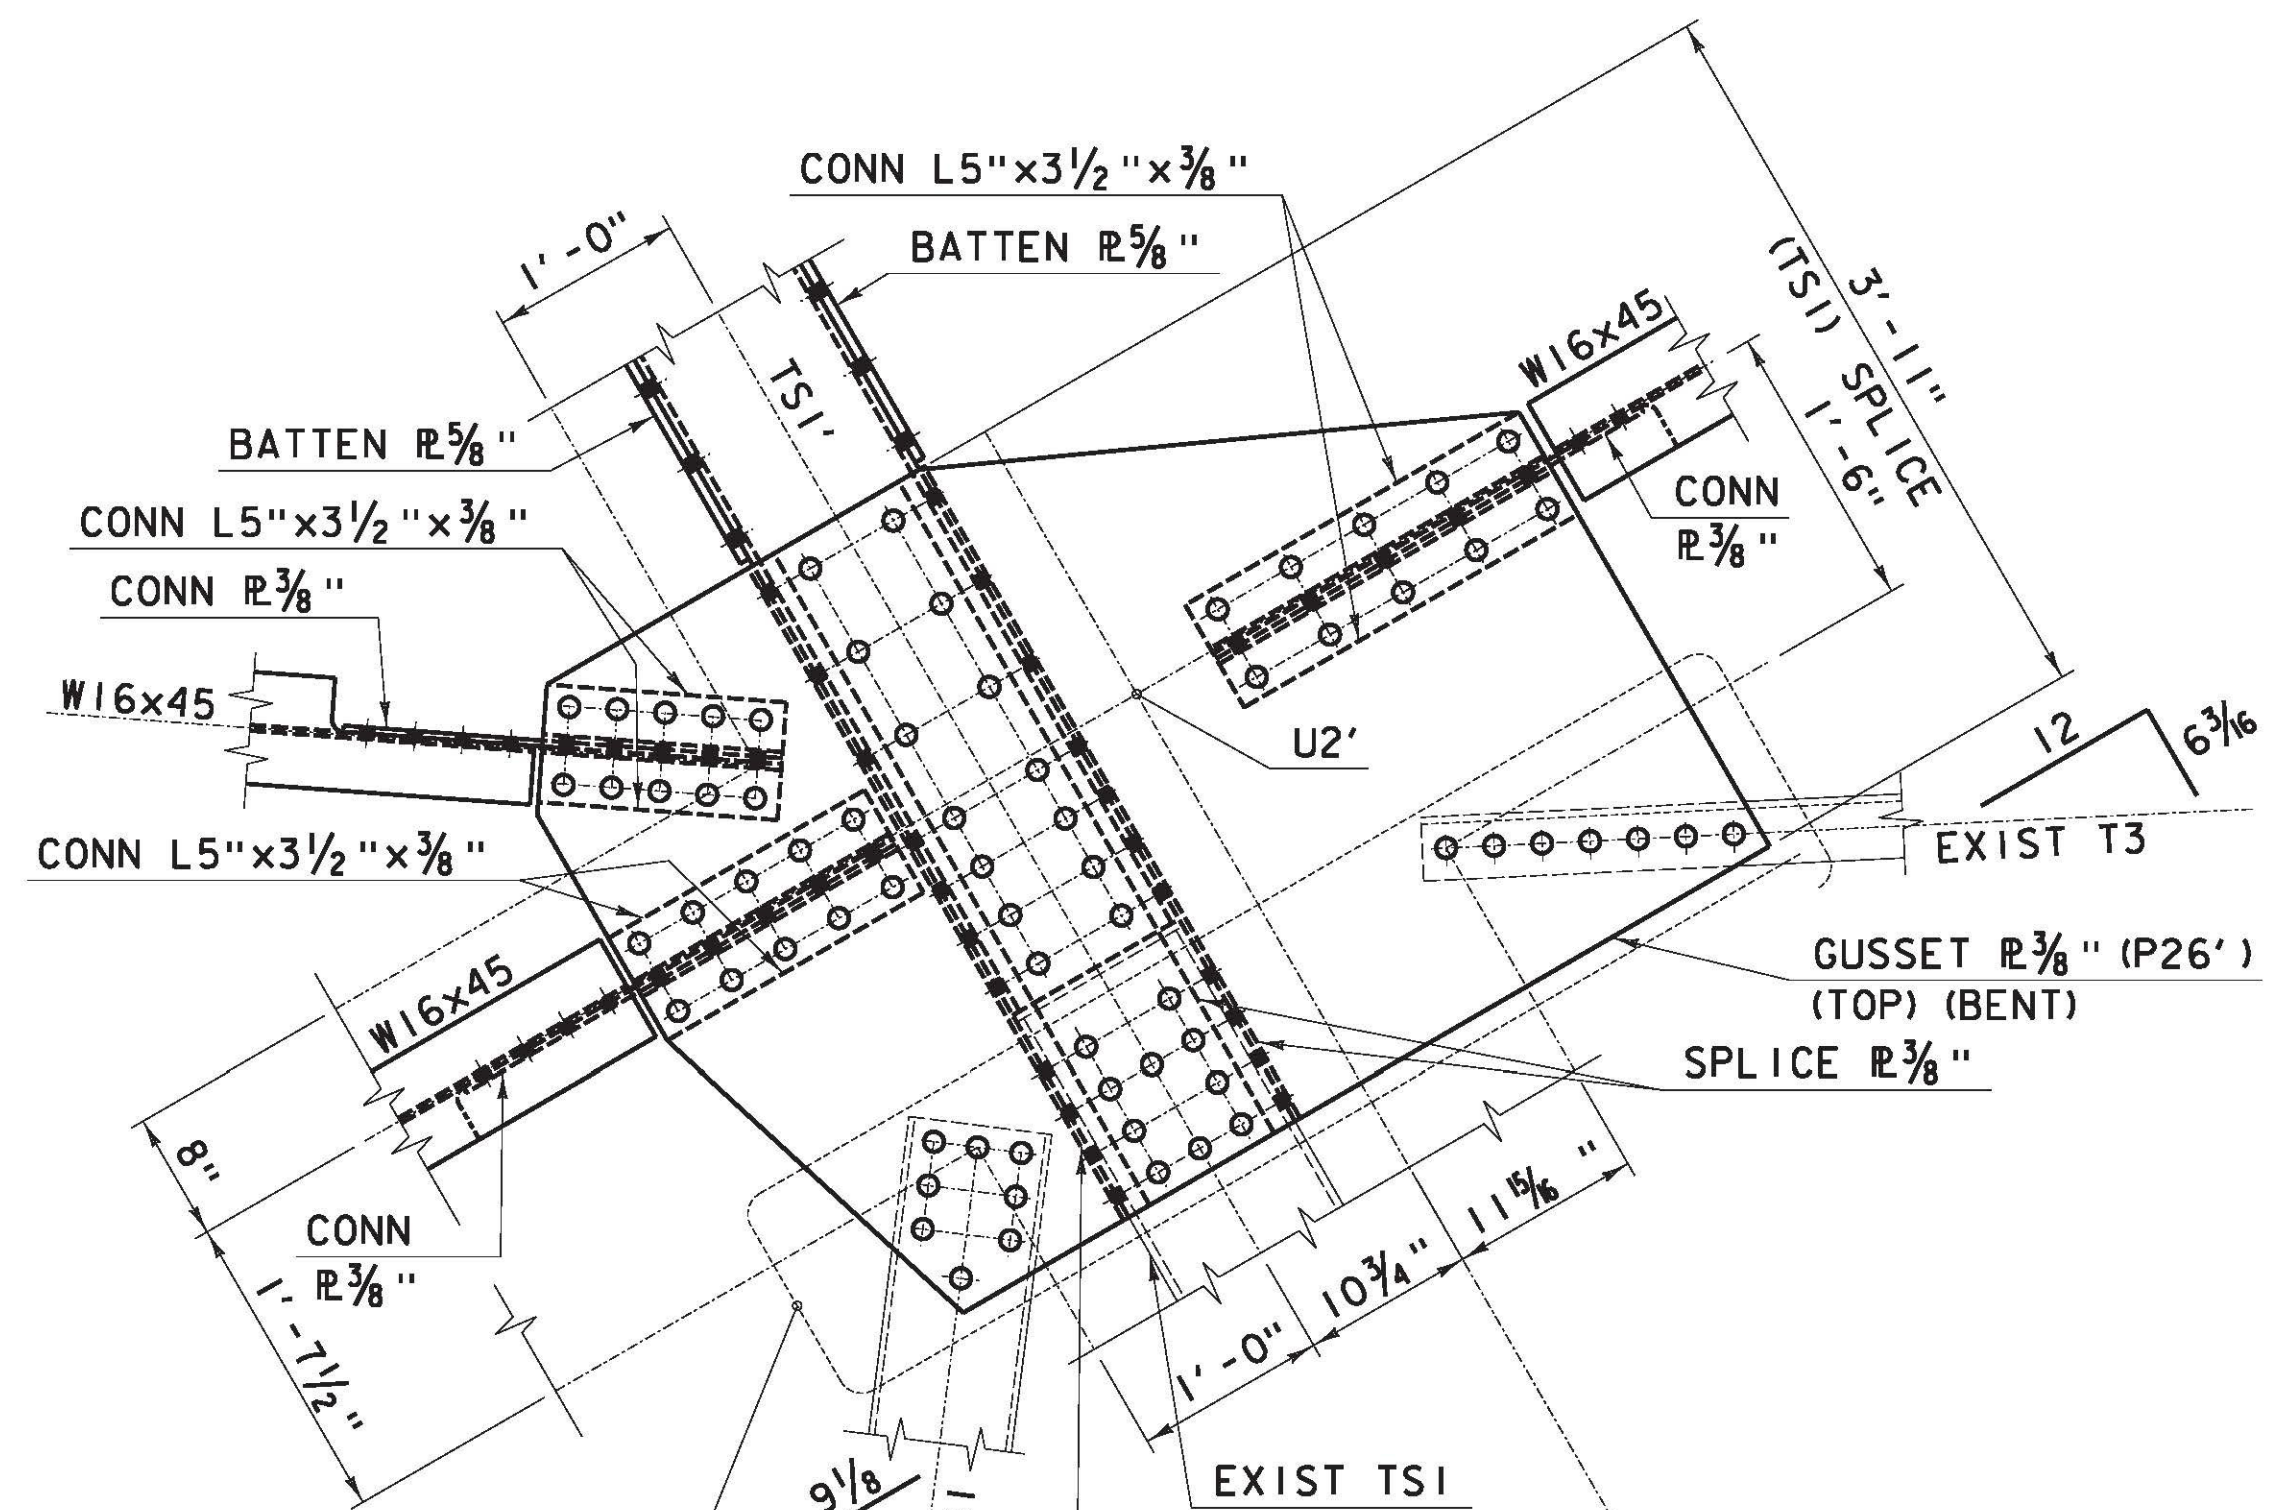

END PORTAL CONNECTION DETAILS	PROJECT NAME: RICHMOND	PLOT DATE: 3/14/2013
	PROJECT NUMBER: STP-RS 0284(III)	DRAWN BY: PKR
	FILE NAME: z90c092 por+ dt103A.dgn	CHECKED BY: VC/KM
	PROJECT LEADER: DJV DESIGNED BY: RH DWG. NO.: ST7	SHEET X OF X