



FILE NAME = V:\Projects\161\BRIDGE\WORK\161\BRIDGE DESIGN\161\BRIDGE\161.dwg
 DATE/TIME = 3/14/2013
 USER = JCF

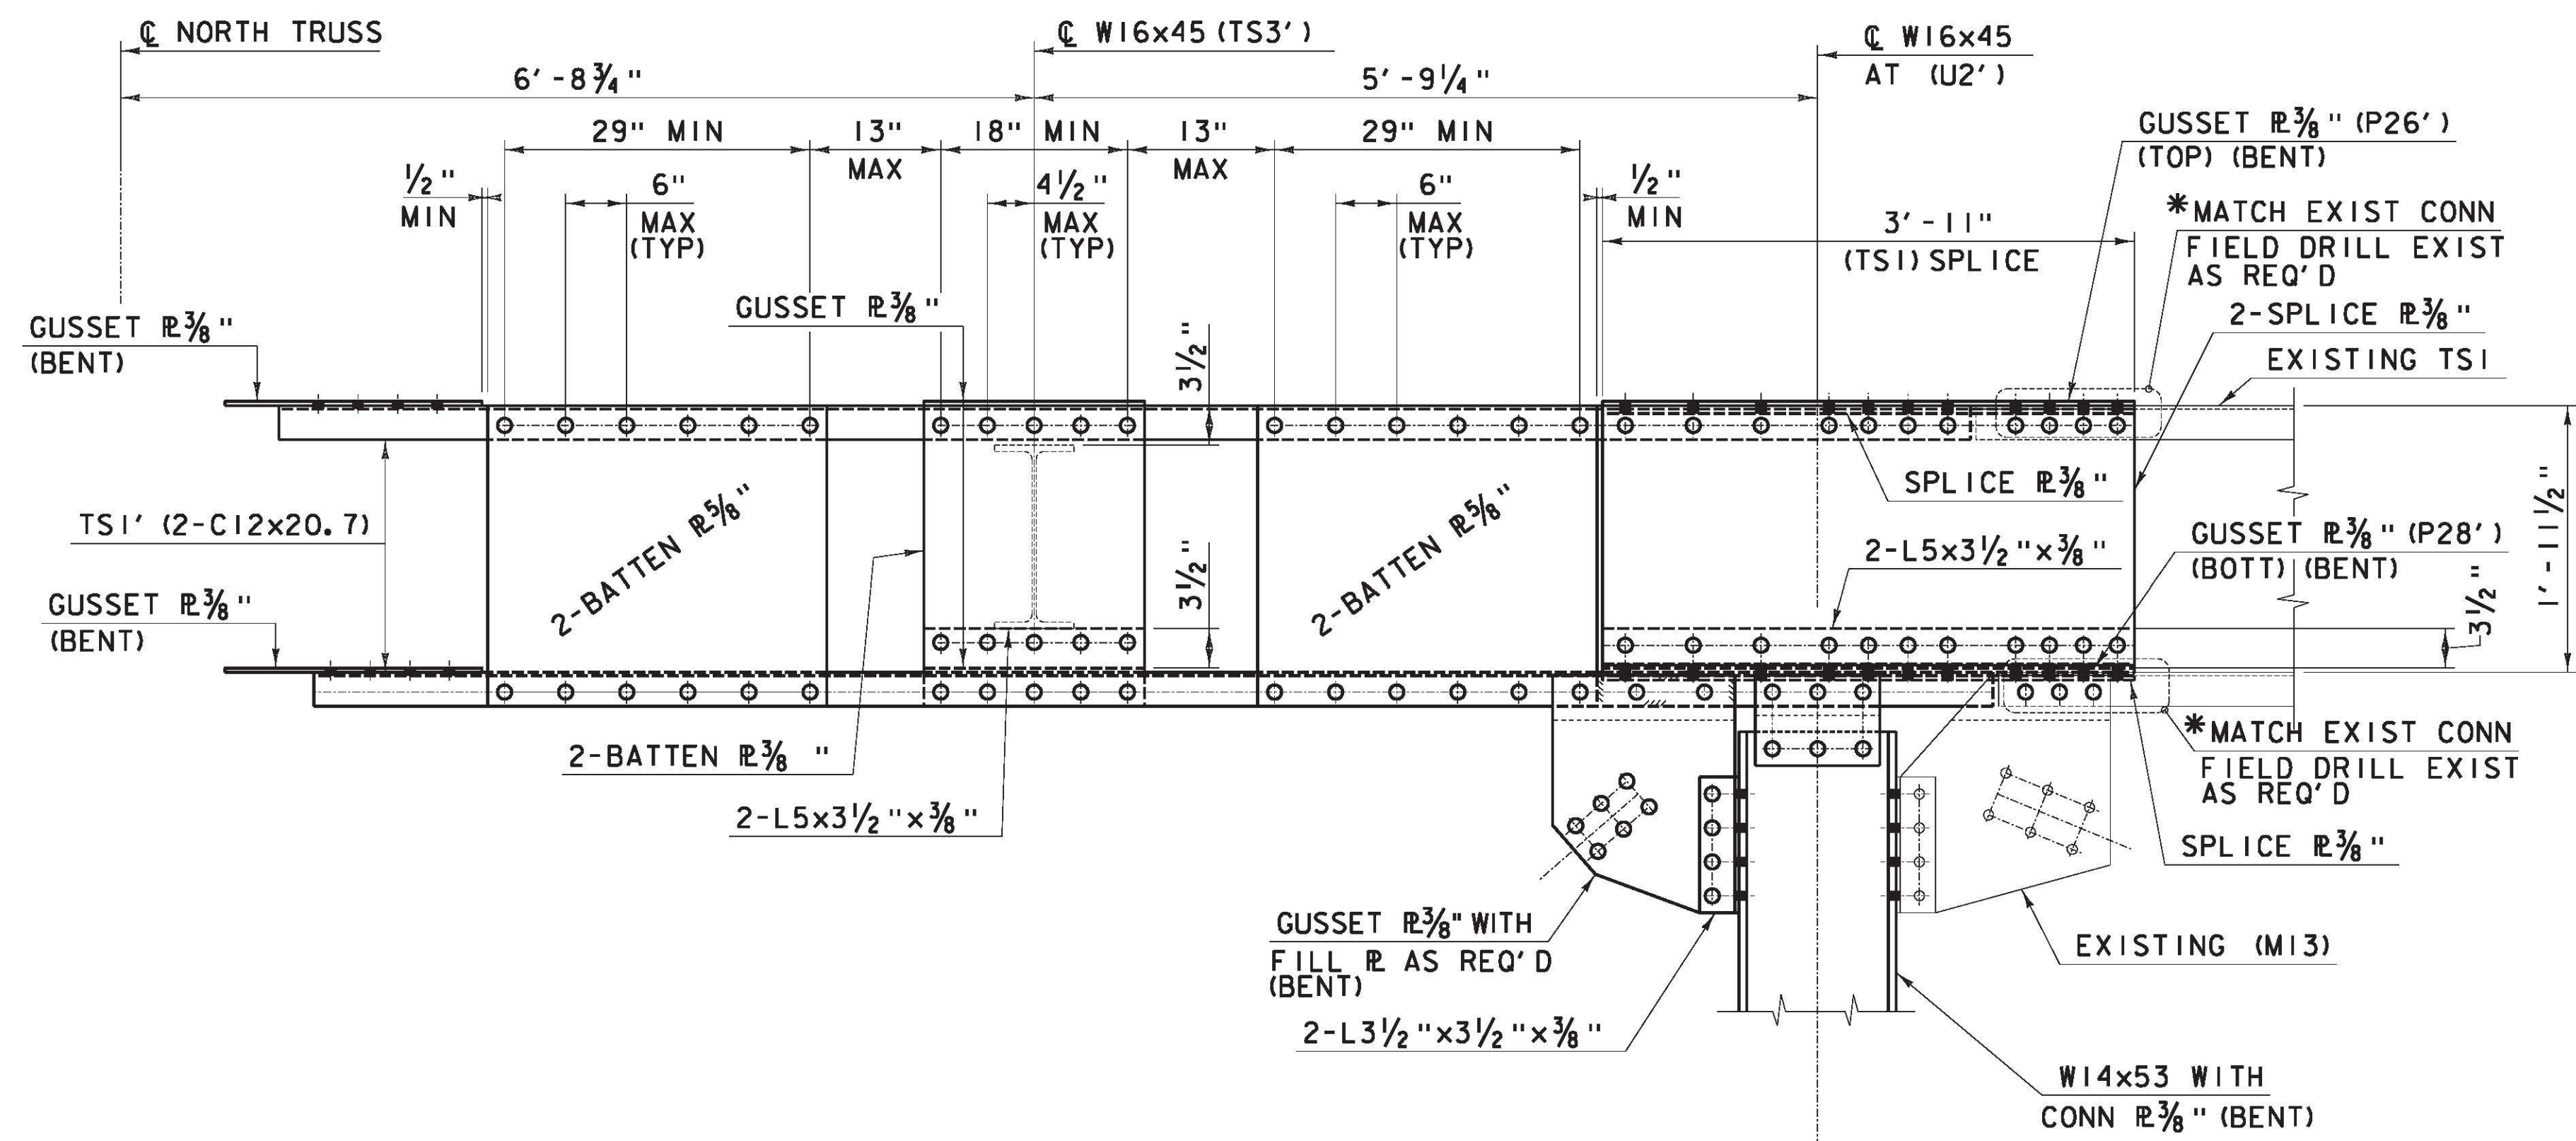

C CONNECTION DETAIL (TS1)

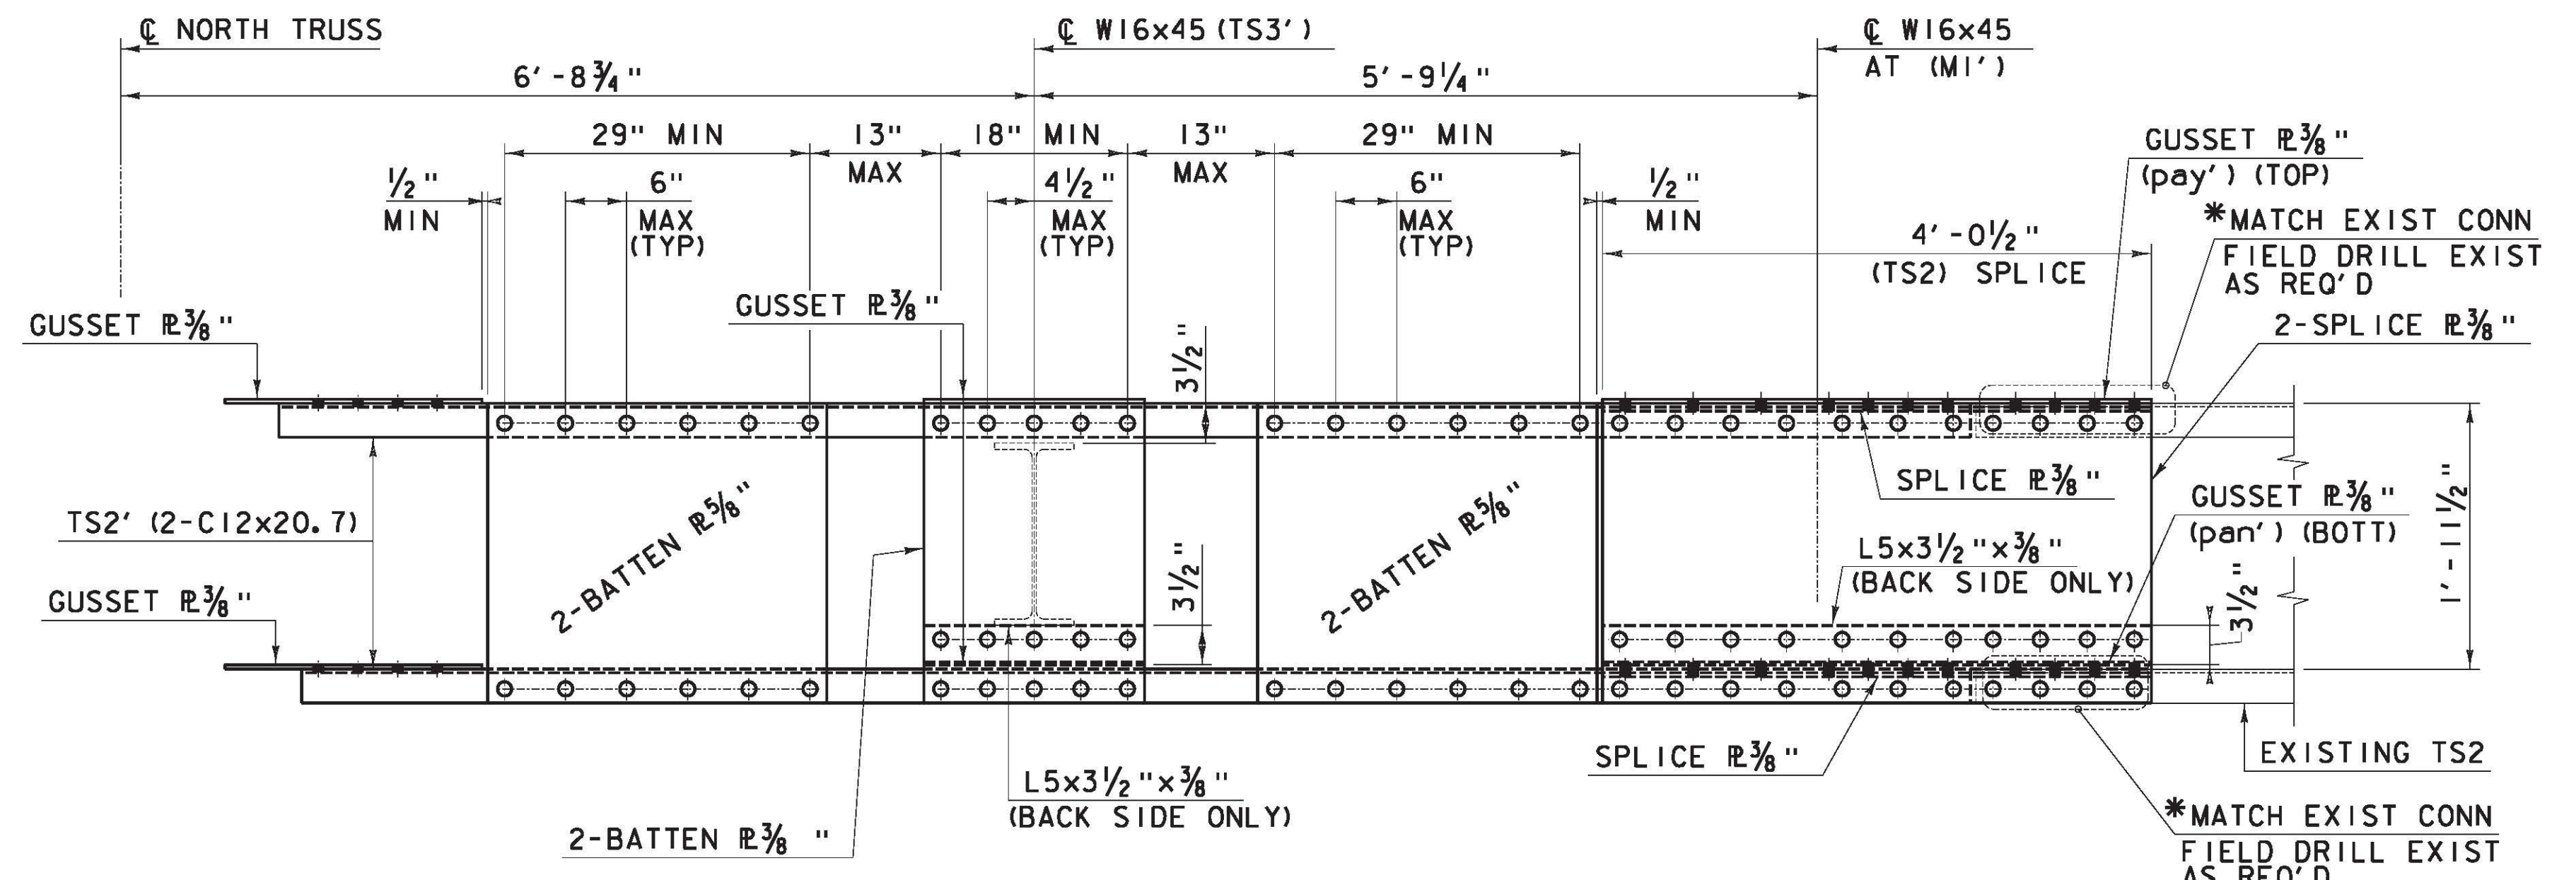

D CONNECTION DETAIL (TS2)

- NOTES:**
1. FOR FRAMING PLAN AND SECTIONS, SEE DWG NO ST1 & ST6.
 2. FOR ADDITIONAL INFORMATION, SEE SHEET E1,2,17a,17b,19 & 20. FROM THE 1929 FABRICATION DRAWINGS.
 3. MEMBER DESIGNATIONS TAKEN FROM 1929 FABRICATION DRAWINGS.
- * -SEE CONNECTION INSTALLATION METHODS, DWG S2.



END PORTAL TS1 AND TS2 DETAILS	PROJECT NAME: RICHMOND	PLOT DATE: 3/14/2013
	PROJECT NUMBER: STP-RS 0284(III)	DRAWN BY: PKR
	FILE NAME: z90c092 por+ dt103A.dgn	CHECKED BY: VC/KM
	PROJECT LEADER: DJV	SHEET X OF X
	DESIGNED BY: RH	
	DWG. NO.: ST8	