




FILE NAME = I:\Projects\161\161\BRIDGE\WORK\161\161\BRIDGE DESIGN\96c092_xsec_01.dgn
 DATE/TIME = 10/16/2012
 USER = 3293

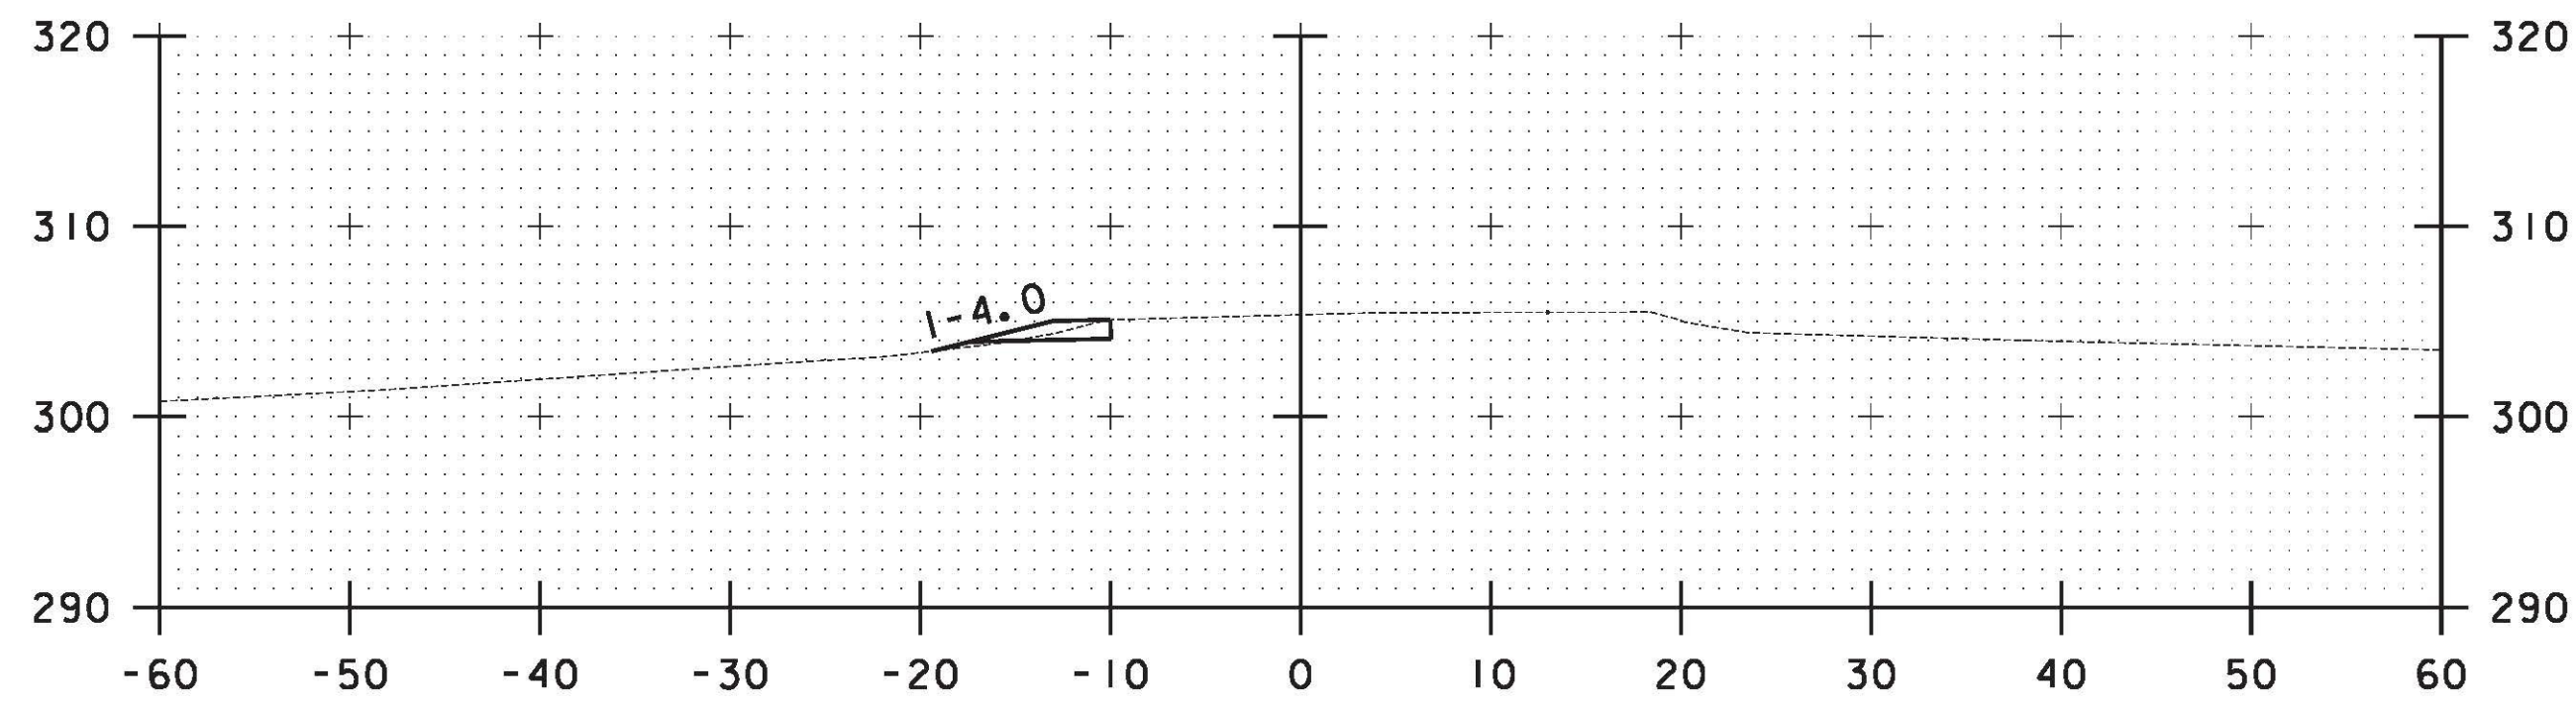


BD 50+50

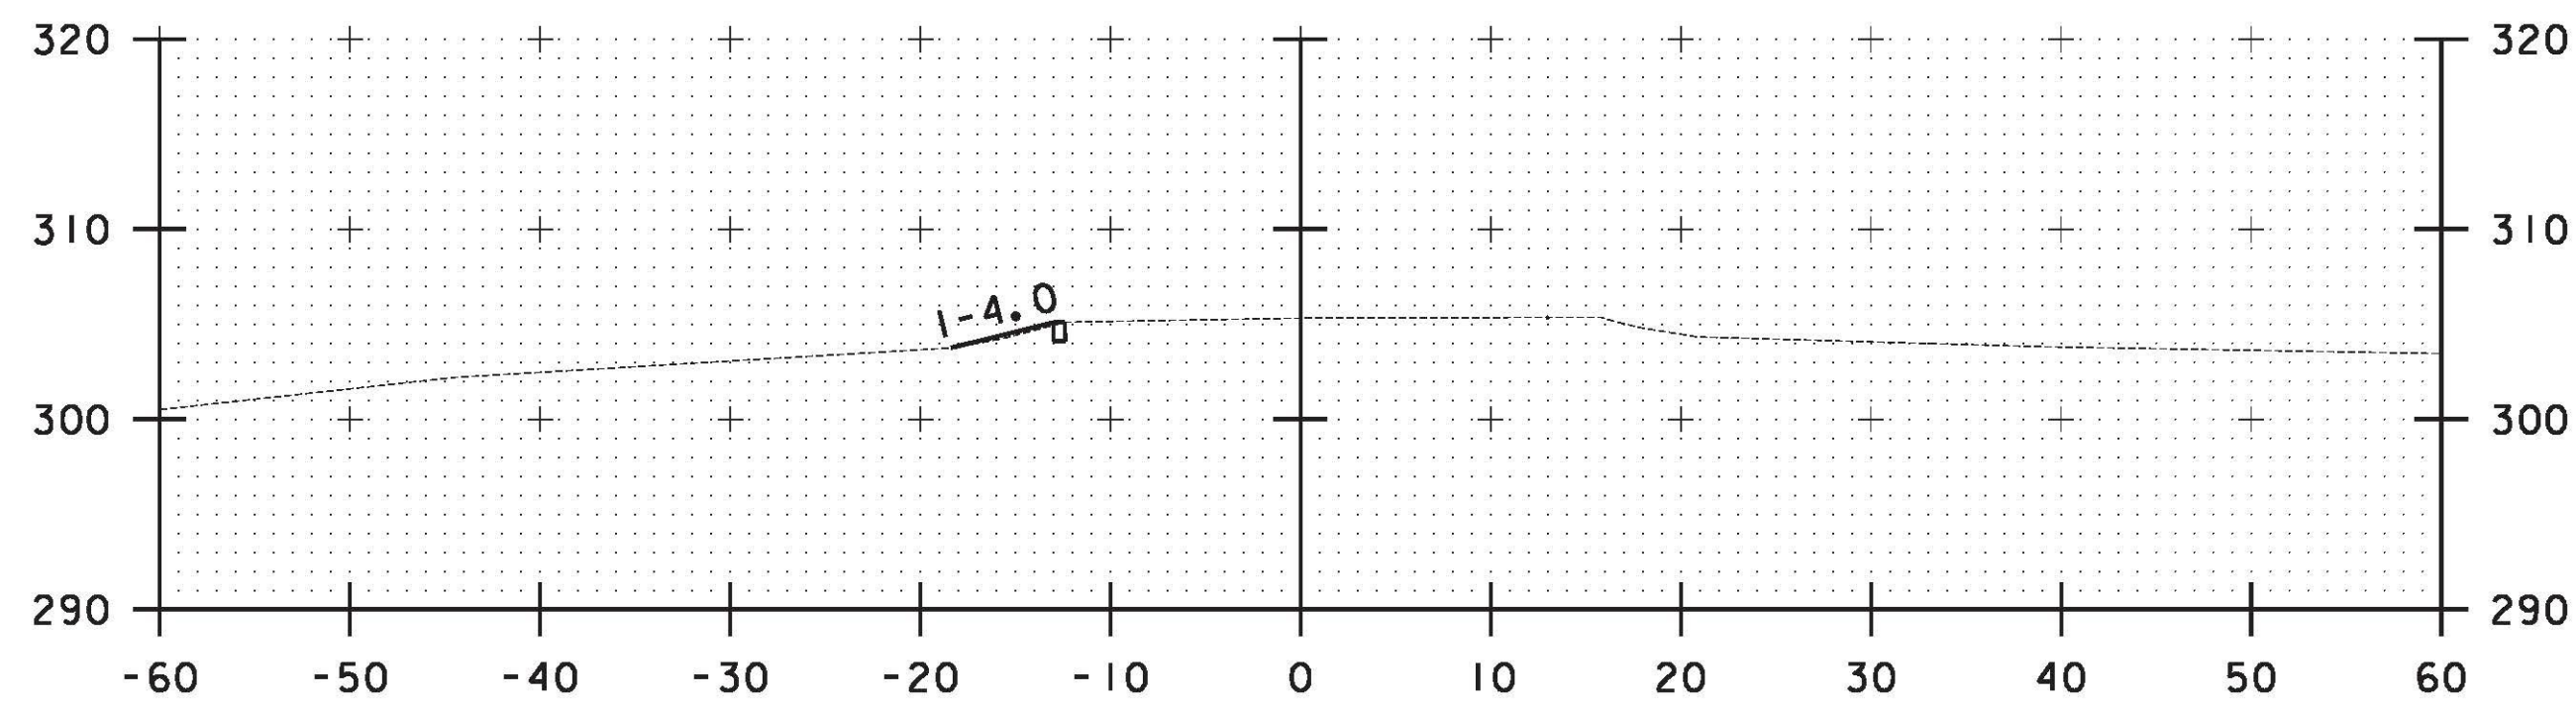


BD 50+25

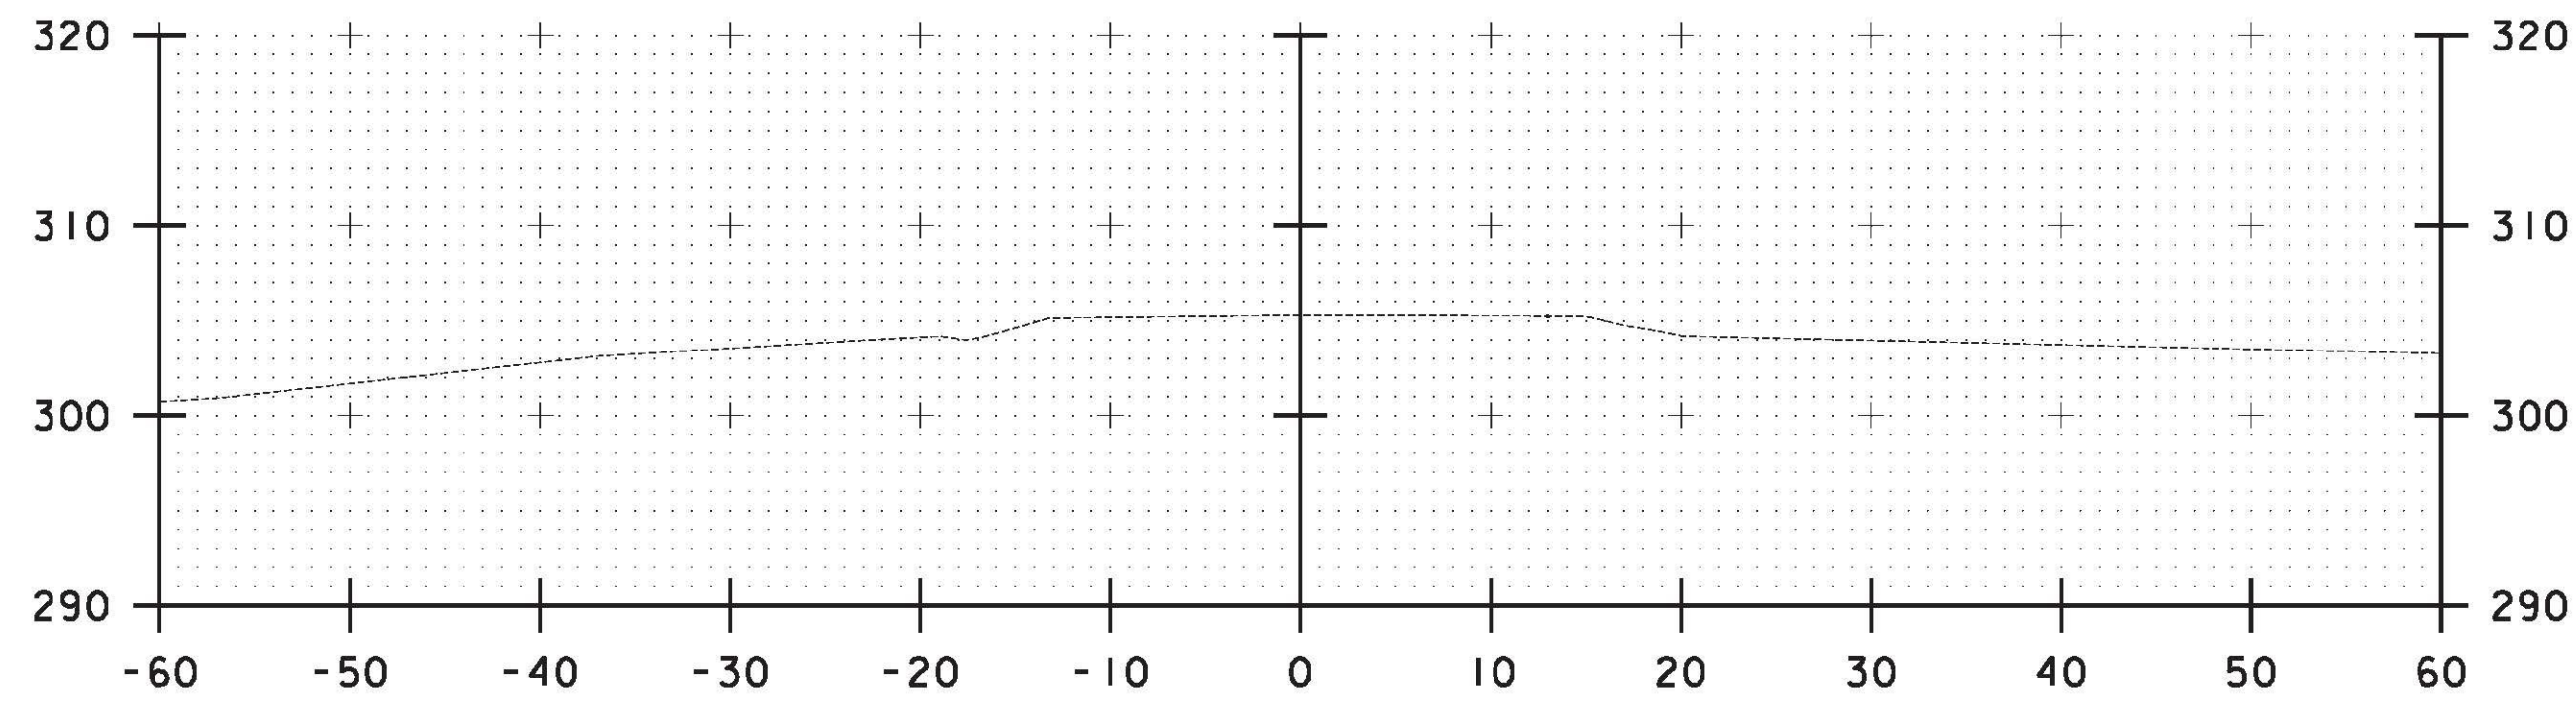


BD 50+00

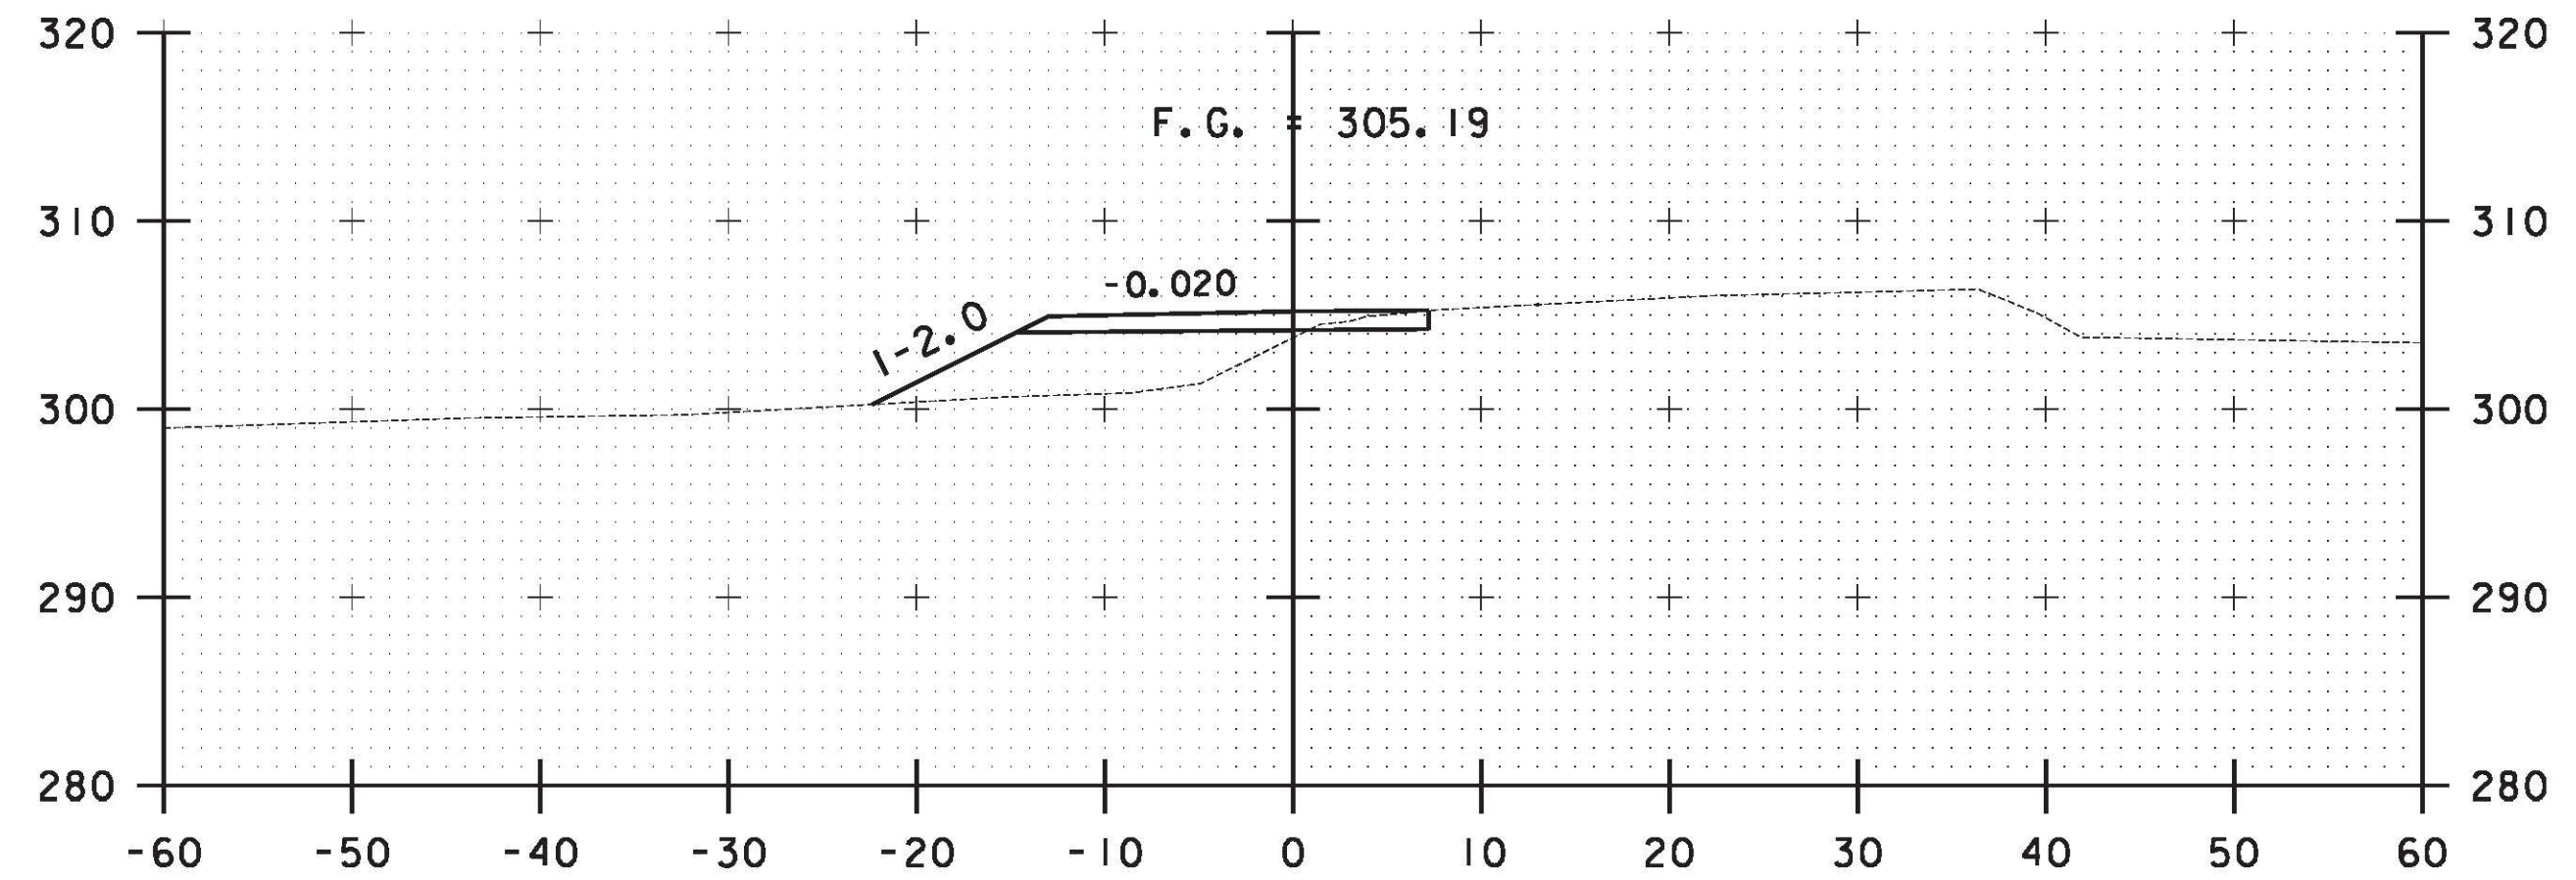


BD 51+25

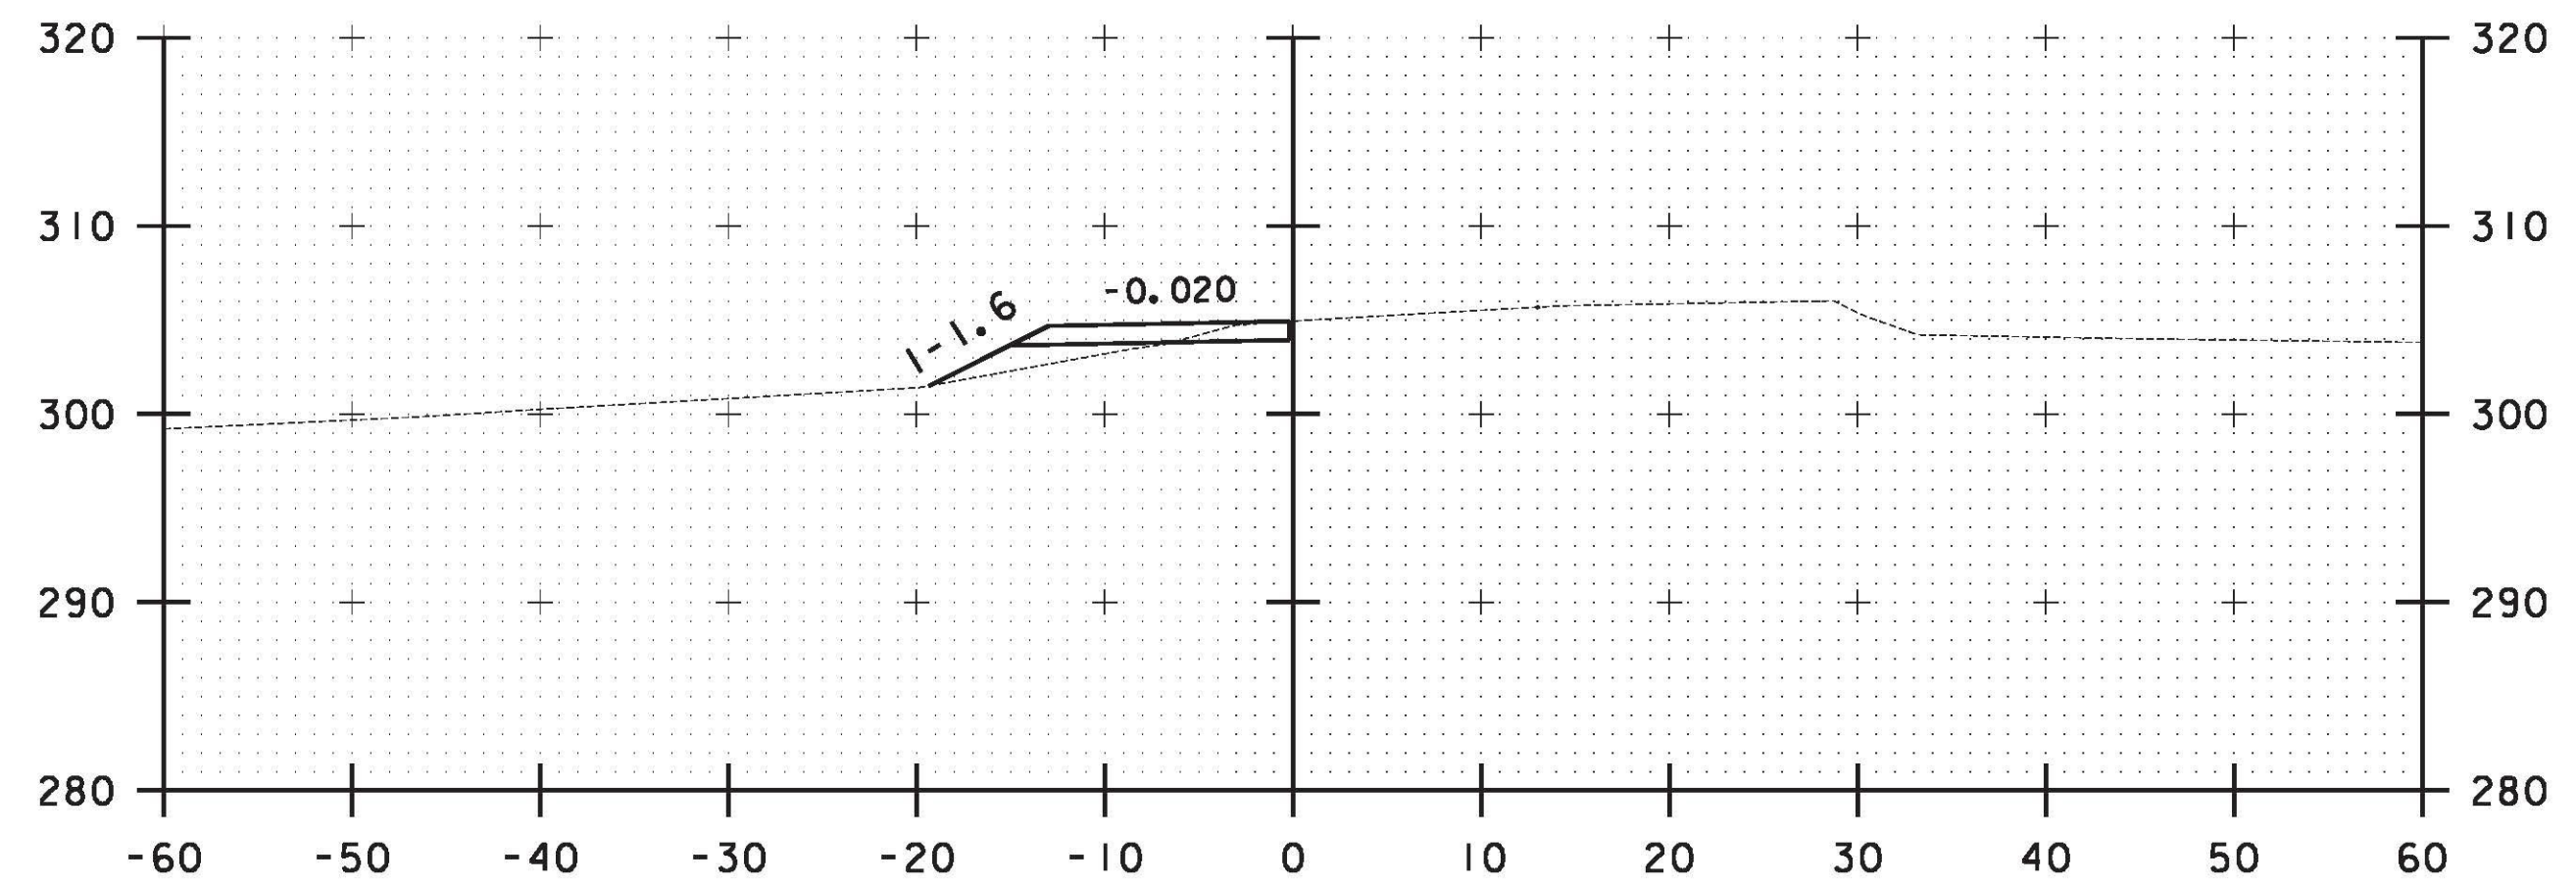

BD 51+00

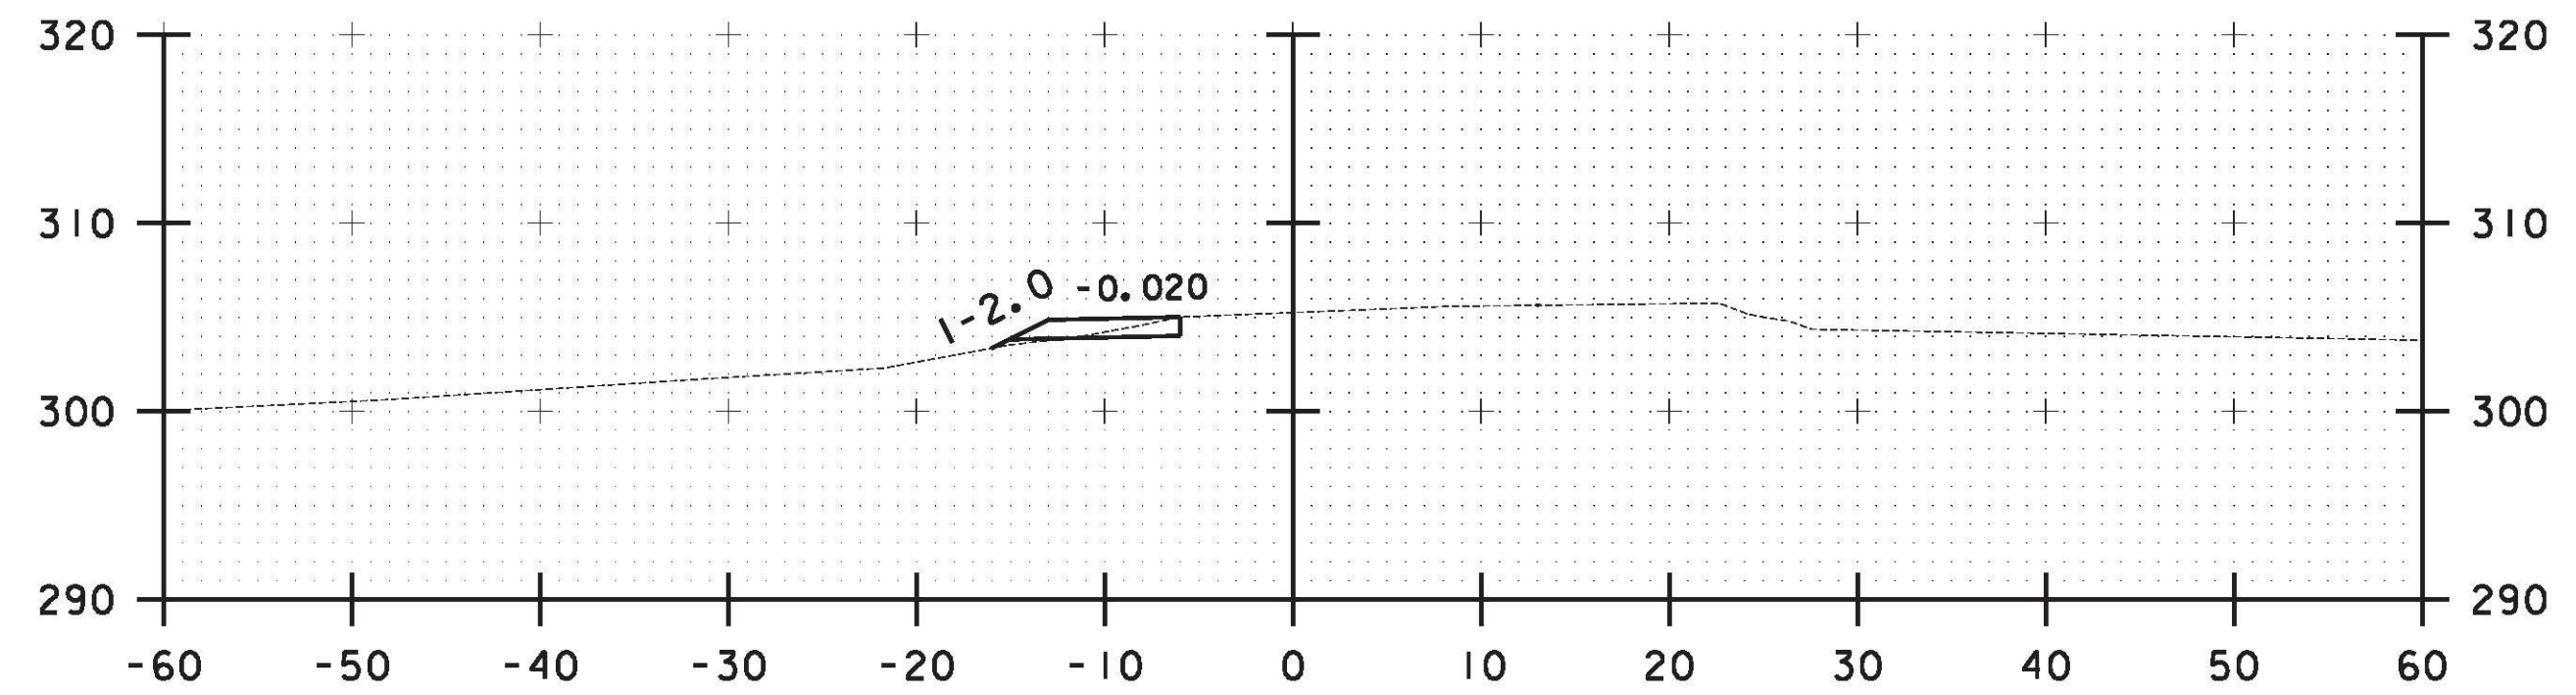

BD 50+75

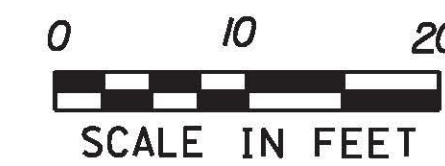

**TEMPORARY
 DETOUR
 CROSS
 SECTION
 SHEET #1**

PROJECT NAME: RICHMOND
 PROJECT NUMBER: STP-RS 0284(III)
 FILE NAME: z90c092_xsec_01.dgn
 PROJECT LEADER: D.E.G.
 DESIGNED BY: B.T.H.
 DWG. NO.: XC-1

PLOT DATE: 10/16/2012
 DRAWN BY: C.A.K.
 CHECKED BY: D.E.G.
 SHEET 9 OF 19